

GOVERNMENT CORNER RESTORATION FORM

FILED

TOWNSHIP 24S RANGE 06W SEC. 19 PLSS # 200340

Date: 2/27/2014 By: SC  
This survey consists of:

DOUGLAS COUNTY OREGON

DATE FEB. 20, 2014

Map: \_\_\_\_\_

Narrative: \_\_\_\_\_  
Corner Rpt: CS67/41-15

Corner Designation

DOUGLAS COUNTY  
SURVEYOR

$\frac{1}{4}$   
519 + 520

- \_\_\_ Condition Report
- \_\_\_ Not Found
- Renewed
- \_\_\_ Unrecorded
- \_\_\_ Surveyed In
- \_\_\_ Referenced Out

Previous Renewals 1959, 1962  
Monument(s) Found: \_\_\_\_\_ (Condition and Source)

MONUMENT DETAIL

NO MONUMENT FOUND. POSITION FALLS AT  
EDGE OF ROAD DRAINAGE DITCH. BC/IP POSSIBLY  
LOST DUE TO ROAD WORK.

N/A

Accessories Found

THE TWO ORIGINAL BEARING TREES:

A CEDAR, 19" DIA. NOW A 43 INCH DIAMETER SPLIT OPEN AND ROTTED APPROX. 18 FOOT TALL  
RED CEDAR SNAG, NO LONGER HAVING EVIDENCE OF A BLAZE OR SCRIBING; BEARS  
S53°E, 52<sup>±</sup> FEET DISTANT (AS PER RECORD).

AY. FIR, 34" DIA. NOW A ROUGHLY 36 INCH DIAM. 3 FOOT TALL ROTTED AND BROKEN FIR STUMP  
WITH NO REMAINING FACE OR SCRIBING; BEARS N84<sup>1</sup>/<sub>2</sub>°W, 37<sup>±</sup> FEET DISTANT (RECORD  
N84<sup>1</sup>/<sub>2</sub>°W, 38<sup>±</sup> FEET IS A REASONABLE SLOPE DISTANCE).

THE 1959 RENEWAL BEARING TREE:

A 48" R. FIR NOW A ROTTED 38 INCH DIAM. 9 FOOT TALL FIR STUMP WITH ALL THE BLAZE  
EVIDENCE ROTTED AWAY; BEARS N71<sup>1</sup>/<sub>2</sub>°E, 44<sup>±</sup> FEET DISTANT (AS PER THE 1959 RECORD).

THE TWO 1962 RENEWAL BEARING TREES:

A CEDAR 30" DIA., NOW A 46 INCH DIAM. RED CEDAR WITH A FULLY HEALED SINGLE BLAZE; BEARS  
N55<sup>1</sup>/<sub>2</sub>°E, 74<sup>±</sup> FEET DISTANT (AS PER RECORD).

A HEMLOCK (MISIDENTIFIED) 29" DIA. NOW A 36 INCH DIAM. GRAND FIR WITH A COMPLETELY  
ROTTED OUT SINGLE BLAZE; BEARS N42°W, 116<sup>±</sup> FEET DISTANT (AS PER RECORD).

AT THE POSITION AS DETERMINED BY THE FOUND B.T.S IS SET A 2 3/8 INCH DIAM. BRASS CAP (MARKED AS AT RIGHT) ON A 1 INCH I.D. X 32 INCH LONG IRON PIPE. THE MONUMENTS TOP IS APPROX. FLUSH WITH THE GROUND.

DOUGLAS COUNTY SURVEYOR

T245 R6W

S19 | S20

1/4

2014

New Accessories


A STEEL POST WITH A WHITE PAINTED ALUMINUM WITNESS SIGN SET PROTRUDING APPROX. 3 FEET ABOVE GROUND; BEARS EAST 05 FEET DISTANT.

A 19 INCH DIAM. DOUGLAS FIR SCRIBED "1/4 S19CS" "BT" ON A DOUBLE BLAZE; BEARS S 81° W, 36 2 FEET DISTANT.

A 9 1/2 FOOT X 14 1/2 FOOT CONCRETE FOUNDATION OF A STEEL CATTLE GUARD: THE NORTH-EAST CORNER OF WHICH BEARS N 11 3/4° E, 17 2 FEET DISTANT; AND THE SOUTHEAST CORNER OF WHICH BEARS N 31 3/4° W, 4 3 FEET DISTANT.

Sketch of Monument, Accessories, and General Area

Location & Comments

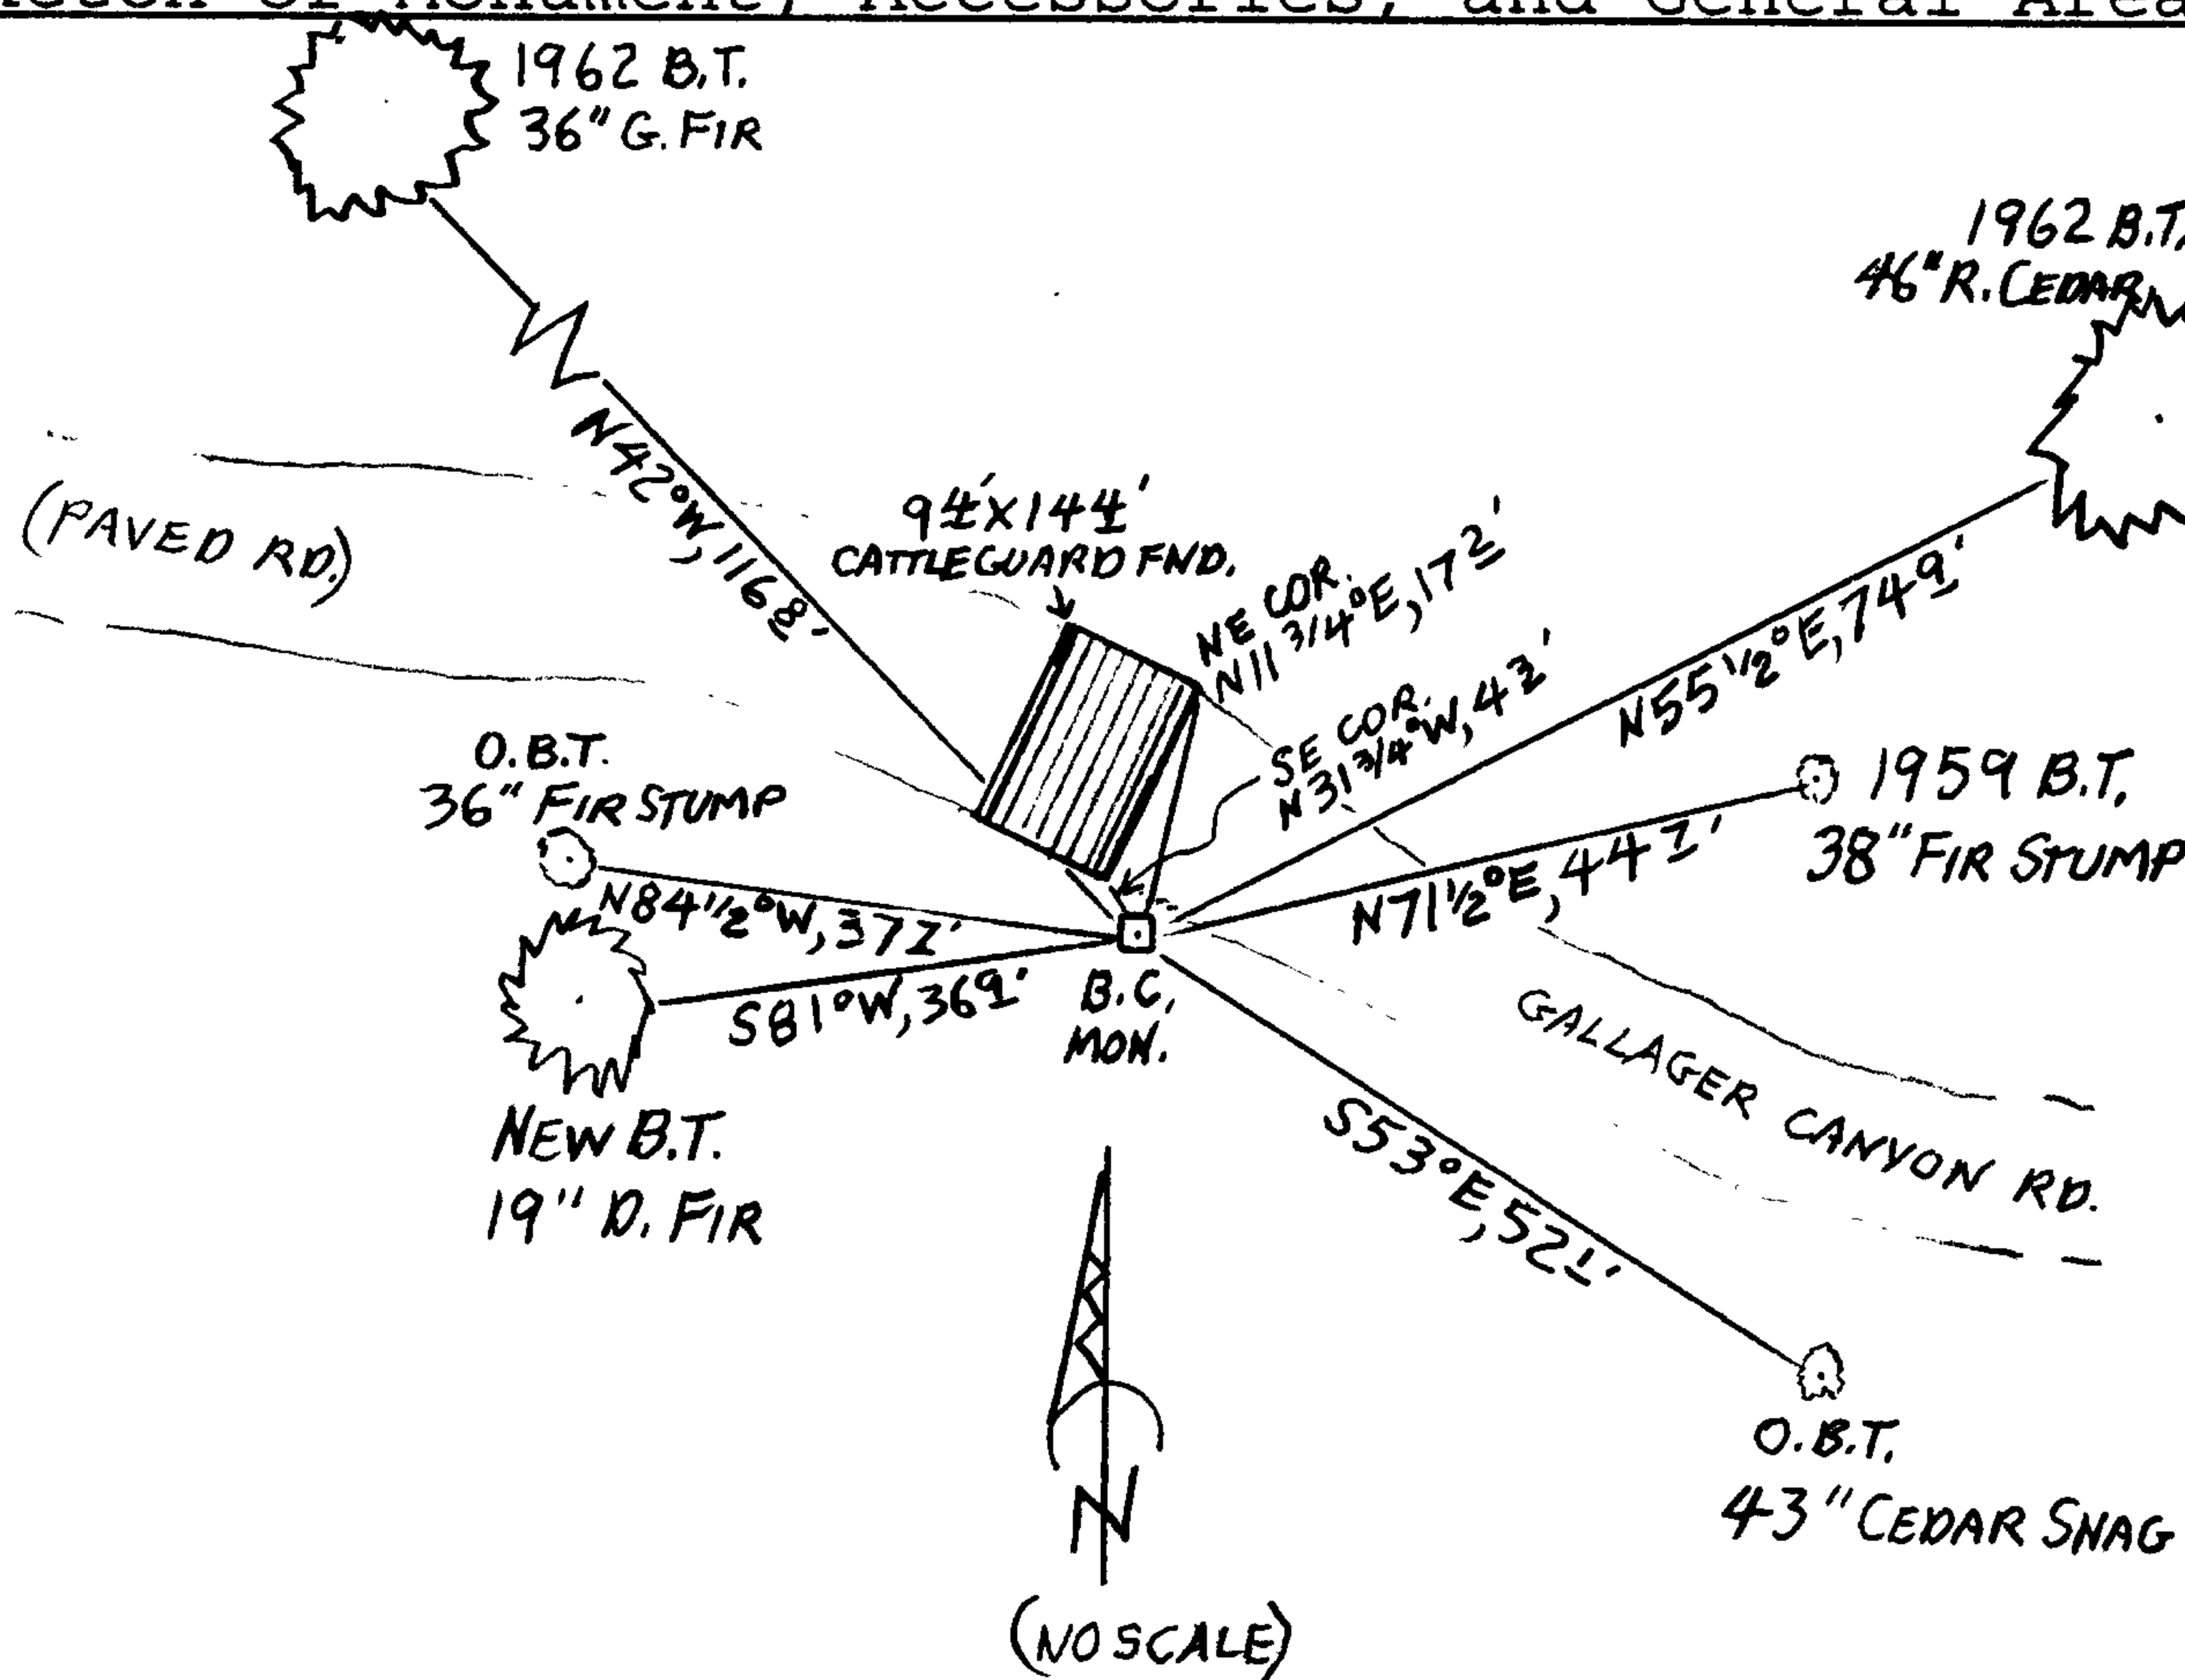

MONUMENT IS 8 1/2 FT. STHLY FROM CENTERLINE OF GALLAGER CANYON RD. ON MODERATE NORTH SLOPE IN AN OLDER MIXED REPROD FOREST WITH FIR, CEDAR, MAPLE AND ALDER.

Comp. Decline. 15 1/4° E  
 Agency DCSO  
 Party Chief STEPHEN JOHN FLAUSE  
 Note keeper Stephen John Flause  
 Witnesses MIKE S. KOCH

Surveyor's Seal

REGISTERED PROFESSIONAL LAND SURVEYOR

*Handwritten signature*

OREGON  
 JULY 25, 1990  
 RANDALL W. SMITH  
 2488

*Handwritten number* 6-30-2014