

GOVERNMENT CORNER RESTORATION FORM

FILED

TOWNSHIP 24S RANGE 06W SEC. 20 PLSS # 300340

Date: 3-7-2014 By: Jc

This survey consists of:

DOUGLAS COUNTY OREGON

DATE FEB. 25, 2014


Map: _____

Narrative: _____

Corner Rpt: CS 67/41-18

Corner Designation

DOUGLAS COUNTY SURVEYOR

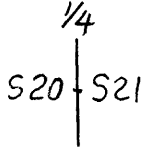


Previous Renewals 1959 AND AN UNRECORDED RENEWAL
Monument(s) Found: (Condition and Source)

- Condition Report
- Not Found
- Renewed
- Unrecorded
- Surveyed In
- Referenced Out

THE 1959 MONUMENT, A 2 1/2 INCH DIAMETER BRASS CAP (MARKED AS AT RIGHT) ON A 1 INCH I.D. IRON PIPE SET PROTRUDING 10 INCHES ABOVE GROUND.

MONUMENT DETAIL

COUNTY SURVEYORS OFFICE

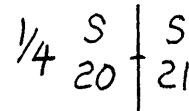

T24S R6W
1959

Accessories Found

EVIDENCE OF ONE ORIGINAL B.T.:
A 12" OAK NOW AN INDISTINCT ROOT-HOLE CONTAINING ROTTEN OAK ROOTS BEARS N17°W, 53± FEET DISTANT (AS PER RECORD).
NO GOOD EVIDENCE OF NE O.B.T. REMAINS.

TWO 1959 RENEWAL BEARING TREES:
A 10" W. OAK NOW A 15 INCH DIAM. WHITE OAK WITH A FULLY HEALED DOUBLE BLAZE; BEARS N21 1/2°E, 8± FEET DISTANT (RECORD N26°E (BEARING TO UPPER BLAZE CENTER), 8± FEET).
A 10" W. OAK NOW AN 11 INCH DIAM. WHITE OAK WITH A FULLY HEALED DOUBLE BLAZE; BEARS S48°W, 5± FEET DISTANT (AS PER RECORD).

TWO UNRECORDED BEARING TREES (PROBABLY MARKED 10-15 YEARS AGO).
A 12 INCH DIAM. DOUGLAS FIR WITH A FULLY HEALED SINGLE BLAZE AND OLD FLAGGING TIED TO TRUNK; BEARS S1 1/2°E, 25± FEET DISTANT.
A 13 INCH DIAM. WHITE OAK WITH A FULLY HEALED SINGLE BLAZE (OPENED TO FIND SCRIBING "BT"); BEARS N49 1/2°W, 39± FEET DISTANT.

Monument Set (Procedure and Description)

MONUMENT DETAIL

N/A


N/A

New Accessories

N/A

Sketch of Monument, Accessories, and General Area

Location & Comments

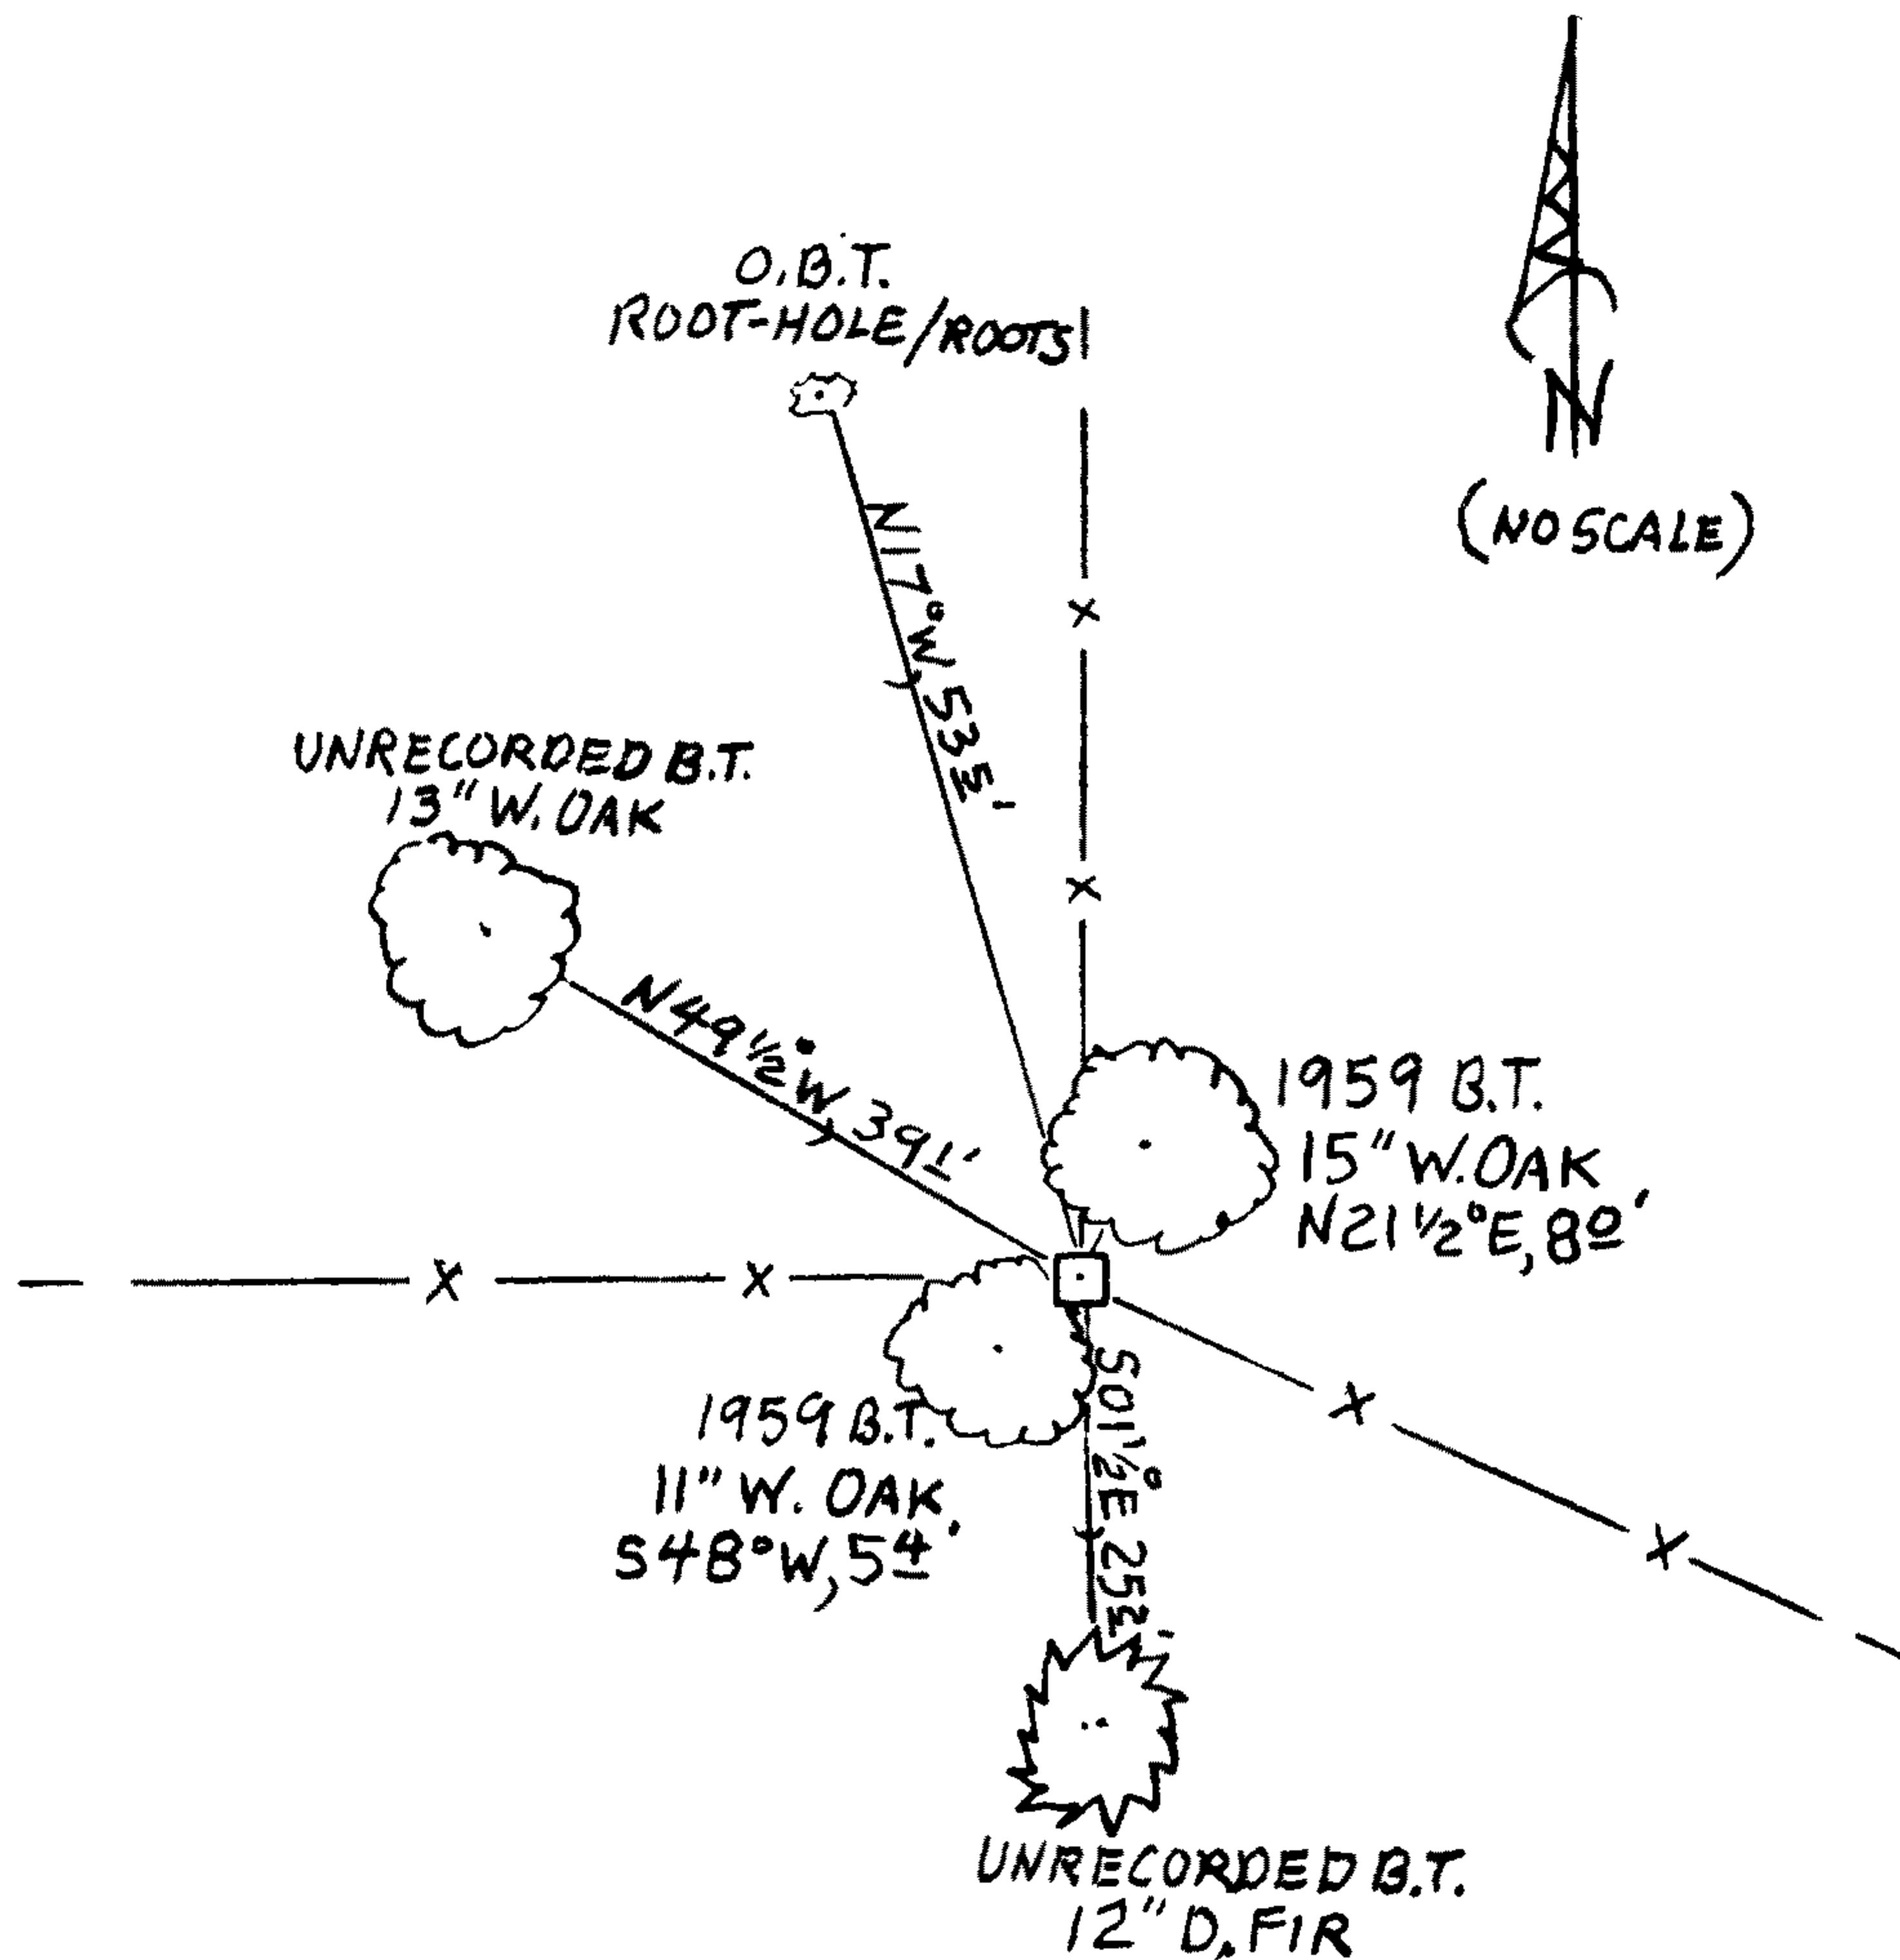


FENCE COR AS PREVIOUSLY DESCRIBED
ALSO HAS FENCE RUNNING S50°W.


MONUMENT IS ON MODERATELY
STEEP EAST SLOPE IN OPEN WOOD-
LAND WITH FIR, OAK AND SOME MADRONE.

Comp. Decline. 15 1/2° E
Agency DC50
Party Chief STEPHEN JOHN FLAUSE
Note keeper Stephen John Flause
Witnesses MIKE S. KOCH

Surveyor's Seal

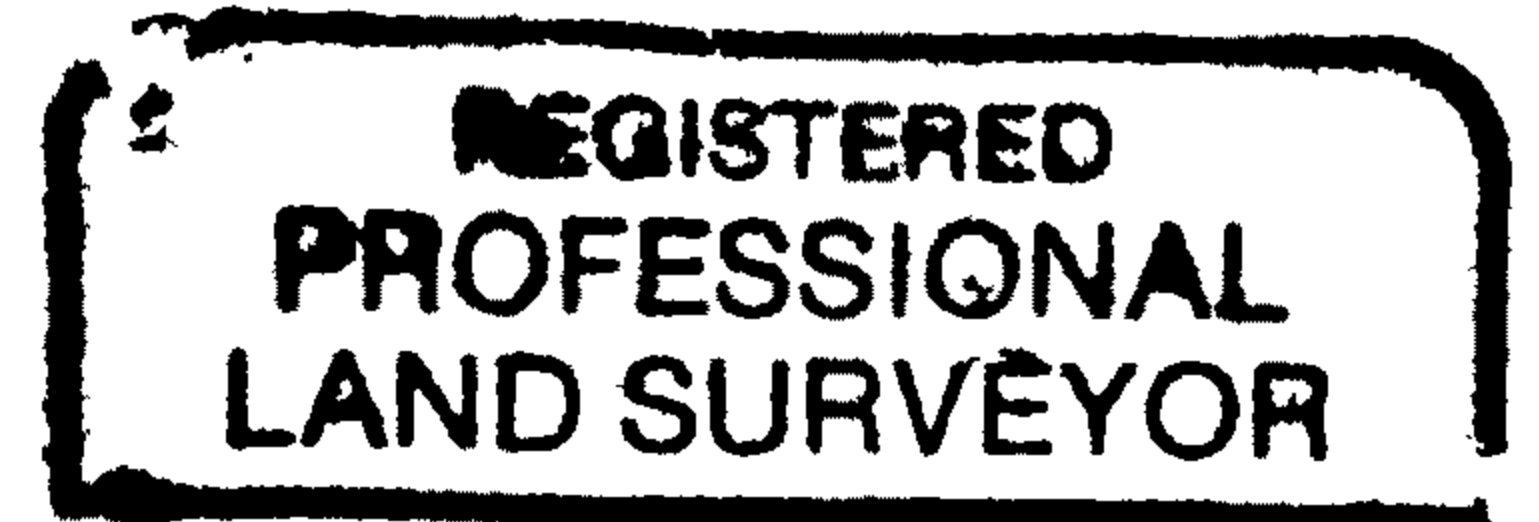

Randall W. Smith

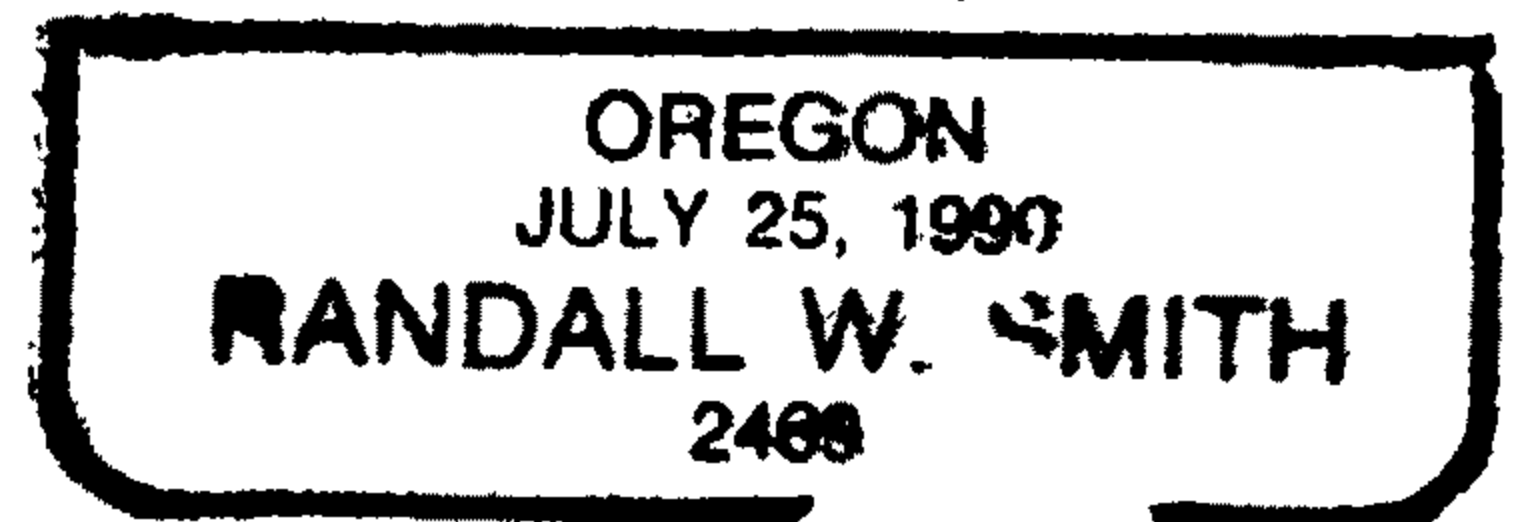

6-30-2014