



Monument Set (Procedure and Description)

MONUMENT DETAIL

N/A

N/A

New Accessories


N/A

Sketch of Monument, Accessories, and General Area


Location & Comments

Comp. Decline. 15 1/4° E  
Agency D.C.S.O.  
Party Chief STEPHEN JOHN FLAUSE  
Note keeper Stephen John Flause  
Witnesses \_\_\_\_\_

Surveyor's Seal

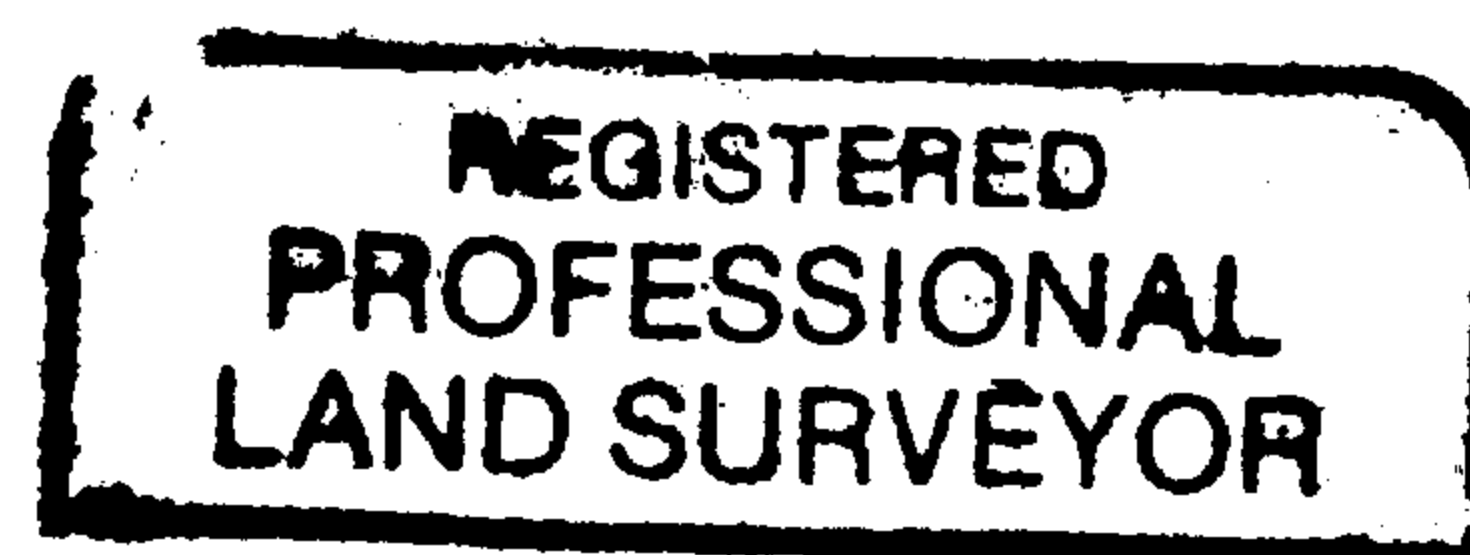

*Handwritten signature*

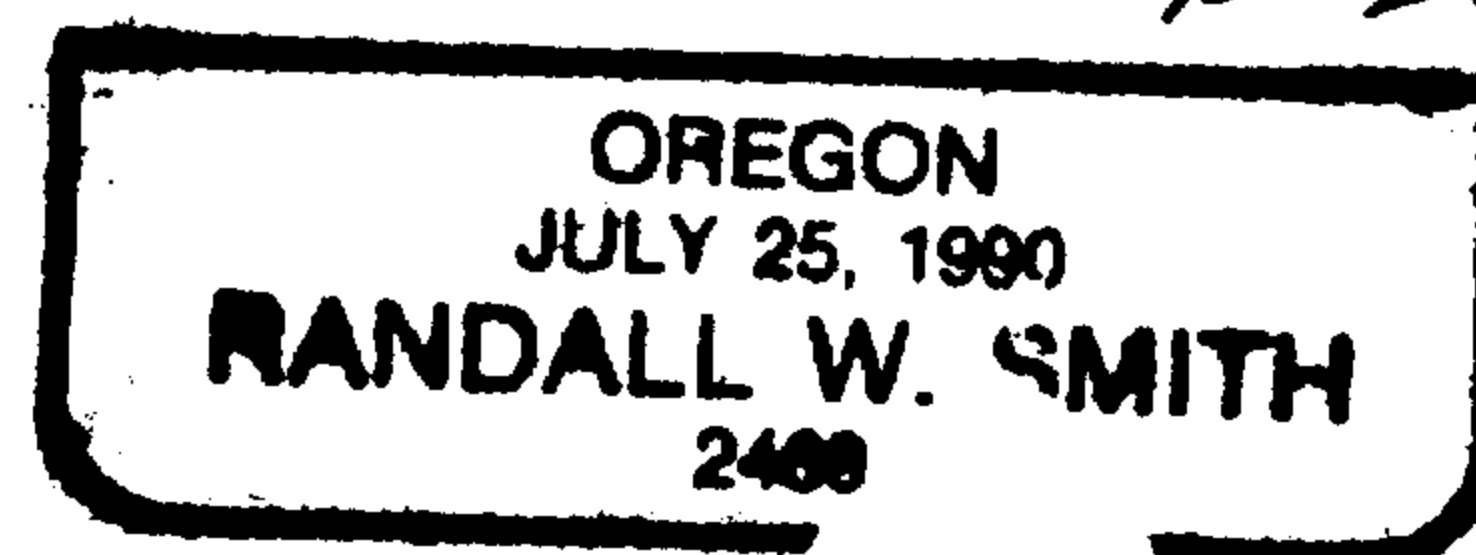

*Handwritten signature*