

GOVERNMENT CORNER RESTORATION FORM

FILED

TOWNSHIP 23 S RANGE 07 W SEC. 35 PLSS # 600100

Date: 8/4/2014 By: X  
This survey consists of:

DOUGLAS COUNTY OREGON

DATE JULY 18, 2014

Map: \_\_\_\_\_

Corner Designation

Narrative: \_\_\_\_\_

Corner Rpt: CS 67/41-30

DOUGLAS COUNTY  
SURVEYOR

S35 | S36  
---  
S01

CORRECTED 1958

Previous Renewals 1949, 1955, 1957 RESURVEY, 1992-93 RESURVEY  
Monument(s) Found: (Condition and Source)

- \_\_\_ Condition Report
- \_\_\_ Not Found
- Renewed
- \_\_\_ Unrecorded
- \_\_\_ Surveyed In
- \_\_\_ Referenced Out

MONUMENT DETAIL

FROM THE 1957 BLM RESURVEY:  
A 3 1/4 INCH DIAMETER BRASS CAP (MARKED AS AT RIGHT) ON A 2 INCH I.D. IRON PIPE IS SET PLUMB PROTRUDING 10 INCHES ABOVE GROUND

U.S. CADASTRAL SURVEY  
T 235 R7W

S35 | S36

S1

1957

BUREAU OF LAND MANAGEMENT

FROM THE 1955 DCSD RENEWAL A 2 1/2 INCH DIAM. BRASS CAP (CORRECTED BY DCSD IN 1958 TO READ AS AT LOWER RIGHT) IS SET PLUMB ON THE WESTERLY EDGE OF THE ABOVE FOUND BLM BRASS CAP AND PROTRUDES 9 INCHES ABOVE GROUND.

COUNTY SURVEYORS  
T 235 R7W

35 | 36

S1

T 245 R7W

1955

OFFICE

Accessories Found

ACCESSORIES ARE MEASURED FROM THE BLM BRASS CAP.

EVIDENCE OF ONE O.B.T.:  
THE NW TREE FALLS UNDER EXISTING GRAVEL ROAD EDGE.  
ROTTED FIR WOOD IS IN GROUND NEAR RECORD BEARING AND DISTANCE OF ORIG. NE B.T..

EVIDENCE OF THE ONE (RETAINED AFTER 1958 CORRECTION) 1955 RENEWAL B.T.:  
A 40" R. FIR NOW A 48 INCH DIAM. 2 FOOT TALL BROKEN AND ROTTED FIR STUMP WITH NO BLAZE EVIDENCE BEARS N 80° W, 22° FEET DISTANT (AS PER RECORD).  
NO EVIDENCE REMAINS OF THE TWO ERRONEOUSLY MARKED 14" W. FIRS.

EVIDENCE OF THE TWO B.T.'S NEW IN THE 1957 BLM RESURVEY:  
A CEDAR 9" DIA. NOW A 38 INCH DIAM. INCENSE CEDAR WITH A BARLEY VISIBLE HEALED BLAZE ; BEARS N 34° E, 135 1/2 FEET DISTANT (AS PER RECORD).  
A FIR 8" DIA. IS NOW AN ALMOST COMPLETELY ROTTED AND SCATTERED FIR STUMP NEAR RECORD B. AND D.

THE ONE NEW B.T. FROM THE 1992-93 BLM RESURVEY.  
A FIR 13" DIA. NOW A 22 INCH DIAM. GRAND FIR WITH A FULLY HEALED DOUBLE BLAZE ; BEARS N 80° W, 30 1/2 FEET DISTANT (RECORD N 80° W, 31° FT. POSSIBLY TO TRUNK CENTER NOT C.R.C.).

N/A

N/A

New Accessories

A 5 INCH DIAM. DOUGLAS FIR SCRIBED "X" "CSBT" ON A HIGH-LOW BLAZE; BEARS N41 1/2° E, 27° FEET DISTANT.


AN 8 INCH DIAM. GRAND FIR SCRIBED "T23SR7WS35CS" "BT" ON A DOUBLE BLAZE; BEARS N61 3/4° W, 14° FEET DISTANT.

ALSO A 2 1/2 INCH X 2 1/2 INCH STEEL FENCE POST FIRMLY SET AND PROTRUDING 3 1/2 FEET ABOVE GROUND; BEARS N12° E, 3 1/2 FEET DISTANT (THIS POST IS AN END ANCHOR FOR AN UNMAINTAINED WIRE FENCE RUNNING EAST.

Sketch of Monument, Accessories, and General Area

Location & Comments

SKETCH ONLY SHOWS LIVE TREES

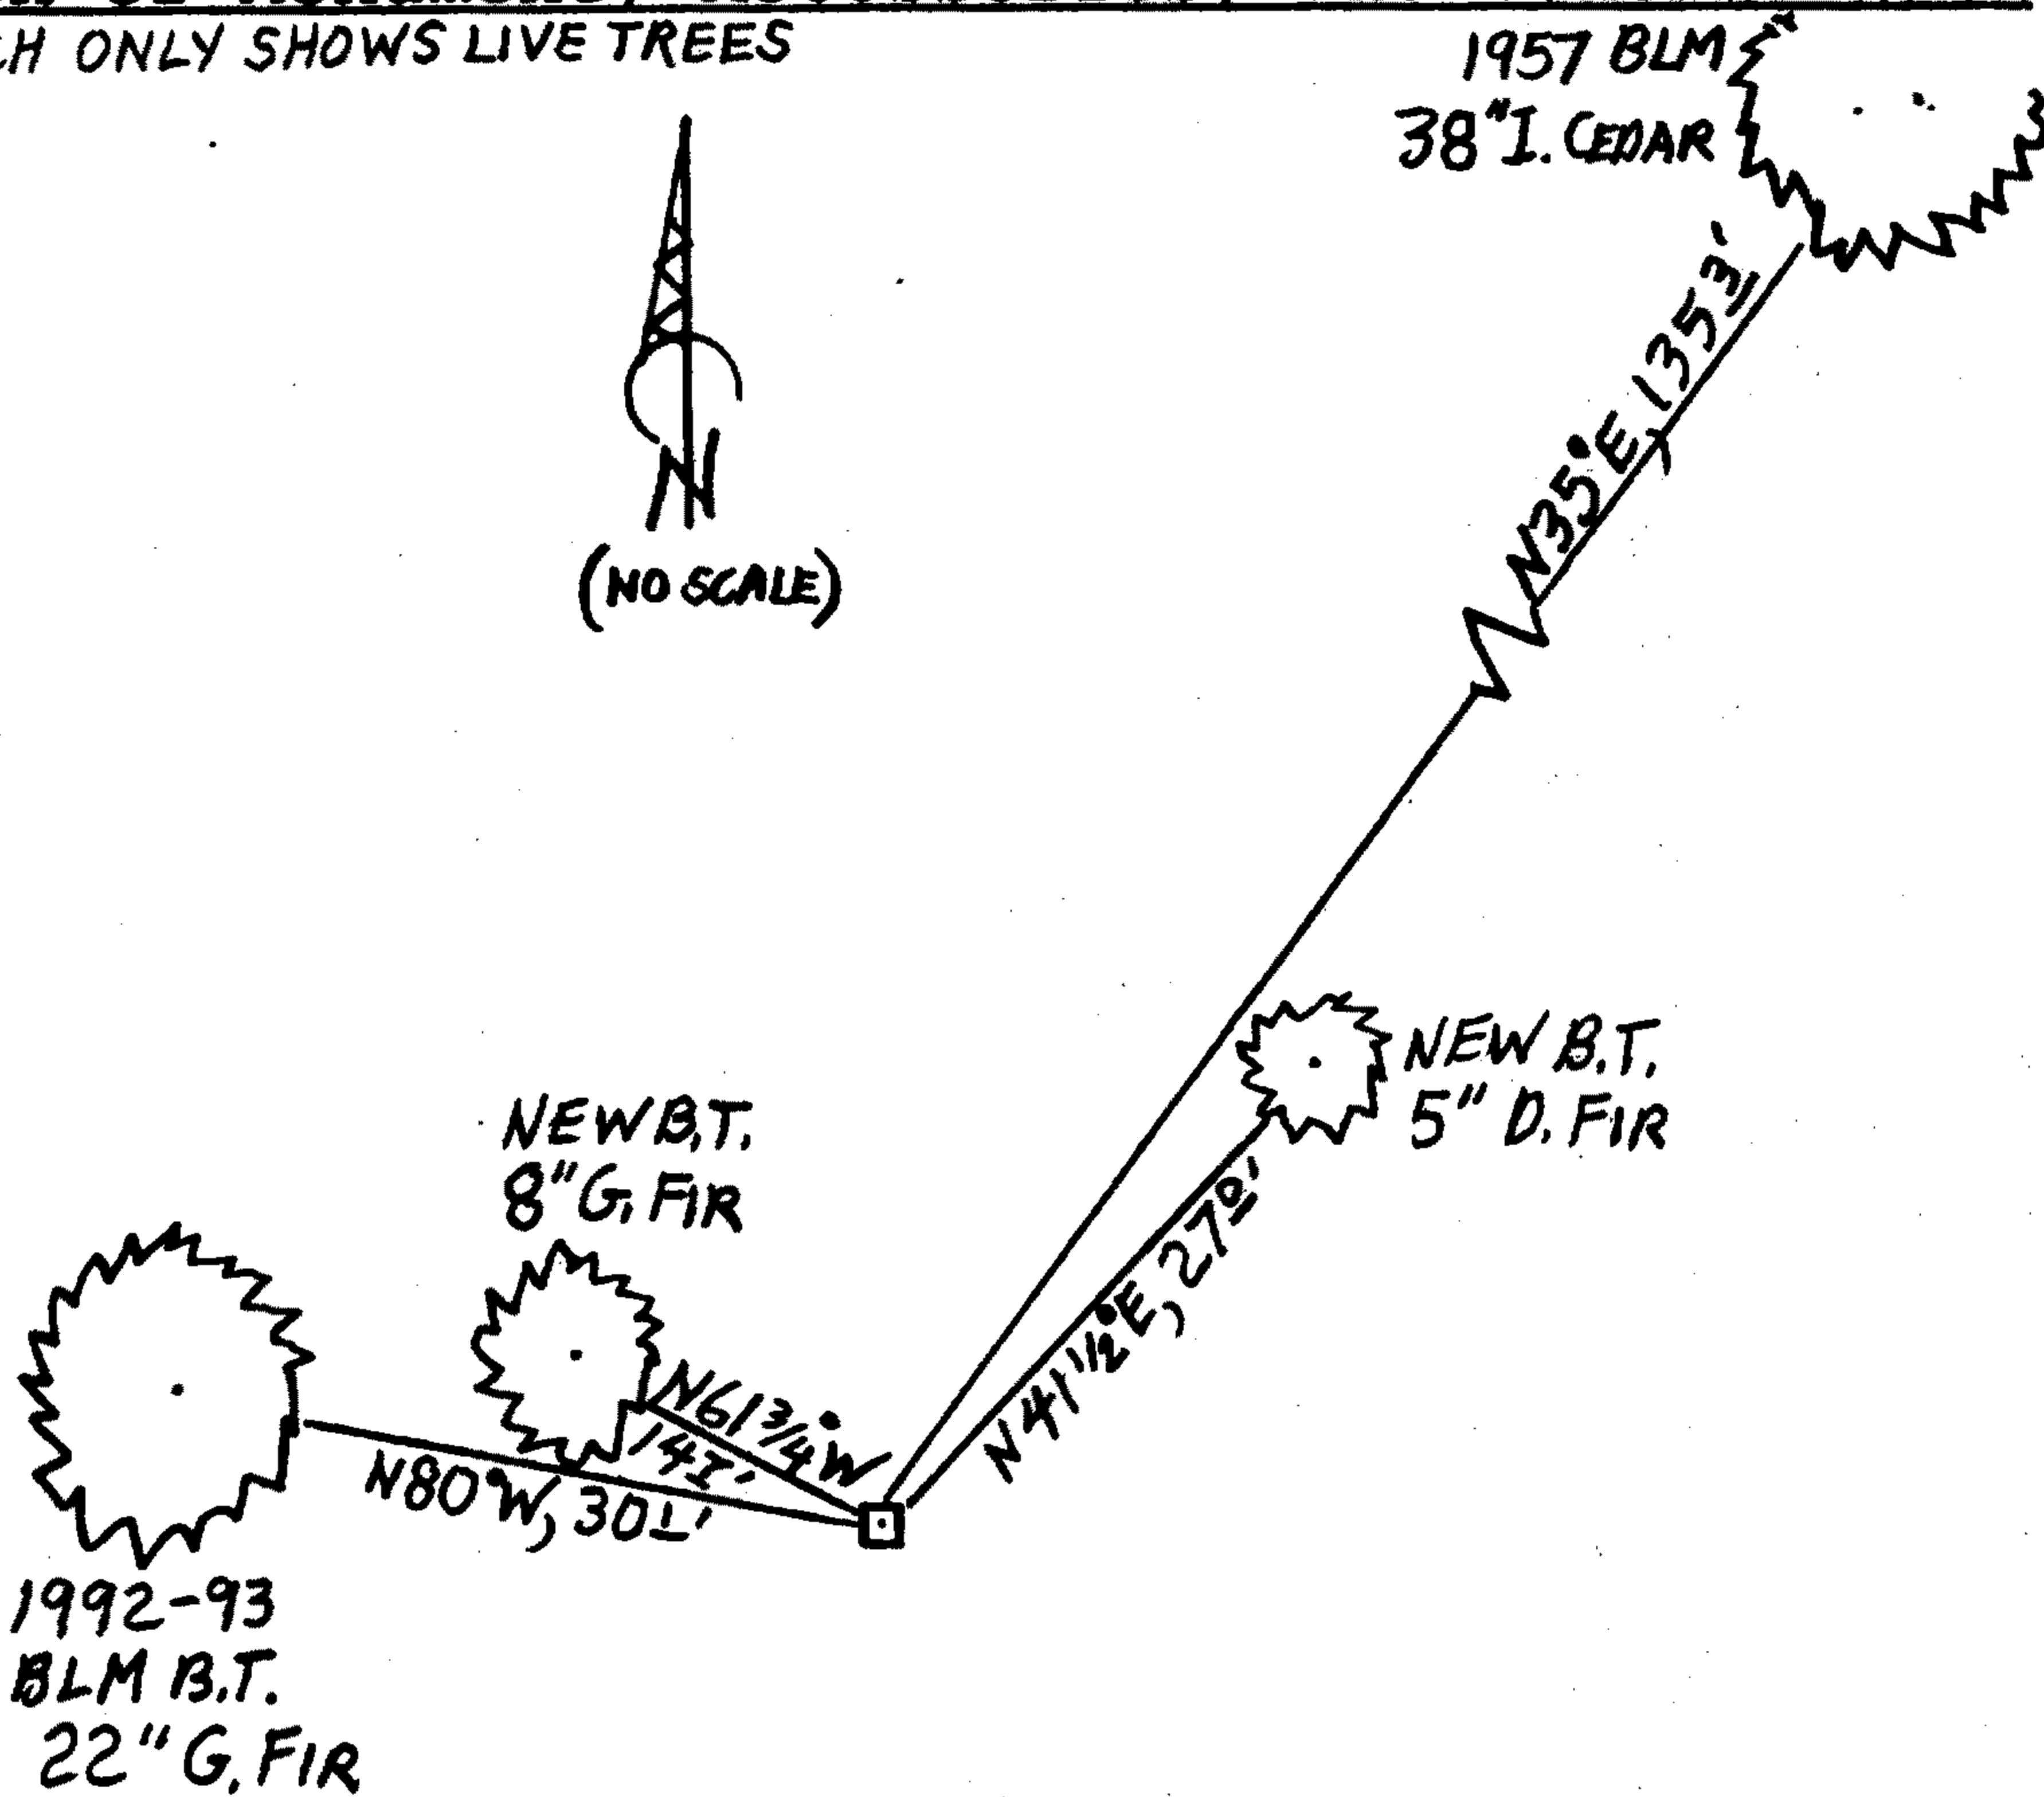

MONUMENT IS IN OLDER FIR REPROD FOREST ON M/L FLAT GROUND WHICH QUICKLY RISES TO EAST. AN INTERSECTION OF TWO GRAVELLED ROADS BEARS N73°W, 75 FEET.

Comp. Decline. 15 1/2° E  
Agency D.C.S.O  
Party Chief STEPHEN JOHN FLAISE  
Note keeper Stephen John Flaise  
Witnesses MIKE S. KOCH

Surveyor's Seal

REGISTERED PROFESSIONAL LAND SURVEYOR

*Randall W. Smith*

OREGON  
JULY 25, 1990  
RANDALL W. SMITH  
2489

RENEWAL G-30-2011