

GOVERNMENT CORNER RESTORATION FORM

FILED

TOWNSHIP 32S RANGE 02W SEC. 13 PLSS # 600440

Date: 8/4/2014 By: JC
This survey consists of:

DOUGLAS COUNTY OREGON

DATE JULY 23, 2014


Map: _____

Narrative: _____

Corner Rpt: CS 67/41-31

Corner Designation

DOUGLAS COUNTY
SURVEYOR

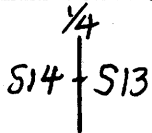

Previous Renewals 1963, 2013
Monument(s) Found: _____ (Condition and Source)

- _____ Condition Report
- _____ Not Found
- Renewed
- _____ Unrecorded
- _____ Surveyed In
- _____ Referenced Out

ORIGINAL IRONSTONE SEARCHED FOR BUT NOT FOUND.

MONUMENT DETAIL

FROM THE 1963 RENEWAL A 2 1/2 INCH DIAMETER BRASS CAP (MARKED AS AT RIGHT) ON A 1 INCH I.D. IRON PIPE IS BENT AND LEANING S47°E, 0.8 FEET FROM ITS PLUMB POSITION AND PROTRUDES 5 INCHES ABOVE A LOW, ROUGH PILE OF STONES.

COUNTY SURVEYORS OFFICE

T 32 S

1/4

S14

S13 R
2
W

1963

ABOVE FOUND MONUMENT WAS PARTIALLY BURIED UNDER LOGGING DEBRIS, WHICH IS REMOVED FROM AREA.

Accessories Found

ACCESS. MEASURED FROM PLUMB POSITION OF MON. ABOVE

NO EVIDENCE REMAINS OF ORIGINAL B.T.'S; BOTH FALL IN REWORKED SKID ROAD.

TWO 1963 RENEWAL B.T.'S

A 9" YEWOD NOW AN 11 INCH DIAM. PACIFIC YEW WITH A PARTIALLY HEALED DOUBLE BLAZE STILL SHOWING THE SCRIBING "1/4 S13 CS" "BT"; BEARS N89°E, 32.0 FEET DISTANT (AS PER RECORD).

A 9" W.FIR NOW A 29 INCH DIAM. WHITE FIR WITH A FULLY HEALED DOUBLE BLAZE; BEARS S43°W, 76.5 FEET DISTANT (AS PER RECORD).

C.S. File 67/41-31

RENEWAL

Monument Set (Procedure and Description)

MONUMENT DETAIL

THE PLUMB POSITION OF THE FOUND B.C. MONUMENT IS REFERENCED OUT. THE MONUMENT IS REMOVED FROM GROUND (ITS IRON PIPE IS FOUND TO BE 36 INCHES LONG) THE PIPE IS STRAIGHTENED AND THE MONUMENT IS RETURNED TO THE REFERENCED PLUMB POSITION.

N/A

THE B.C. MONUMENT IS NOW PLUMB AND PROTRUDES 4 INCHES ABOVE THE GROUND. THE MONUMENT IS SURROUNDED BY A LOW 2 FOOT DIAMETER MOUND OF STONE WHICH RISES 4 INCHES ABOVE THE BRASS CAP.


New Accessories

A 20 INCH DIAM. WHITE FIR SCRIBED "1/4 S13" "CSBT" ON A DOUBLE BLAZE; BEARS N10 1/2° E, 37 1/2 FEET DISTANT.

AN 8 INCH LONG GALVANIZED SPIKE NAIL IS SET DRIVEN THROUGH A BEARING TREE TAG AND PROTRUDING 1 INCH ABOVE THE TOP OF A 23 INCH DIAM. 1 FOOT TALL DOUGLAS FIR STUMP. THE SPIKE AND THE CENTER OF THE ROOT-CROWN OF THE STUMP BEAR S09° E, 15 1/2 FEET DISTANT.

Sketch of Monument, Accessories, and General Area

Location & Comments

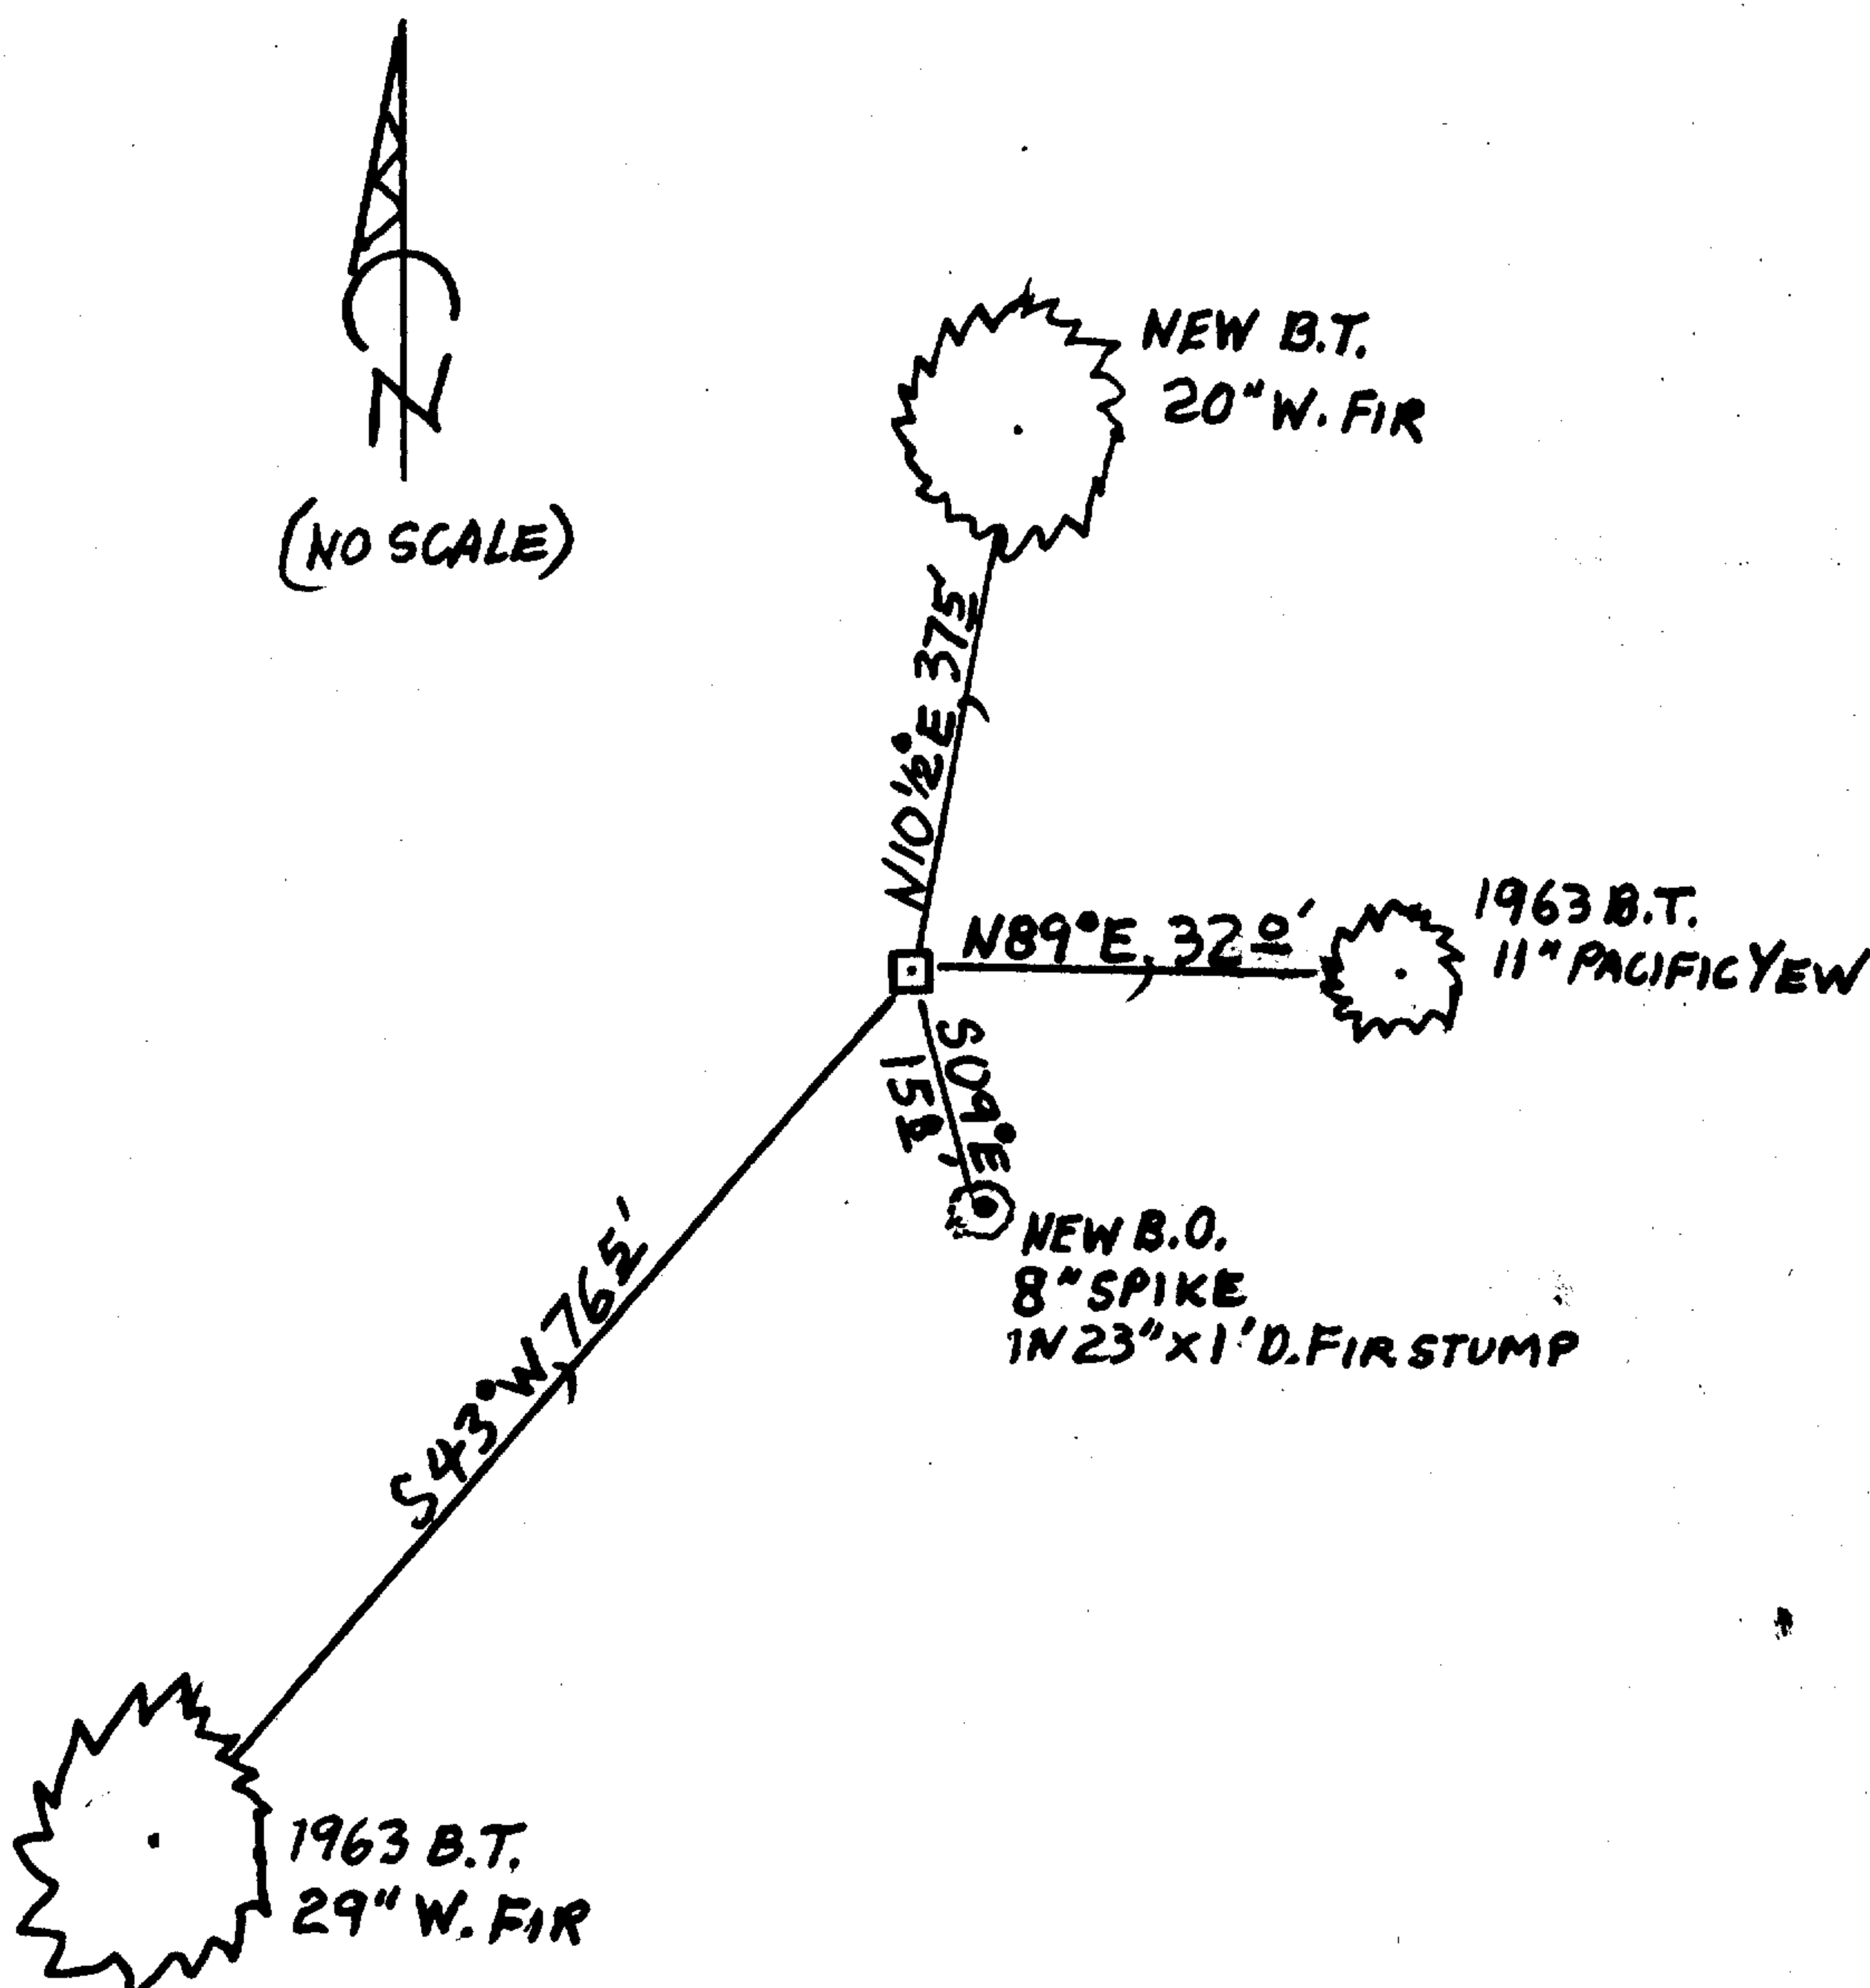

MONUMENT IS ON GENTLY NORTHERLY SLOPING GROUND WITH VERY OLD REPROD FIR IN THE NE QUADRANT. THE OTHER SURROUNDING QUADRANTS ARE MOSTLY CLEARCUT WITH SCATTERED OLDER REPROD FIRS.

Comp. Decline. 15 1/4° E
Agency D.C.S.O.
Party Chief STEPHEN JOHN FLAUSE
Note keeper Stephen John Flause
Witnesses MIKE S. KOCH

Surveyor's Seal

REGISTERED
PROFESSIONAL
LAND SURVEYOR

Randall W. Smith
June 6-30-2016

OREGON
JULY 25, 1900
RANDALL W. SMITH
2400