

GOVERNMENT CORNER RESTORATION FORM

FILED

TOWNSHIP 23S RANGE 07W SEC. 35 PLSS # 600140

Date: 8-12-2014 By: JK

This survey consists of:

DOUGLAS COUNTY OREGON


DATE JULY 30, 2014

Map: \_\_\_\_\_

Narrative: \_\_\_\_\_

Corner Rpt: CS 67/41-34

Corner Designation

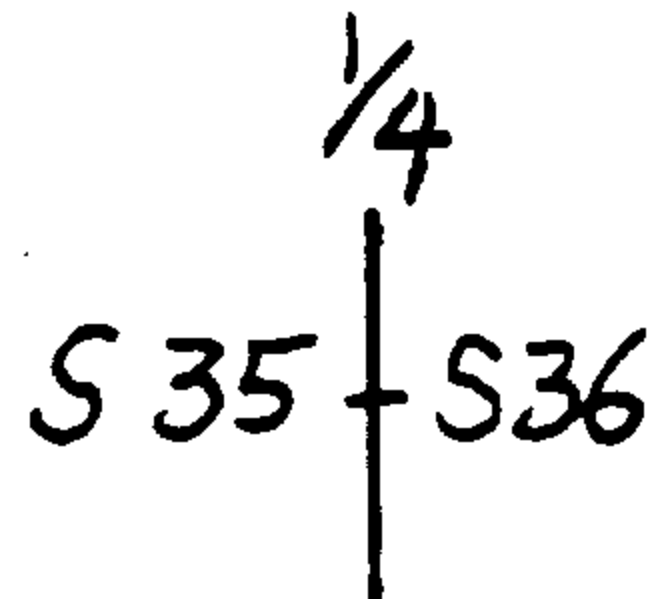

DOUGLAS COUNTY SURVEYOR

Previous Renewals 1949, 1961-62, 1994  
Monument(s) Found: (Condition and Source)

- \_\_\_ Condition Report
- \_\_\_ Not Found
- Renewed
- \_\_\_ Unrecorded
- \_\_\_ Surveyed In
- \_\_\_ Referenced Out

MONUMENT DETAIL

U. S. DEPT OF THE INTERIOR

1/4

S35 | S36

T23S R7W

1961

BUR. OF LAND MANAGEMENT

FROM THE 1961-62 BLM RESURVEY A  
3 1/4 INCH DIAMETER BRASS CAP (MARKED AS  
AT RIGHT) ON A 2 INCH I.D. IRON PIPE SET  
PLUMB AND PROTRUDING APPROX. 14 INCHES  
FROM A NOW MOSTLY BURIED, ROUGH MOUND  
OF STONE.

Accessories Found

EVIDENCE OF THE TWO ORIGINAL BEARING TREES.  
A CEDAR 16" DIA. NOW NOW A FALLEN, BROKEN AND ROTTEN 20+ INCH DIAM. CEDAR WITH  
NO DISCERNIBLE BLAZES OR ROOT-HOLE LIES ON GROUND NEAR RECORD B. AND D.  
A FIR 16" DIA. NOW A 33 INCH DIAM. 2 FOOT TALL, TIN COVERED FIR STUMP WITH A PARTIALLY  
OPEN BLAZE, SHOWING NO SCRIBING; BEARS S80°W, 14 1/2 FEET DISTANT (AS PER RECORD).

EVIDENCE OF THE TWO 1961-62 BLM RESURVEY NEW B.T.'S.  
A FIR 6" DIA. NOW A SHATTERED AND ROTTEN 14 INCH DIAM. 3 FOOT TALL DOUGLAS FIR  
STUMP WITH A POSSIBLE LOW HEALED BLAZE; BEARS S28 1/4°E, 22 1/4 FEET DISTANT  
(AS PER RECORD).

A FIR 37" DIA. NOW A 28 INCH DIAM 4 FOOT TALL, TIN COVERED, FIR STUMP WITH A  
FULLY HEALED BLAZE; BEARS N48 3/4°W, 30 1/4 FEET DISTANT (AS PER RECORD).

EVIDENCE OF THE ONE 1994 RENEWAL B.T..  
A 29" D. FIR NOW A 32 INCH DIAM. 5 FOOT TALL, DOUGLAS FIR STUMP WITH A PART-  
IALLY HEALED SINGLE BLAZE SHOWING THE SCRIBING "3 BT"; BEARS N77°E, 57 3/4  
FEET DISTANT (RECORD N77°E, 56 1/2 FEET).

C.S. File 67/41-34

N/A

N/A

New Accessories

A 12 INCH DIAM. DOUGLAS FIR SCRIBED "1/4 S35 CS" "BT" ON A DOUBLE BLAZE ; BEARS N43 1/2° W, 35' FEET DISTANT.


AN 8 INCH DIAM. DOUGLAS FIR SCRIBED "1/4 S35" "CS BT" ON A DOUBLE BLAZE ; BEARS N11 1/2° W, 19 1/2 FEET DISTANT.

Sketch of Monument, Accessories, and General Area

Location & Comments

SKETCH SHOWS SOLID STUMPS AND NEW B.T.'S ONLY.

MONUMENT IS ON MODERATE SOUTH SLOPE JUST EAST OF A N-S CUTTING LINE WITH OLDER FIR REPROD TO WEST AND A RECENT CLEAR-CUT TO EAST.

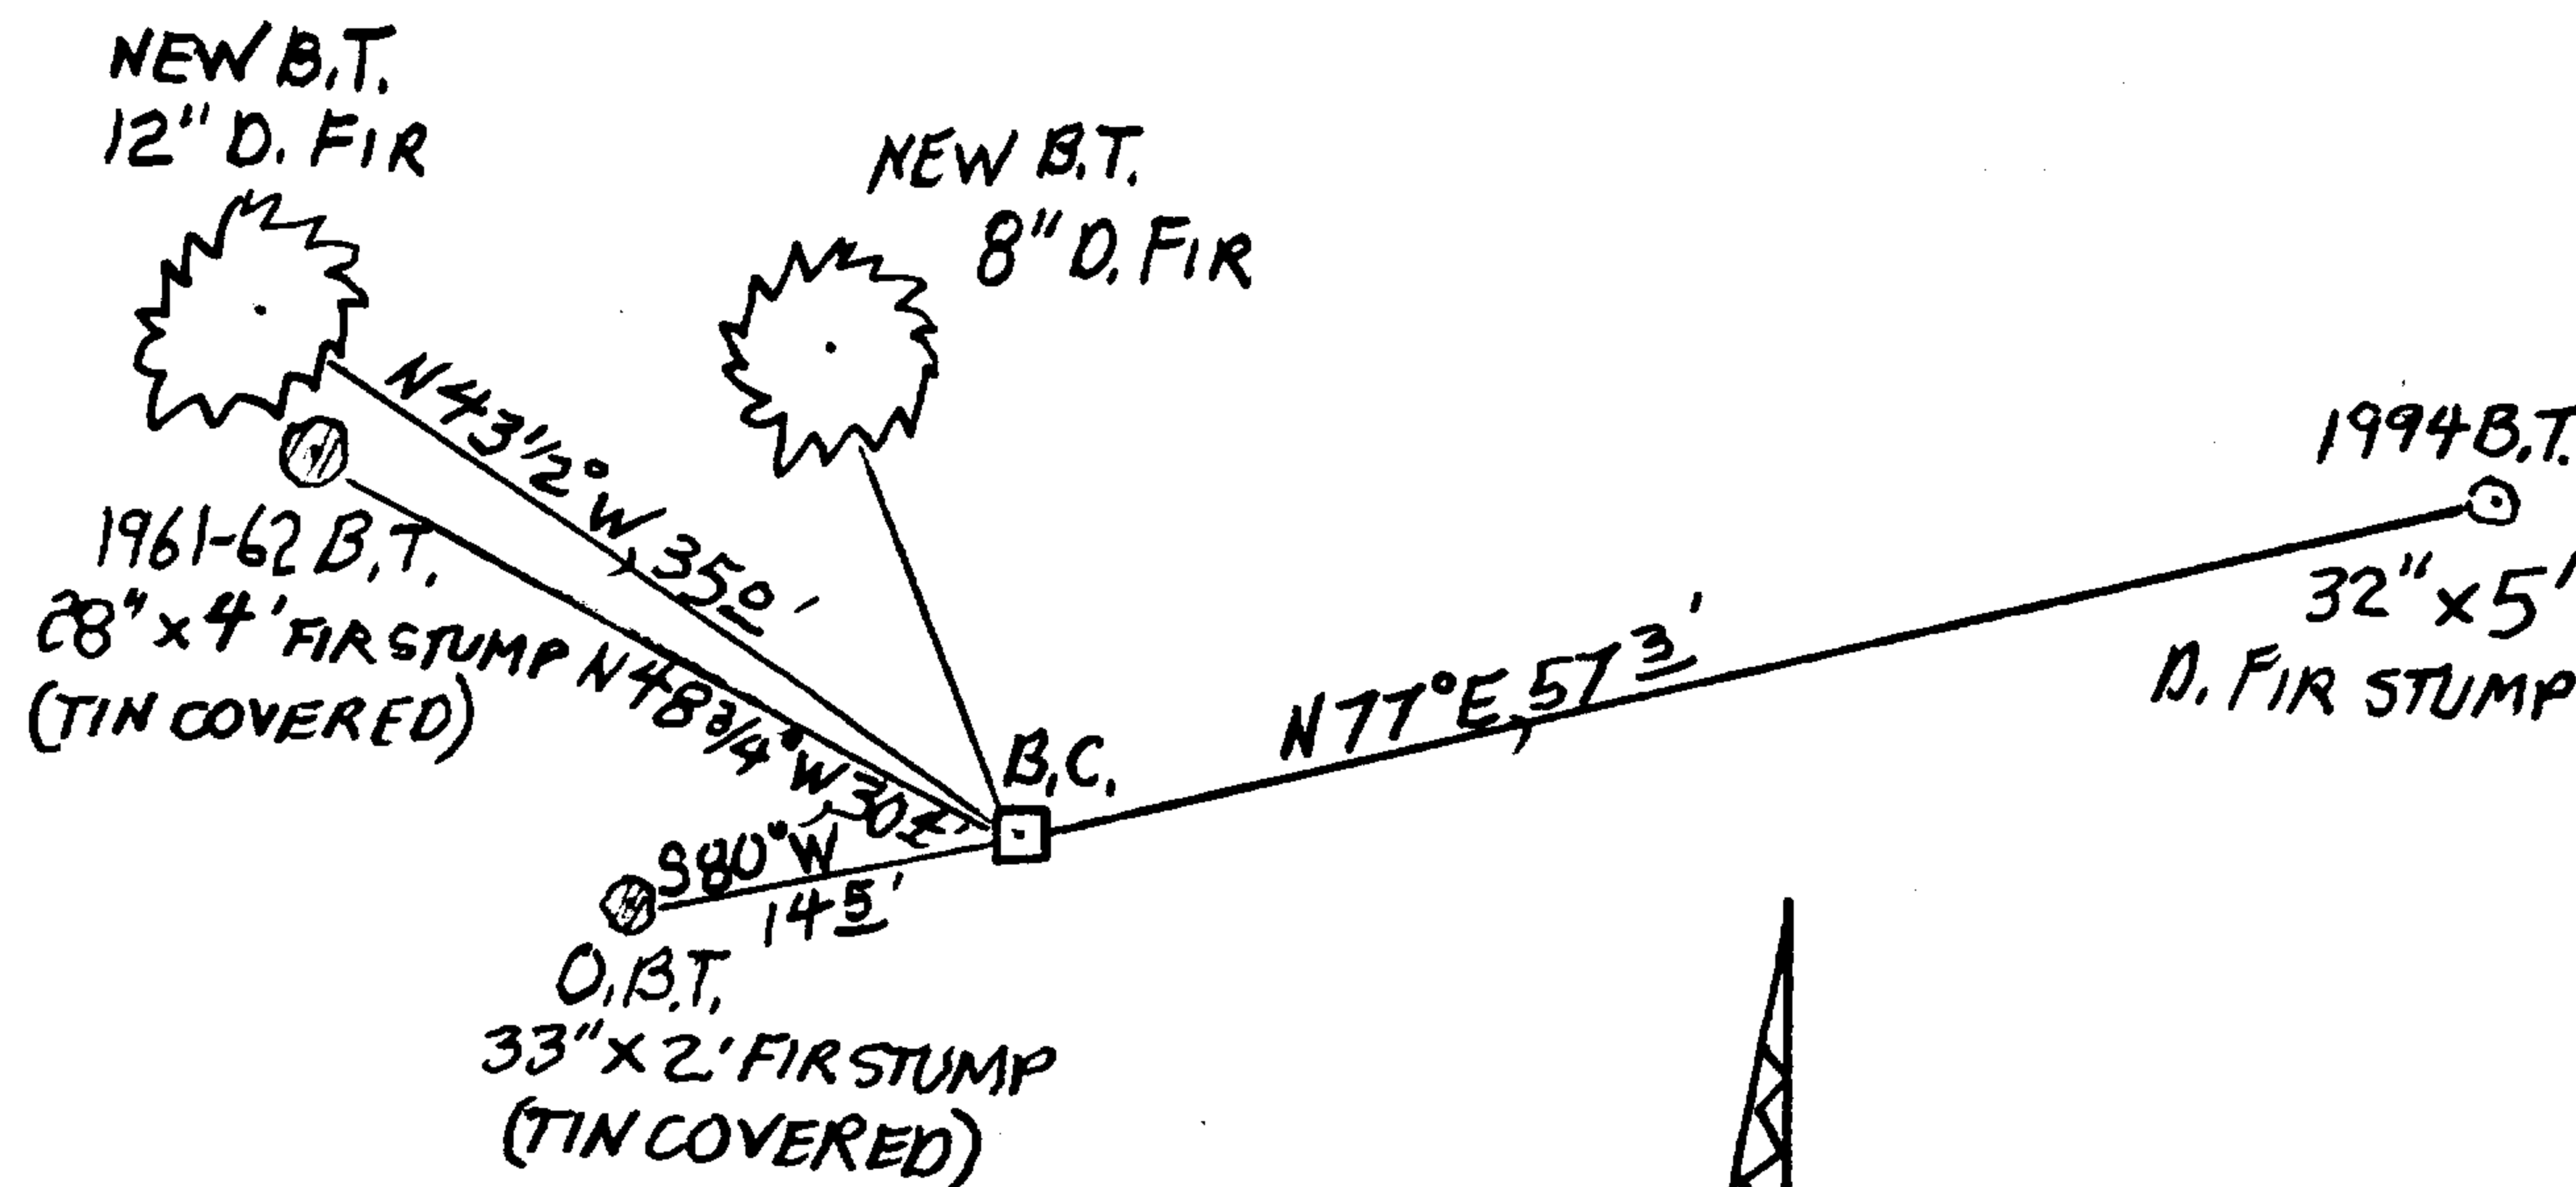

1994 B.T. Comp. Decline. 15 1/2° E  
32" x 5' Agency D.C.S.O.  
D. FIR STUMP Party Chief STEPHEN JOHN FLAUSE  
Note keeper Stephen John Flause  
Witnesses MIKE S. KOCH



Surveyor's Seal

REGISTERED  
PROFESSIONAL  
LAND SURVEYOR

*Randall W. Smith*

OREGON  
JULY 25, 1990  
RANDALL W. SMITH  
2468

RENEWAL 6-30-2016