

Monument Set (Procedure and Description)

MONUMENT DETAIL

N/A

N/A

New Accessories

B.T. TAGS WERE INTERCHANGED. WE REMOVE TAGS AND PLACE ON CORRECT TREES

Sketch of Monument, Accessories, and General Area


Location & Comments

N/A


N/A

Comp. Decline. 15 1/2° E
Agency DCSD
Party Chief STEPHEN JOHN FLAUSE
Note keeper Stephen John Flause
Witnesses MIKE S. KOCH

Surveyor's Seal

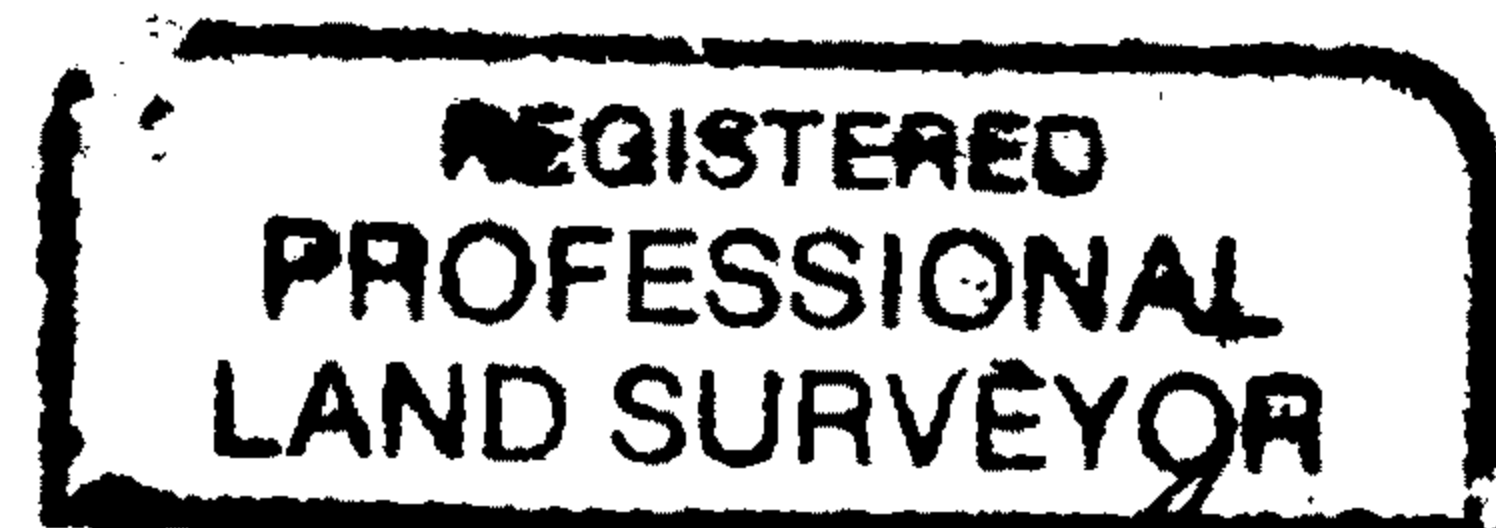

Randall W. Smith

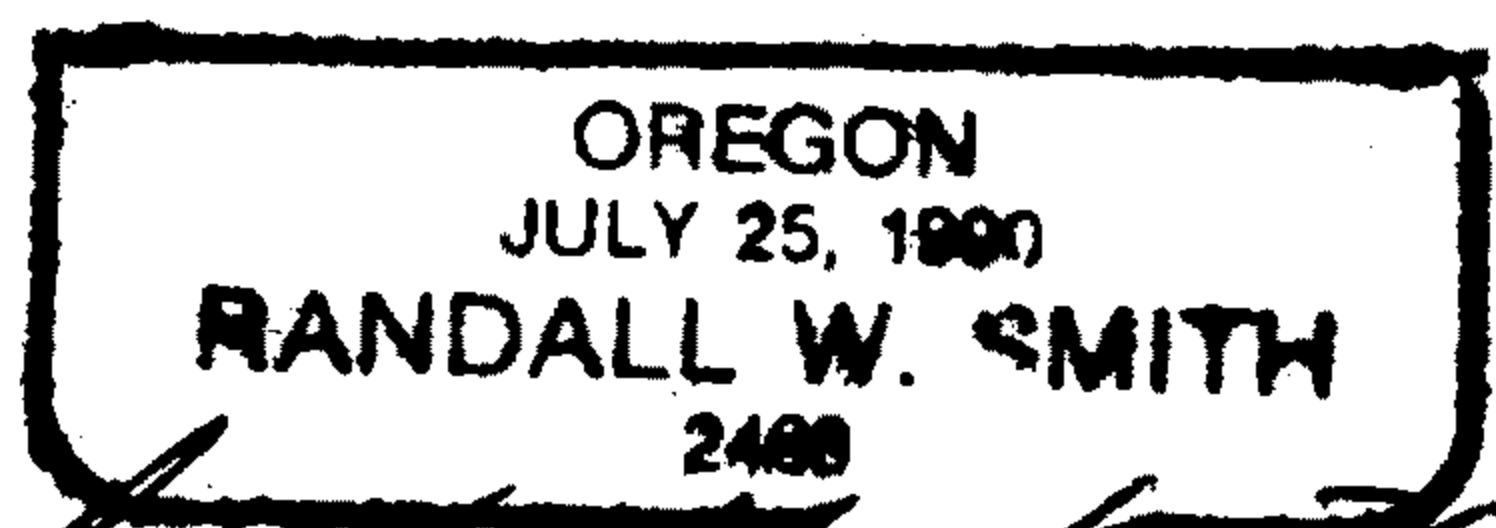

FORGONE 6-30-2016