

GOVERNMENT CORNER RESTORATION FORM

FILED

TOWNSHIP 24S RANGE 07W SEC. 4 PLSS # 300700

Date: 8-25-2014 By: JC

This survey consists of:

DOUGLAS COUNTY OREGON

DATE AUG. 5, 2014

Map: _____

Narrative: _____

Corner Designation

Corner Rpt: CS 67/41-40

CC
55 | 54

DOUGLAS COUNTY
SURVEYOR

Previous Renewals ESTBAS CC 1960 DCSO, RESURVEY ESTB. BLM 1963
Monument(s) Found: (Condition and Source)

- _____ Condition Report
- _____ Not Found
- Renewed
- _____ Unrecorded
- _____ Surveyed In
- _____ Referenced Out

FROM THE 1963 BLM RESURVEY A 3 1/4 INCH DIAMETER BRASS CAP (MARKED AS AT RIGHT) ON A 2 INCH I.D. IRON PIPE IS SET PLUMB, PROTRUDING 7 INCHES ABOVE GROUND.

MONUMENT DETAIL

U. S. CADASTRAL SURVEY

T 23 S R 7 W

S 32

55 | 54

T 24 S R 7 W

1963

BUREAU OF LAND MANAGEMENT

(SEE ACCESSORIES) COUNTY SURVEYORS OFFICE

T 23 S R 7 W

C.C.

55 | 54

T 24 S

1960

Accessories Found (ALL MEASURED FROM 1963 BLM TRUE C.C.)

THE SUPERCEDED 1960 DCSO CLOSING CORNER:
A 2 1/2 INCH DIAM. BRASS CAP (MARKED AS SHOWN IN LOWER MONUMENT DETAIL ABOVE) ON A 1 INCH I.D. IRON PIPE, SET PLUMB, PROTRUDING 13 INCHES ABOVE GROUND; BEARS N 0 1/4° E, 8 6 FEET DISTANT (AS PER RECORD)

THE ORIGINAL BEARING TREES FOUND BY BYRON AND BYRON'S RENEWAL BEARING TREES:
AN ORIGINAL 42" FIR NOW A ROTTED 48 INCH DIAM. 3 FOOT TALL SAWN FIR STUMP WITH NO EVIDENCE OF BARK SCRIBING REMAINING; BEARS S 43 3/4° E, 48 2 FEET DISTANT.

THE ORIGINAL SW 42" FIR IS DOWN AND MOSTLY ROTTED AWAY BUT THE REMNANTS LIE NEAR THE RECORD BEARING AND DISTANCE MEASURED IN 1960 FROM THE D.C.S.O. RENEWAL.

BYRON'S 12" K. FIR (ALSO MARKED AS NEW SW BEARING TREE BY BLM IN 1963) IS NOW A 2.7 INCH DIAM. DOUGLAS FIR WITH ONE LARGE FULLY HEALED SINGLE BLAZE; BEARING S 77 1/2° W, 17 2 FEET DISTANT (BLM RECORD S 79° W, 17 2 FEET).

BYRON 10" R. FIR NOW A 24 INCH DIAM. DOUGLAS FIR WITH A FULLY HEALED SINGLE BLAZE; BEARS N 21 1/4° W, 16 2 FEET DISTANT.

THE ONE NEW O.B.T. FOR THE 1963 TRUE CLOSING CORNER:
A 6" FIR NOW A 24 INCH DIAM. GRAND FIR WITH NO DISTINGUISHABLE BLAZE MARKS; BEARS S 73 1/2° E, 36 3 FEET DISTANT AS PER RECORD.

C.S. File 67/41-40

RENEWAL

Monument Set (Procedure and Description)

MONUMENT DETAIL

N/A


N/A

New Accessories

ALL FOUND TREES ARE TAGGED WITH NEW TAGS SHOWING BEARING AND DISTANCE TO 1963 BLM MONUMENT.

Sketch of Monument, Accessories, and General Area

Location & Comments

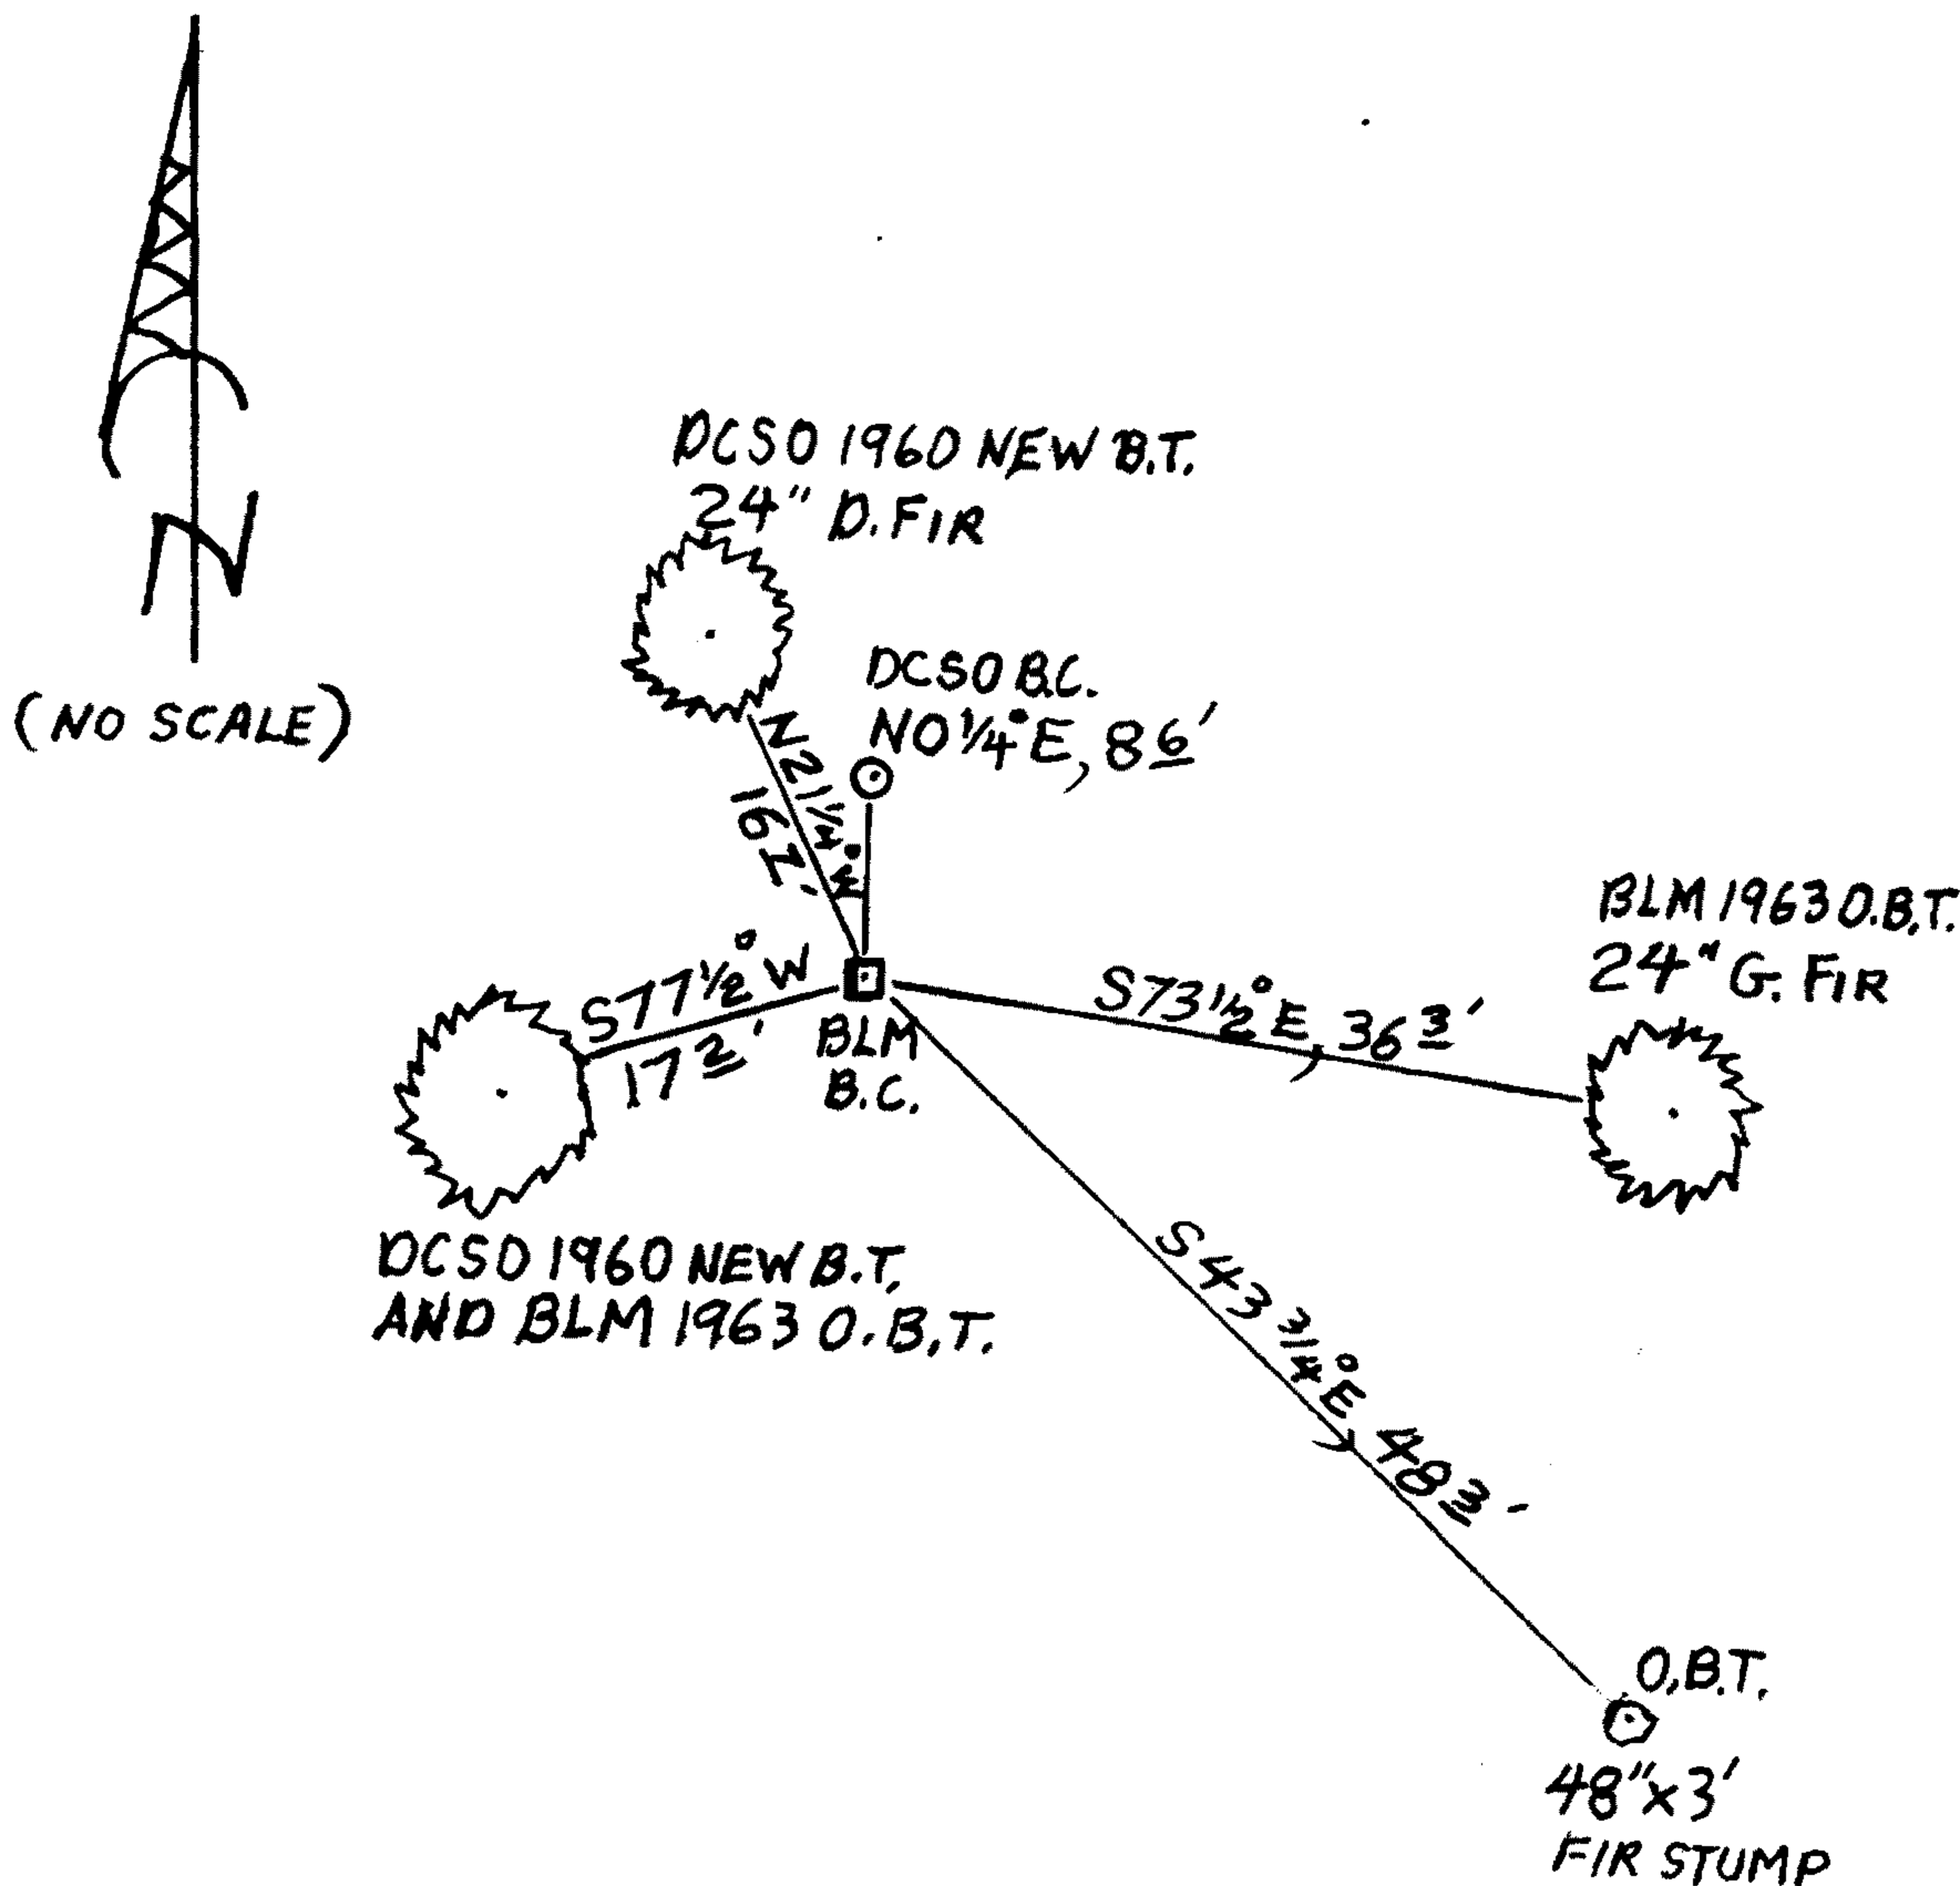

THE MONUMENT IS ON A GENTLE SW SLOPE IN VERY OLD MIXED FIR REPRDD.

Comp. Decline. 15 1/2° E
 Agency D.C.S.O.
 Party Chief STEPHEN JOHN FLAUSE
 Note keeper Stephen John Flause
 Witnesses MIKE S. KOCH

Surveyor's Seal

REGISTERED
 PROFESSIONAL
 LAND SURVEYOR

Handwritten signature of Randall W. Smith

OREGON
 JULY 25, 1990
 RANDALL W. SMITH
 2488

RENEWAL - 6-30-2016