

GOVERNMENT CORNER RESTORATION FORM

FILED

TOWNSHIP 23 S RANGE 07 W SEC. 32 PLSS # 300100

Date: 8-25-2014 By: Jc

This survey consists of:

DOUGLAS COUNTY OREGON

DATE AUG 6, 2014

Map: _____

Narrative: _____

Corner Rpt: CS 67/41-41

Corner Designation

DOUGLAS COUNTY SURVEYOR

S32 | S33
S4

- Condition Report
- Not Found
- Renewed
- Unrecorded
- Surveyed In
- Referenced Out

Previous Renewals 1960, 1963
Monument(s) Found: _____ (Condition and Source)

MONUMENT DETAIL

FROM THE 1960 D.C.S.O. RENEWAL:
A 2" INCH DIAMETER BRASS CAP (MARKED AS AT RIGHT) ON A 1 INCH I.D. IRON PIPE SET PLUMB PROJECTING 12 INCHES ABOVE GROUND.

COUNTY SURVEYORS OFFICE
T23S RTW

S32 | S33

1960

Accessories Found

EVIDENCE OF THREE ORIGINAL BEARING TREES:
A FIR 14" DIA. NOW A LARGE ROOT-HOLE APPROXIMATELY AT THE RECORD BEARING AND DISTANCE OF ORIGINAL SW BEARING TREE.
A FIR 14" DIA. NOW A DISTINCT ROOT-HOLE WITH A FALLEN AND ROTTED FIR NEARBY SHOWING THE REMNANTS OF THE 1960 REBLAZE WITH CLEAR BUT ILLEGIBLE FRAGMENTARY SCRIBING. THE ROOT-HOLE BEARS N45°W, 25 ± FEET DISTANT (AS PER RECORD).
A FIR 28" DIA. NOW 48 INCH DIAM. 2 1/2 FOOT TALL ROTTED FIR STUMP WITH NO REMAINING BLAZE OR SCRIBE EVIDENCE; BEARS S75°E, 36 8 FEET DISTANT (RECORD S75°E, 35 6 FEET IS A POSSIBLE FACE MEAS.)

THE ONE NEW (NOT RESCRIBED) 1960 BEARING TREE:
A 10" CEDAR NOW A 25 INCH DIAM. INCENSE CEDAR WITH A FULLY HEALED DOUBLE BLAZE; BEARS N29°E, 35 9 FEET DISTANT (AS PER RECORD).

THE ONE NEW 1963 BLM BEARING TREE:
A CEDAR 8" DIA. NOW A 26 INCH DIAM. INCENSE CEDAR WITH A FULLY HEALED DOUBLE BLAZE; BEARS N52 1/2°W, 48 7 FEET DISTANT (RECORD N52 1/2°W, 49 5 IS TO CENTER OF TRUNK AT BREAST HEIGHT).

N/A

N/A


New Accessories

AN 8 INCH DIAM. DOUGLAS FIR SCRIBED "T23SR7WS33" "CSBT" ON A DOUBLE BLAZE; BEARS N64°14'E, 232 FEET DISTANT.

AN 11 INCH DIAM. DOUGLAS FIR SCRIBED "T23SR7WS32 CS" "BT" ON A DOUBLE BLAZE; BEARS N56°12'W, 125 FEET DISTANT.

Sketch of Monument, Accessories, and General Area
SKETCH ONLY SHOWS INTACT B.T.S AND STUMPS

Location & Comments

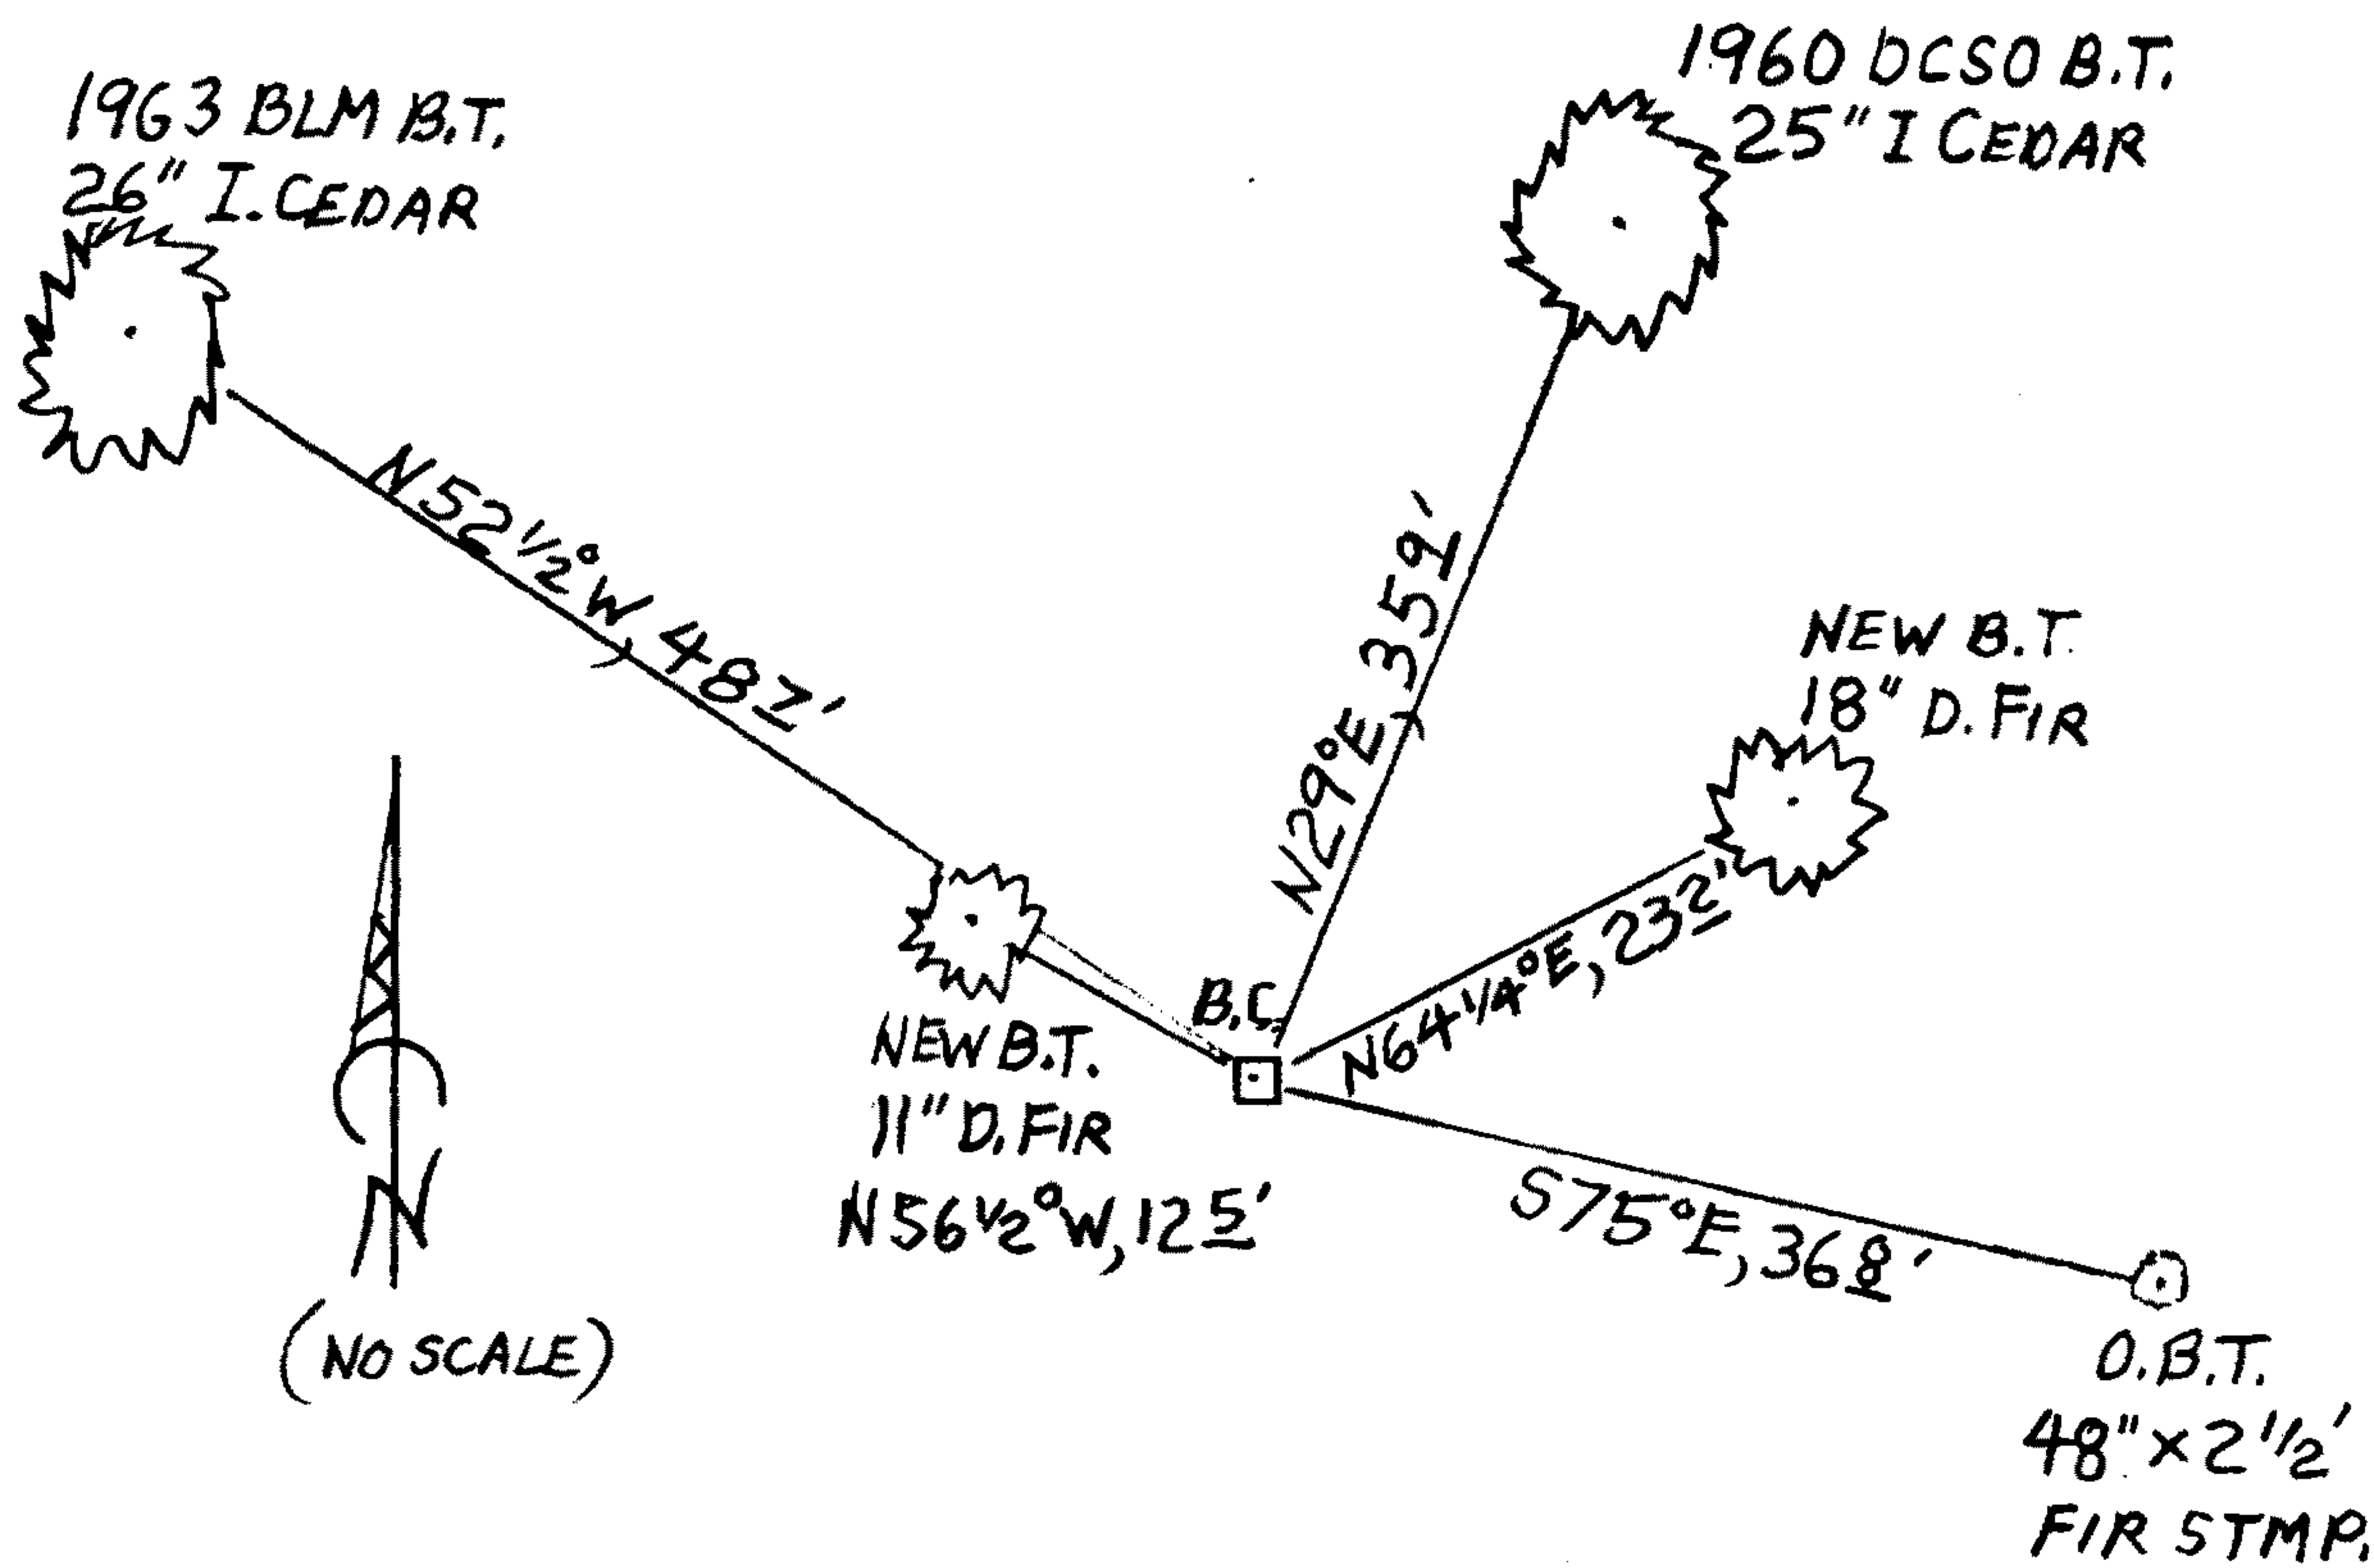

MONUMENT IS ON GENTLE SOUTH SLOPE IN OPEN FIR, CEDAR, OAK AND CHINQUAPIN FOREST.

Comp. Decline. 15 1/2° E
Agency N.C.S.O.
Party Chief STEPHEN JOHN FLAUSE
Note keeper Stephen John Flause
Witnesses MIKE S. KOCH

Surveyor's Seal

REGISTERED PROFESSIONAL LAND SURVEYOR

Randall W. Smith

OREGON
JULY 25, 1990
RANDALL W. SMITH
2489

RENEWAL 6-30-16