

GOVERNMENT CORNER RESTORATION FORM

FILED

TOWNSHIP 245 RANGE 06W SEC. 21 PLSS # 340300

Date: 9-11-2014 By: JC

This survey consists of:

DOUGLAS COUNTY OREGON

DATE SEPT. 08, 2014

Map: _____

Narrative: _____

Corner Rpt: CS67/41-42

Corner Designation

DOUGLAS COUNTY SURVEYOR

$\frac{1}{4} \frac{521}{528}$

CIRCA

Previous Renewals UNRECORDED C. 1900, UNRECORDED 1999
Monument(s) Found: (Condition and Source)

- Condition Report
- Not Found
- Renewed
- Unrecorded
- Surveyed In
- Referenced Out

MONUMENT DETAIL

FROM AN UNRECORDED RENEWAL (STONE'S COMMONLY SET FOR CORNERS IN THIS AREA FROM LATE 1900'S + EARLY 1900'S)
A 4 X 5 X 21 INCH TALL SANDSTONE MARKED WITH A "X" ON TOP, A "S+" ON THE EAST SIDE AND ILLEGIBLE BUT OBVIOUSLY SCRIBED IN MARKS ON WEST SIDE IS SET PLUMB PROTRUDING 10 INCHES ABOVE GROUND. N/A

FROM AN UNRECORDED 1999 LES ROBERTS RENEWAL:
A 5/8 INCH DIAMETER IRON ROD WITH A YELLOW PLASTIC CAP MARKED "ROBERTS SURVEY INC." IS SET PLUMB PROTRUDING 1 INCH ABOVE GROUND ON THE WEST EDGE OF THE ABOVE FOUND STONE.

Accessories Found

ALL ACCESORIES ARE MEASURED FROM "X" ON FOUND STONE.

POSSIBLE EVIDENCE OF ONE ORIGINAL BEARING TREE:
NEAR THE RECORD BEARING AND DISTANCE OF THE ORIGINAL SW TREE IS A SHALLOW INDISTINCT ROOT-HOLE WITH ROTTEN OAK ROOT REMNANTS.

FROM THE UNRECORDED 1999 LES ROBERTS RENEWAL, TWO BEARING TREES:
A 9 INCH DIAMETER DOUGLAS FIR WITH A FULLY HEALED DOUBLE BLAZE; BEARS S. 54° E, 29 1/2 FEET DISTANT (RECORD FROM FOUND B.T. TAG IS S 54° E, 30 1/2 FEET).
AN 11 INCH DIAM. DOUGLAS FIR WITH A FULLY HEALED DOUBLE BLAZE; BEARS N 34° W, 40 1/2 FEET DISTANT (AGREES WITH RECORD FROM FOUND B.T. TAG).

ALSO PROBABLY FROM THE 1999 RENEWAL A GREEN AND WHITE PAINTED STEEL FENCE POST IS SET WEST 1 1/2 FEET FROM THE FOUND STONE AND PROTRUDES 4 FEET ABOVE GROUND.

Monument Set (Procedure and Description)

MONUMENT DETAIL

N/A



New Accessories

A 12 INCH DIAM. MADRONE SCRIBED "1/4 521" "CS BT" ON A DOUBLE BLAZE; BEARS N 38° E, 17 1/2 FEET DISTANT.

A 14 INCH DIAM. MADRONE SCRIBED "1/4 528 CS" "BT" ON A DOUBLE BLAZE; BEARS S 14° W, 22 1/2 FEET DISTANT.

Sketch of Monument, Accessories, and General Area

Location & Comments

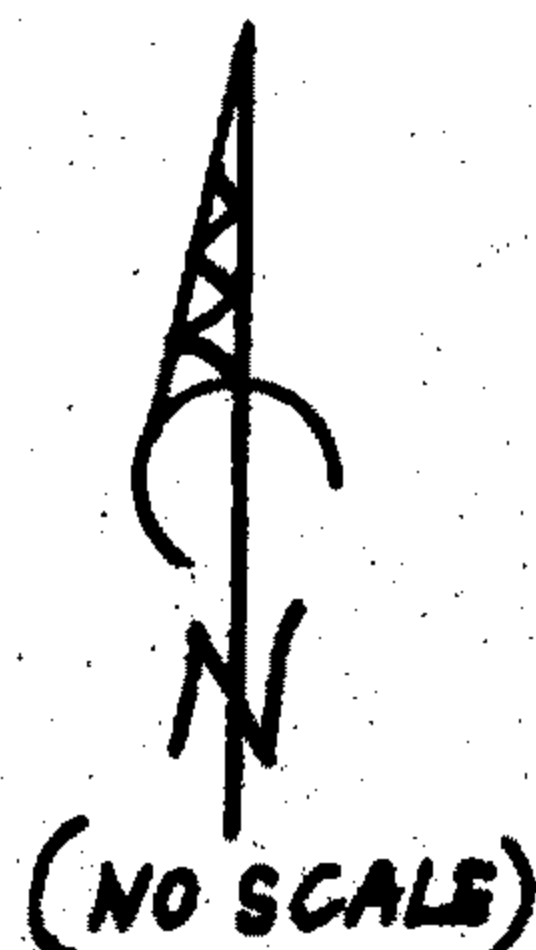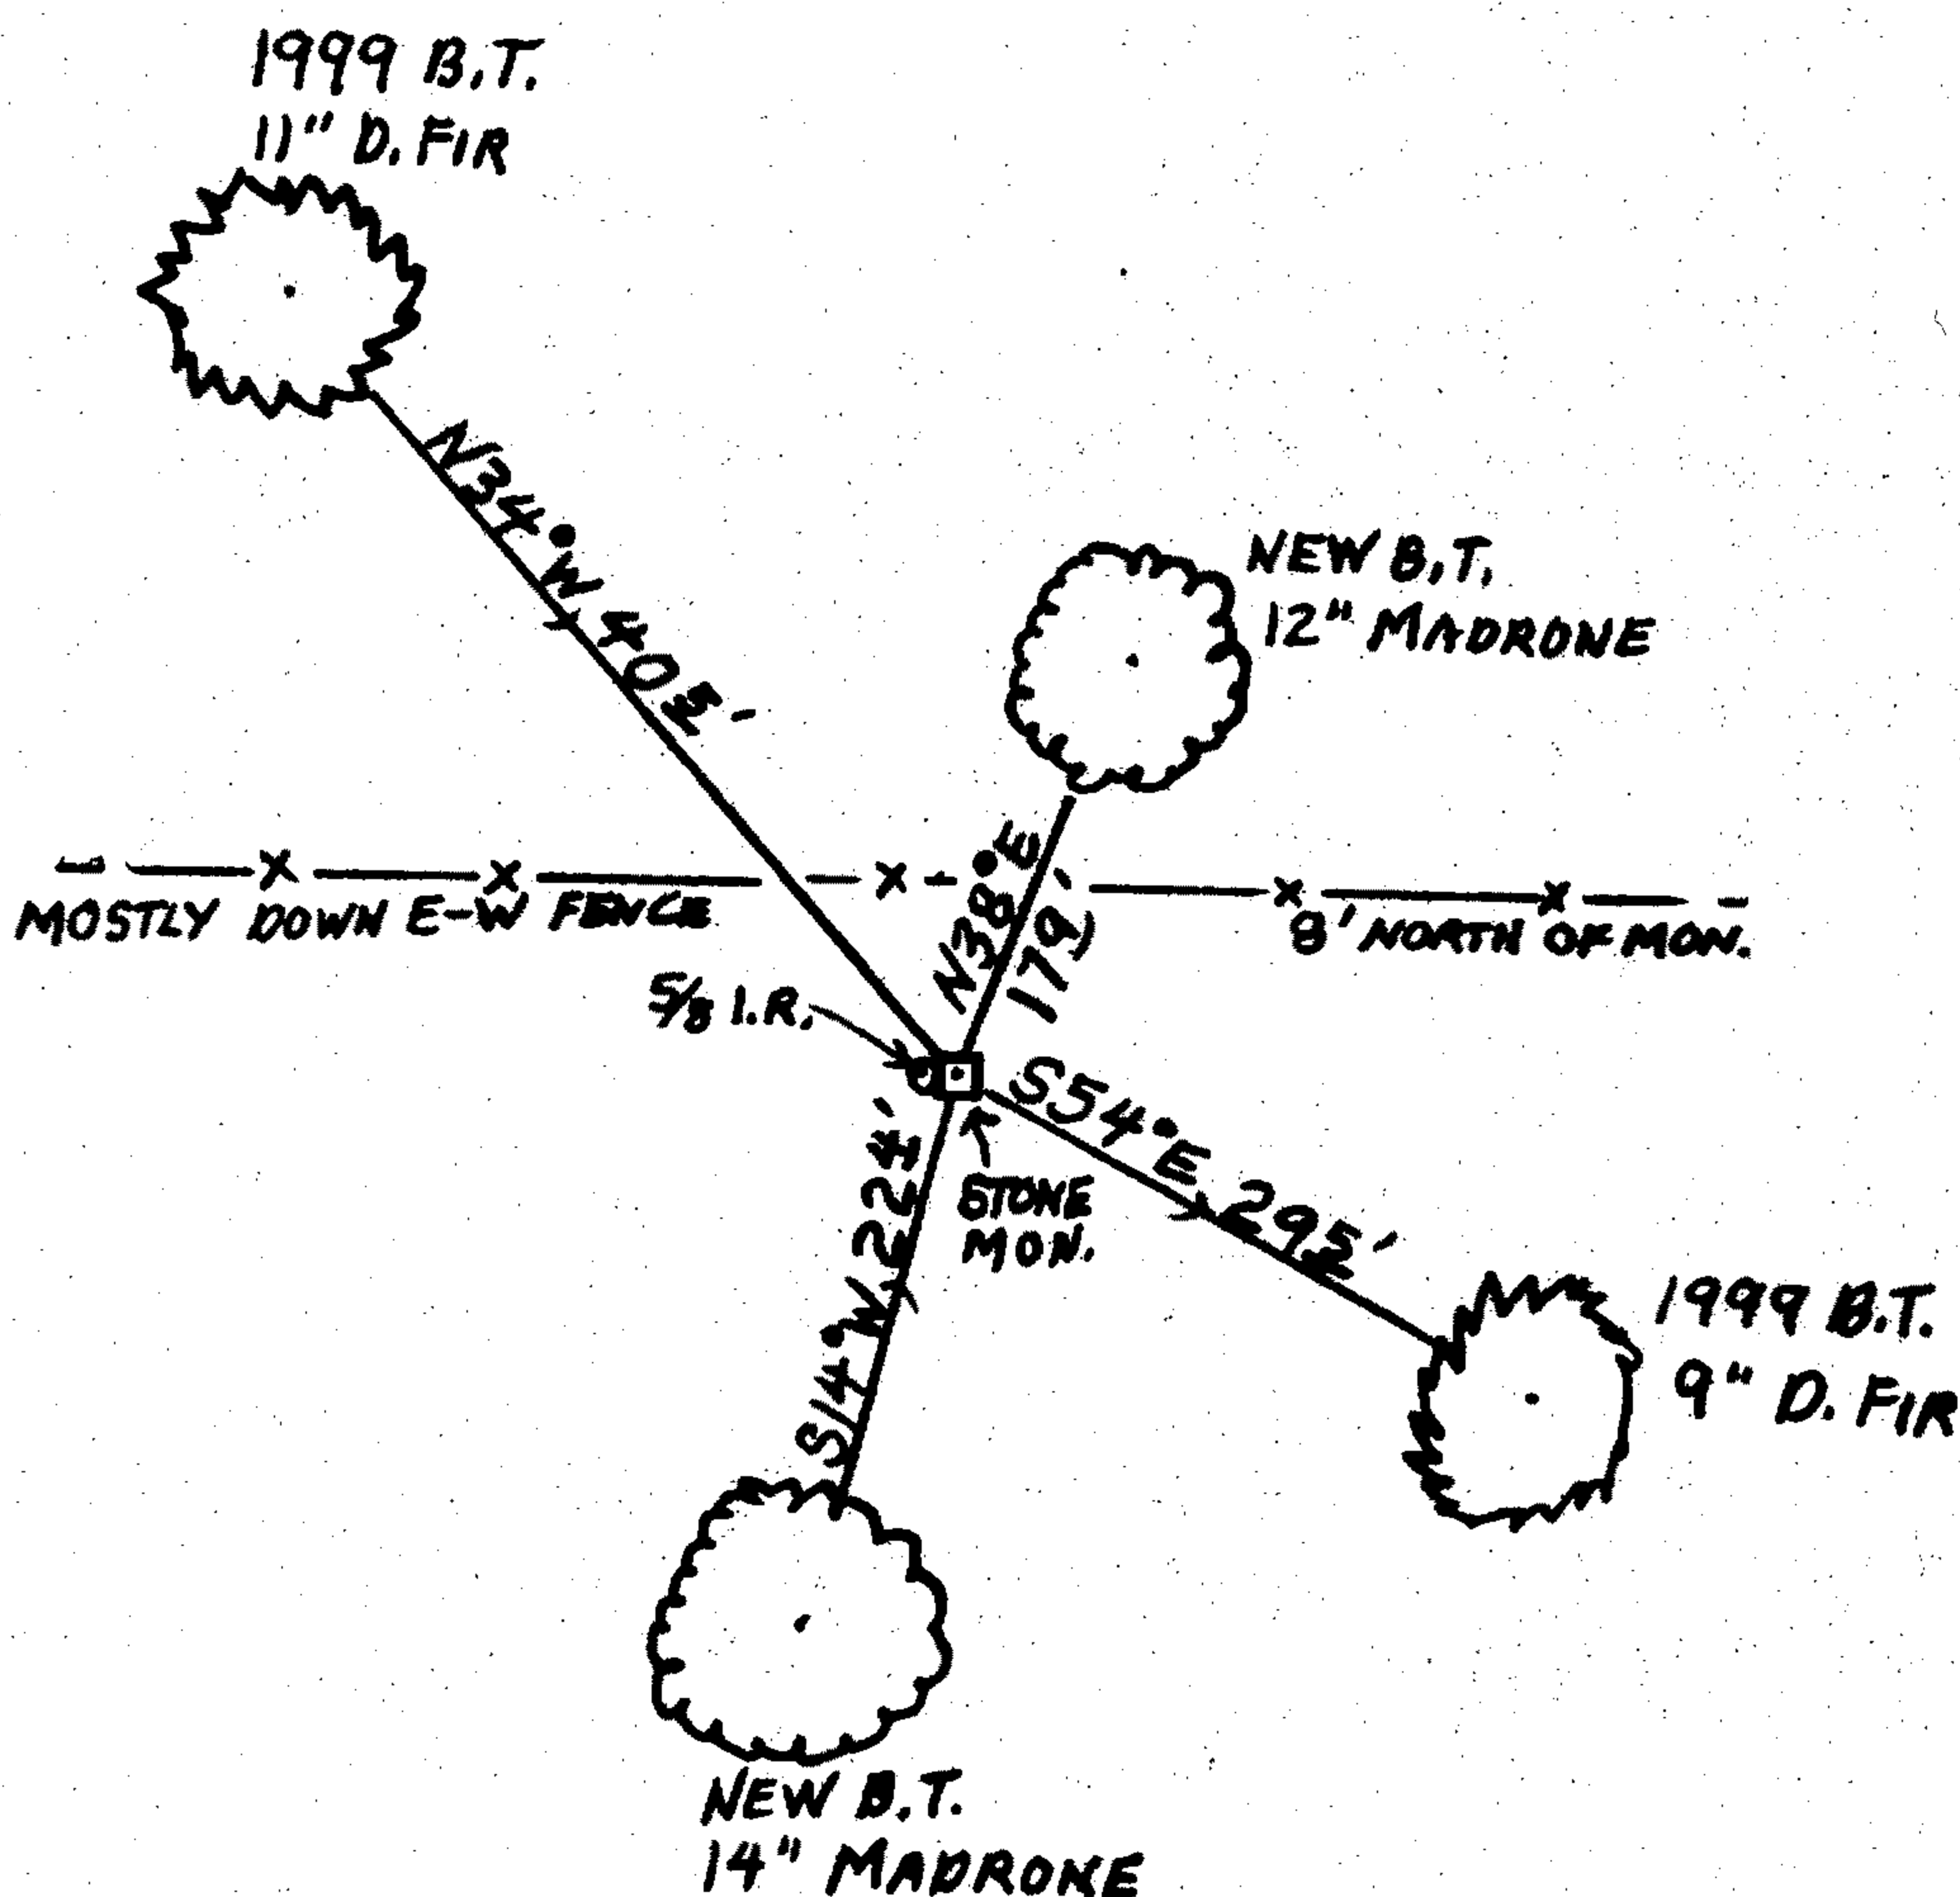

MONUMENT IS ON GENTLE WEST SLOPE APPROX. 270 FEET WEST OF A RIDGE TOP AND IN AN OPEN WOODS OF MOSTLY MADRONE WITH SOME SCATTERED FIR.

Comp. Decline. 15 1/2° E
 Agency DC SO
 Party Chief STEPHEN JOHN FLAUSE
 Note keeper Stephen John Flause
 Witnesses MIKE S. KOCH

Surveyor's Seal

REGISTERED
 PROFESSIONAL
 LAND SURVEYOR

Handwritten signature of Randall W. Smith

OREGON
 JULY 25, 1880
 RANDALL W. SMITH
 2489

RENEWAL 6-30-2016