

GOVERNMENT CORNER RESTORATION FORM

FILED

TOWNSHIP 23 S RANGE 07 W SEC. 27 PLSS # 400210

Date: 9-15-2014 By: X

This survey consists of:

DOUGLAS COUNTY OREGON

DATE AUG. 7, 2014

Map: \_\_\_\_\_

Narrative: \_\_\_\_\_

Corner Rpt: CS 67/41-43

Corner Designation

DOUGLAS COUNTY SURVEYOR

WP  
528 | 527

- Condition Report
- Not Found
- Renewed
- Unrecorded
- Surveyed In
- Referenced Out

Previous Renewals SET BY BLM RESURVEY 1961  
Monument(s) Found: (Condition and Source)

ORIGINAL MONUMENT FROM THE 1961 BLM RESURVEY:  
A 3/4 INCH DIAMETER BRASS CAP (MARKED AS AT RIGHT) IS SET PLUMB, PROTRUDING 3 INCHES ABOVE SILT-SAND ON RIGHT SHORE OF UMAQUA RIVER. 1961 MOUND OF STONE IS COMPLETELY BURIED IN SAND (CANNOT MEASURE).

MONUMENT DETAIL

U. S. DEPT. OF THE INTERIOR

W P

528 | 527

1961

BUR. OF LAND MANAGEMENT

Accessories Found

NO BEARING TREES WERE MARKED WHEN MONUMENT WAS ORIGINALLY SET IN 1961

THE TWO 1966 RENEWAL BEARING TREES:

A 12" D. FIR NOW A 28 INCH DIAMETER DOUGLAS FIR WITH A FULLY HEALED DOUBLE BLAZE; BEARS S12°W, 52<sup>2</sup> FEET DISTANT (AS PER RECORD).

A 16" MYRTLE NOW A 20 INCH DIAM. MYRTLE WITH A FULLY HEALED DOUBLE BLAZE; BEARS S26°E, 65<sup>2</sup> FEET DISTANT (AS PER RECORD).

C.S. File 67/41-43

RENEWAL

Monument Set (Procedure and Description)

MONUMENT DETAIL

N/A


N/A

New Accessories

TWO SYMBOLS ARE SCRIBED IN ROCKS ON UMPQUA RIVER'S RIGHT SHORE: AN APPROXIMATELY 3 1/2 INCH DIAM "O" NEAR THE HIGH-POINT OF 6 FOOT, BY 6 FOOT, BY 20 FOOT LONG ROCK LEDGE BEARS N 51 1/4 ° E, 33 ° FEET DISTANT. AN APPROXIMATELY 5 X 5 INCH "X" ON A FLAT TOP AT THE EASTERLY END OF A 9 FOOT, BY 9 FOOT, BY 12 FOOT LONG BOULDER; BEARS N 24 1/4 ° W, 30 ° FEET DISTANT.

Sketch of Monument, Accessories, and General Area

Location & Comments

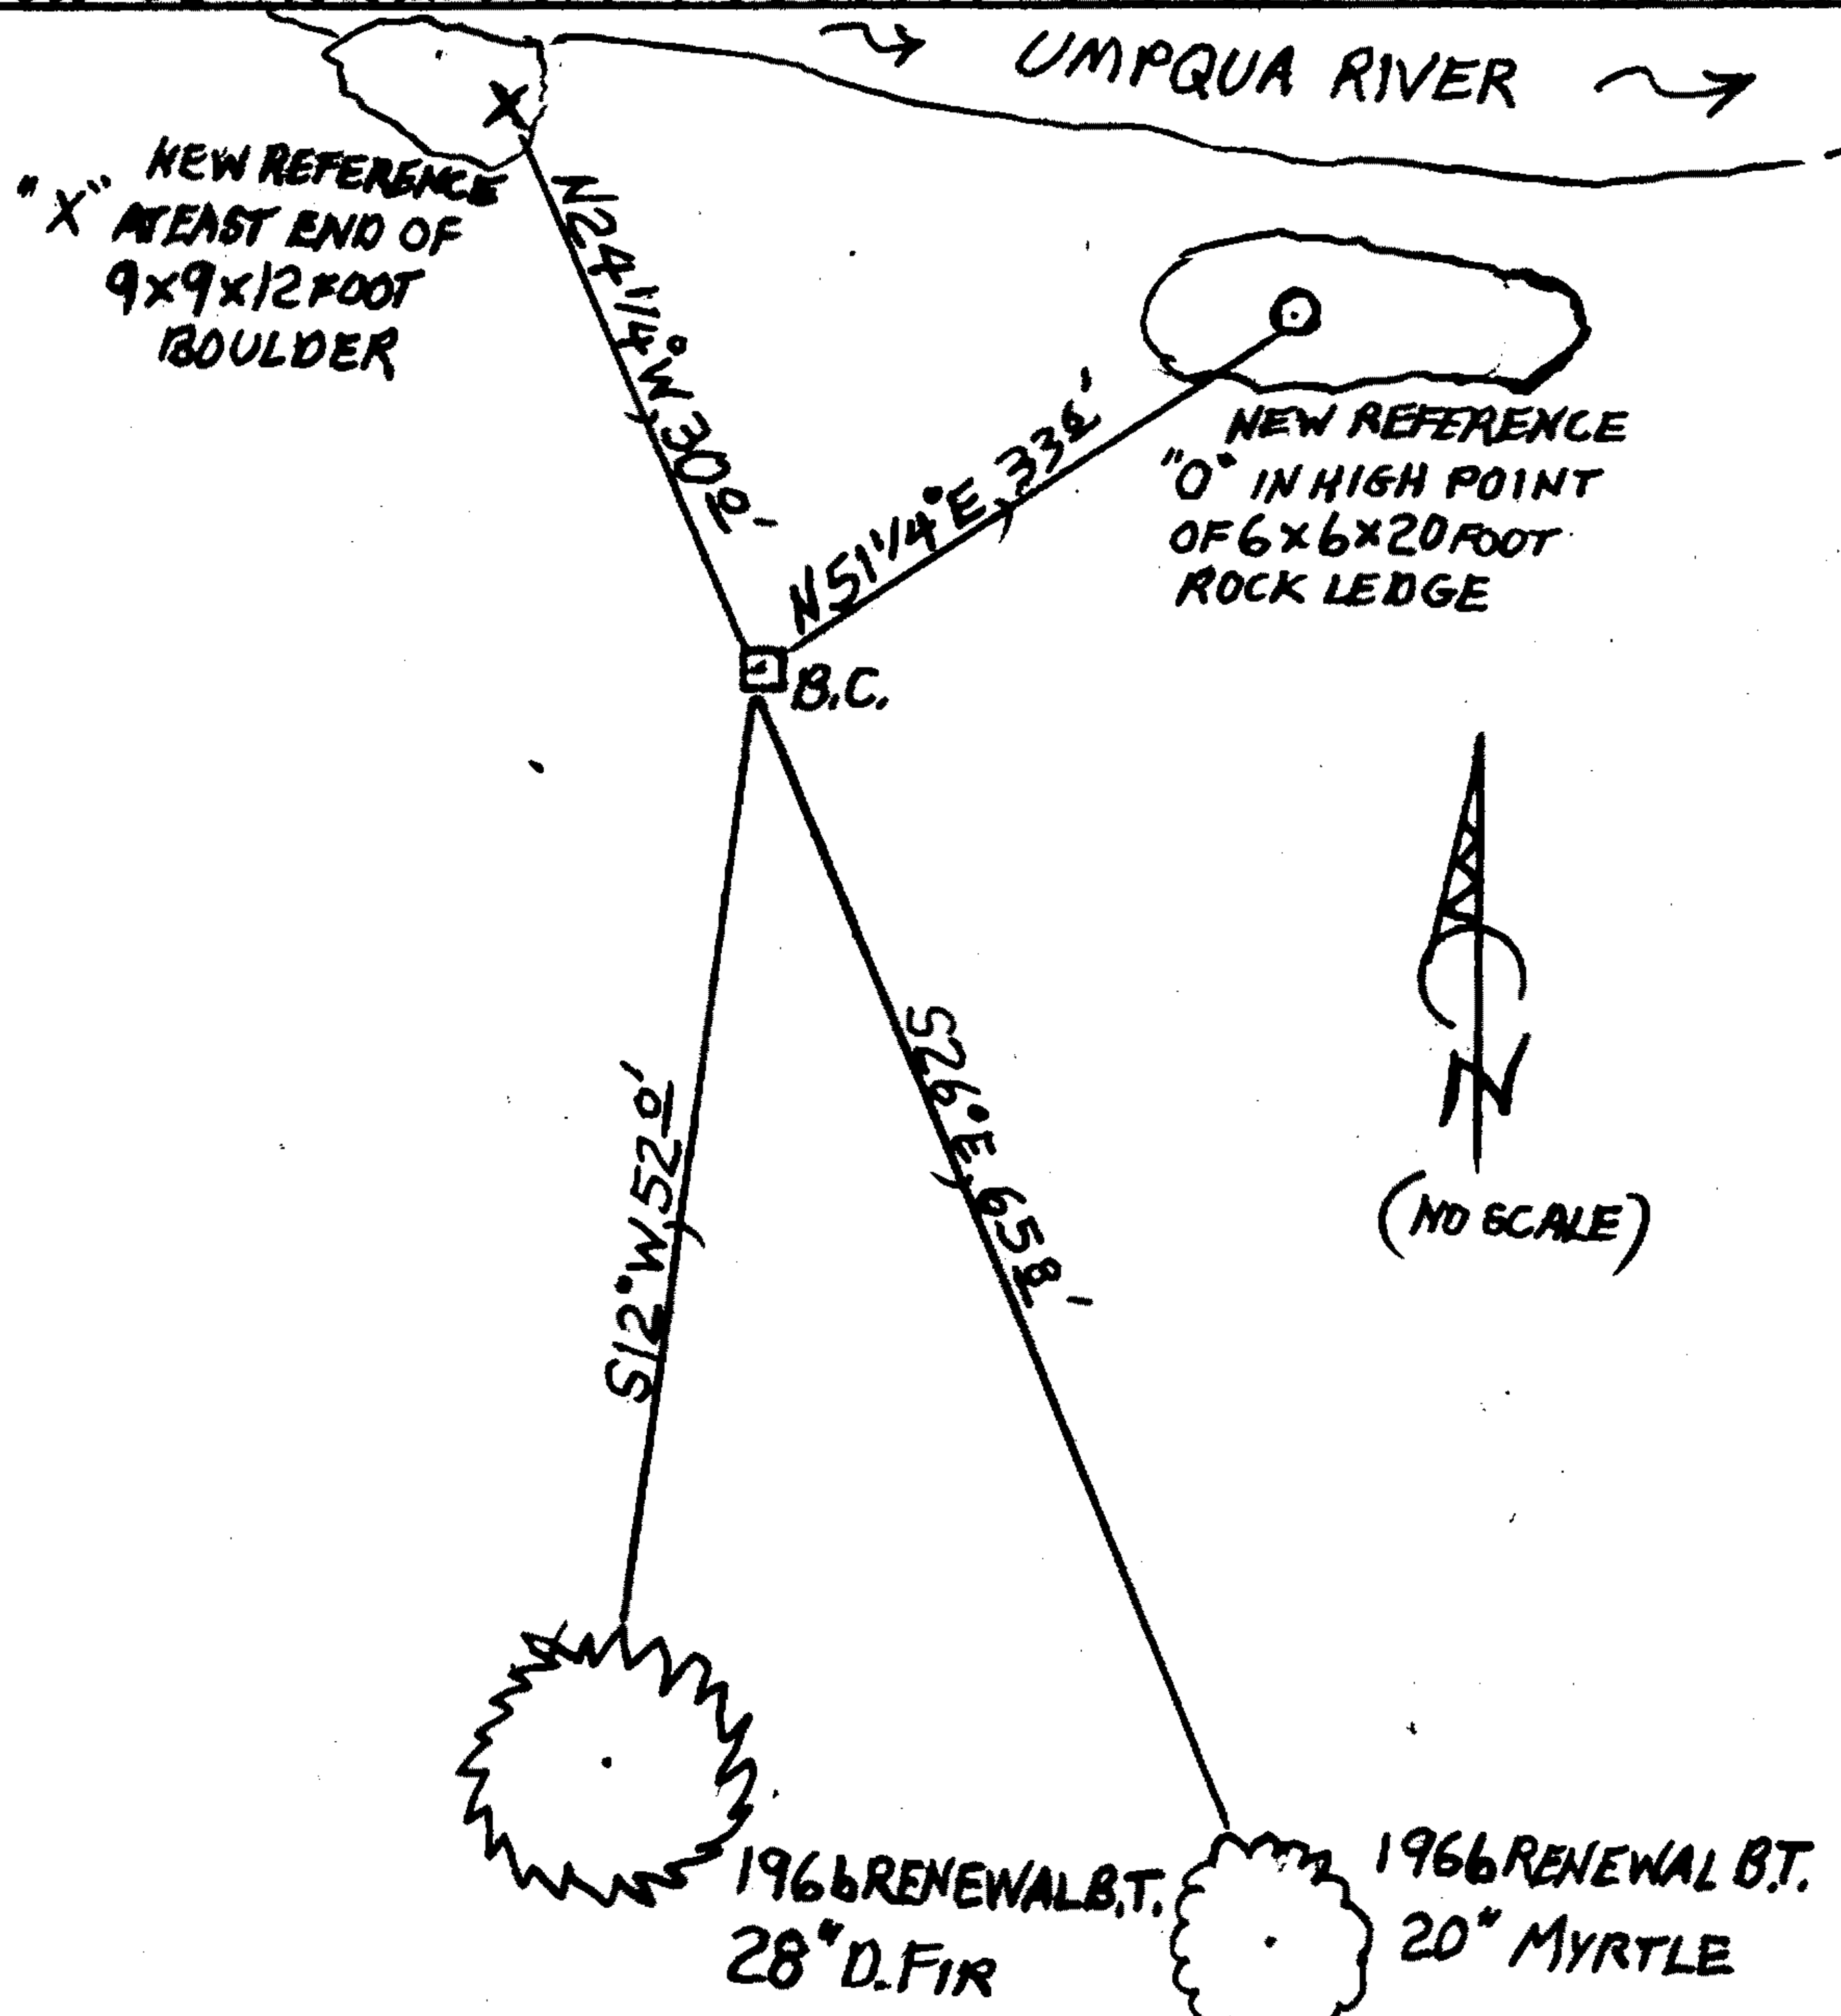

MONUMENT IS IN NARROW SILT-SAND FLOODPLAIN ON SOUTH SHORE (RIGHT BANK) OF THE UMPQUA RIVER. MONUMENT IS SUBJECT TO WASH OUT OR BURIAL IN FUTURE FLOODING.

Comp. Decline. 15 1/2 ° E  
Agency D.C.S.O.  
Party Chief STEPHEN JOHN FLAISE  
Note keeper Stephen John Flaise  
Witnesses MIKE S. KOCH

Surveyor's Seal

REGISTERED PROFESSIONAL LAND SURVEYOR

*Randall W. Smith*

OREGON  
JULY 25, 1980  
RANDALL W. SMITH  
2400

Renewal 6-30-2016