

GOVERNMENT CORNER RESTORATION FORM

FILED

TOWNSHIP 23S RANGE 07W SEC. 23 PLSS # 519300

Date: 9-15-2014 By: JC

This survey consists of:

DOUGLAS COUNTY OREGON

DATE AUG. 11, 2014

Map: _____

Narrative: _____

Corner Rpt: CS 67/41-44

Corner Designation

DOUGLAS COUNTY
SURVEYOR

MC 523
526

- Condition Report
- Not Found
- Renewed
- Unrecorded
- Surveyed In
- Referenced Out

Previous Renewals MC REESTB. 1959-61 (HAINES)
Monument(s) Found: (Condition and Source)

MONUMENT DETAIL

FROM THE 1959-61 REESTABLISHMENT HAINES
SURVEY AN APPROXIMATELY 3 x 3 INCH "X" SCRIBED
IN TOP OF THE EXPOSED PORTION OF A ROCK WHICH
MEASURES APPROX 3 FEET BY 4 FEET BY 6 FEET.
A STEEL "PK" NAIL WITH A 1/2 INCH DIAM. TOP IS DRIV-
EN IN CENTER OF FOUND "X" AND PROTRUDES 1/2
INCH ABOVE ROCK SURFACE.

N/A

Accessories Found

NO ORIGINAL BEARING TREE EVIDENCE REMAINS.

THE ONE HAINES 1959-61 BEARING TREE:
A 12" D. FIR NOW A 29 INCH DIAM. DOUGLAS FIR NO LONGER SHOWING BLAZE EVIDENCE;
BEARS N48°W, 68 FEET DISTANT (AS PER RECORD).

C.S. File 67/41-44

Monument Set (Procedure and Description)

MONUMENT DETAIL

N/A

N/A

New Accessories

THREE NEW BEARING TREES:

A 10 INCH DIAM. MADRONE SCRIBED "WCS23CS" "BT" ON A DOUBLE BLAZE; BEARS N50 1/2° E, 17 2 FEET DISTANT.


AN 18 INCH DIAM. DOUGLAS FIR SCRIBED "WCS26CS" "BT" ON A DOUBLE BLAZE; BEARS S07 1/2° E, 29 4 FEET DISTANT.

A 9 INCH DIAM. MYRTLE (MOST EASTERLY TRUNK OF A MULTI-TRUNK TREE) SCRIBED "X" "CSBT" ON A HIGH-LOW BLAZE. THE CENTER OF THE ROOT-CROWN OF THE MULTI-TRUNK BEARS S52 1/2° W, 17 0 FEET DISTANT.

ALSO A 2 INCH WIDE "U" SHAPED GALVANIZED STEEL POST PROTRUDING 4 5 FEET ABOVE GROUND; BEARS N88° E, 4 9 FEET DISTANT.

Sketch of Monument, Accessories, and General Area

Location & Comments

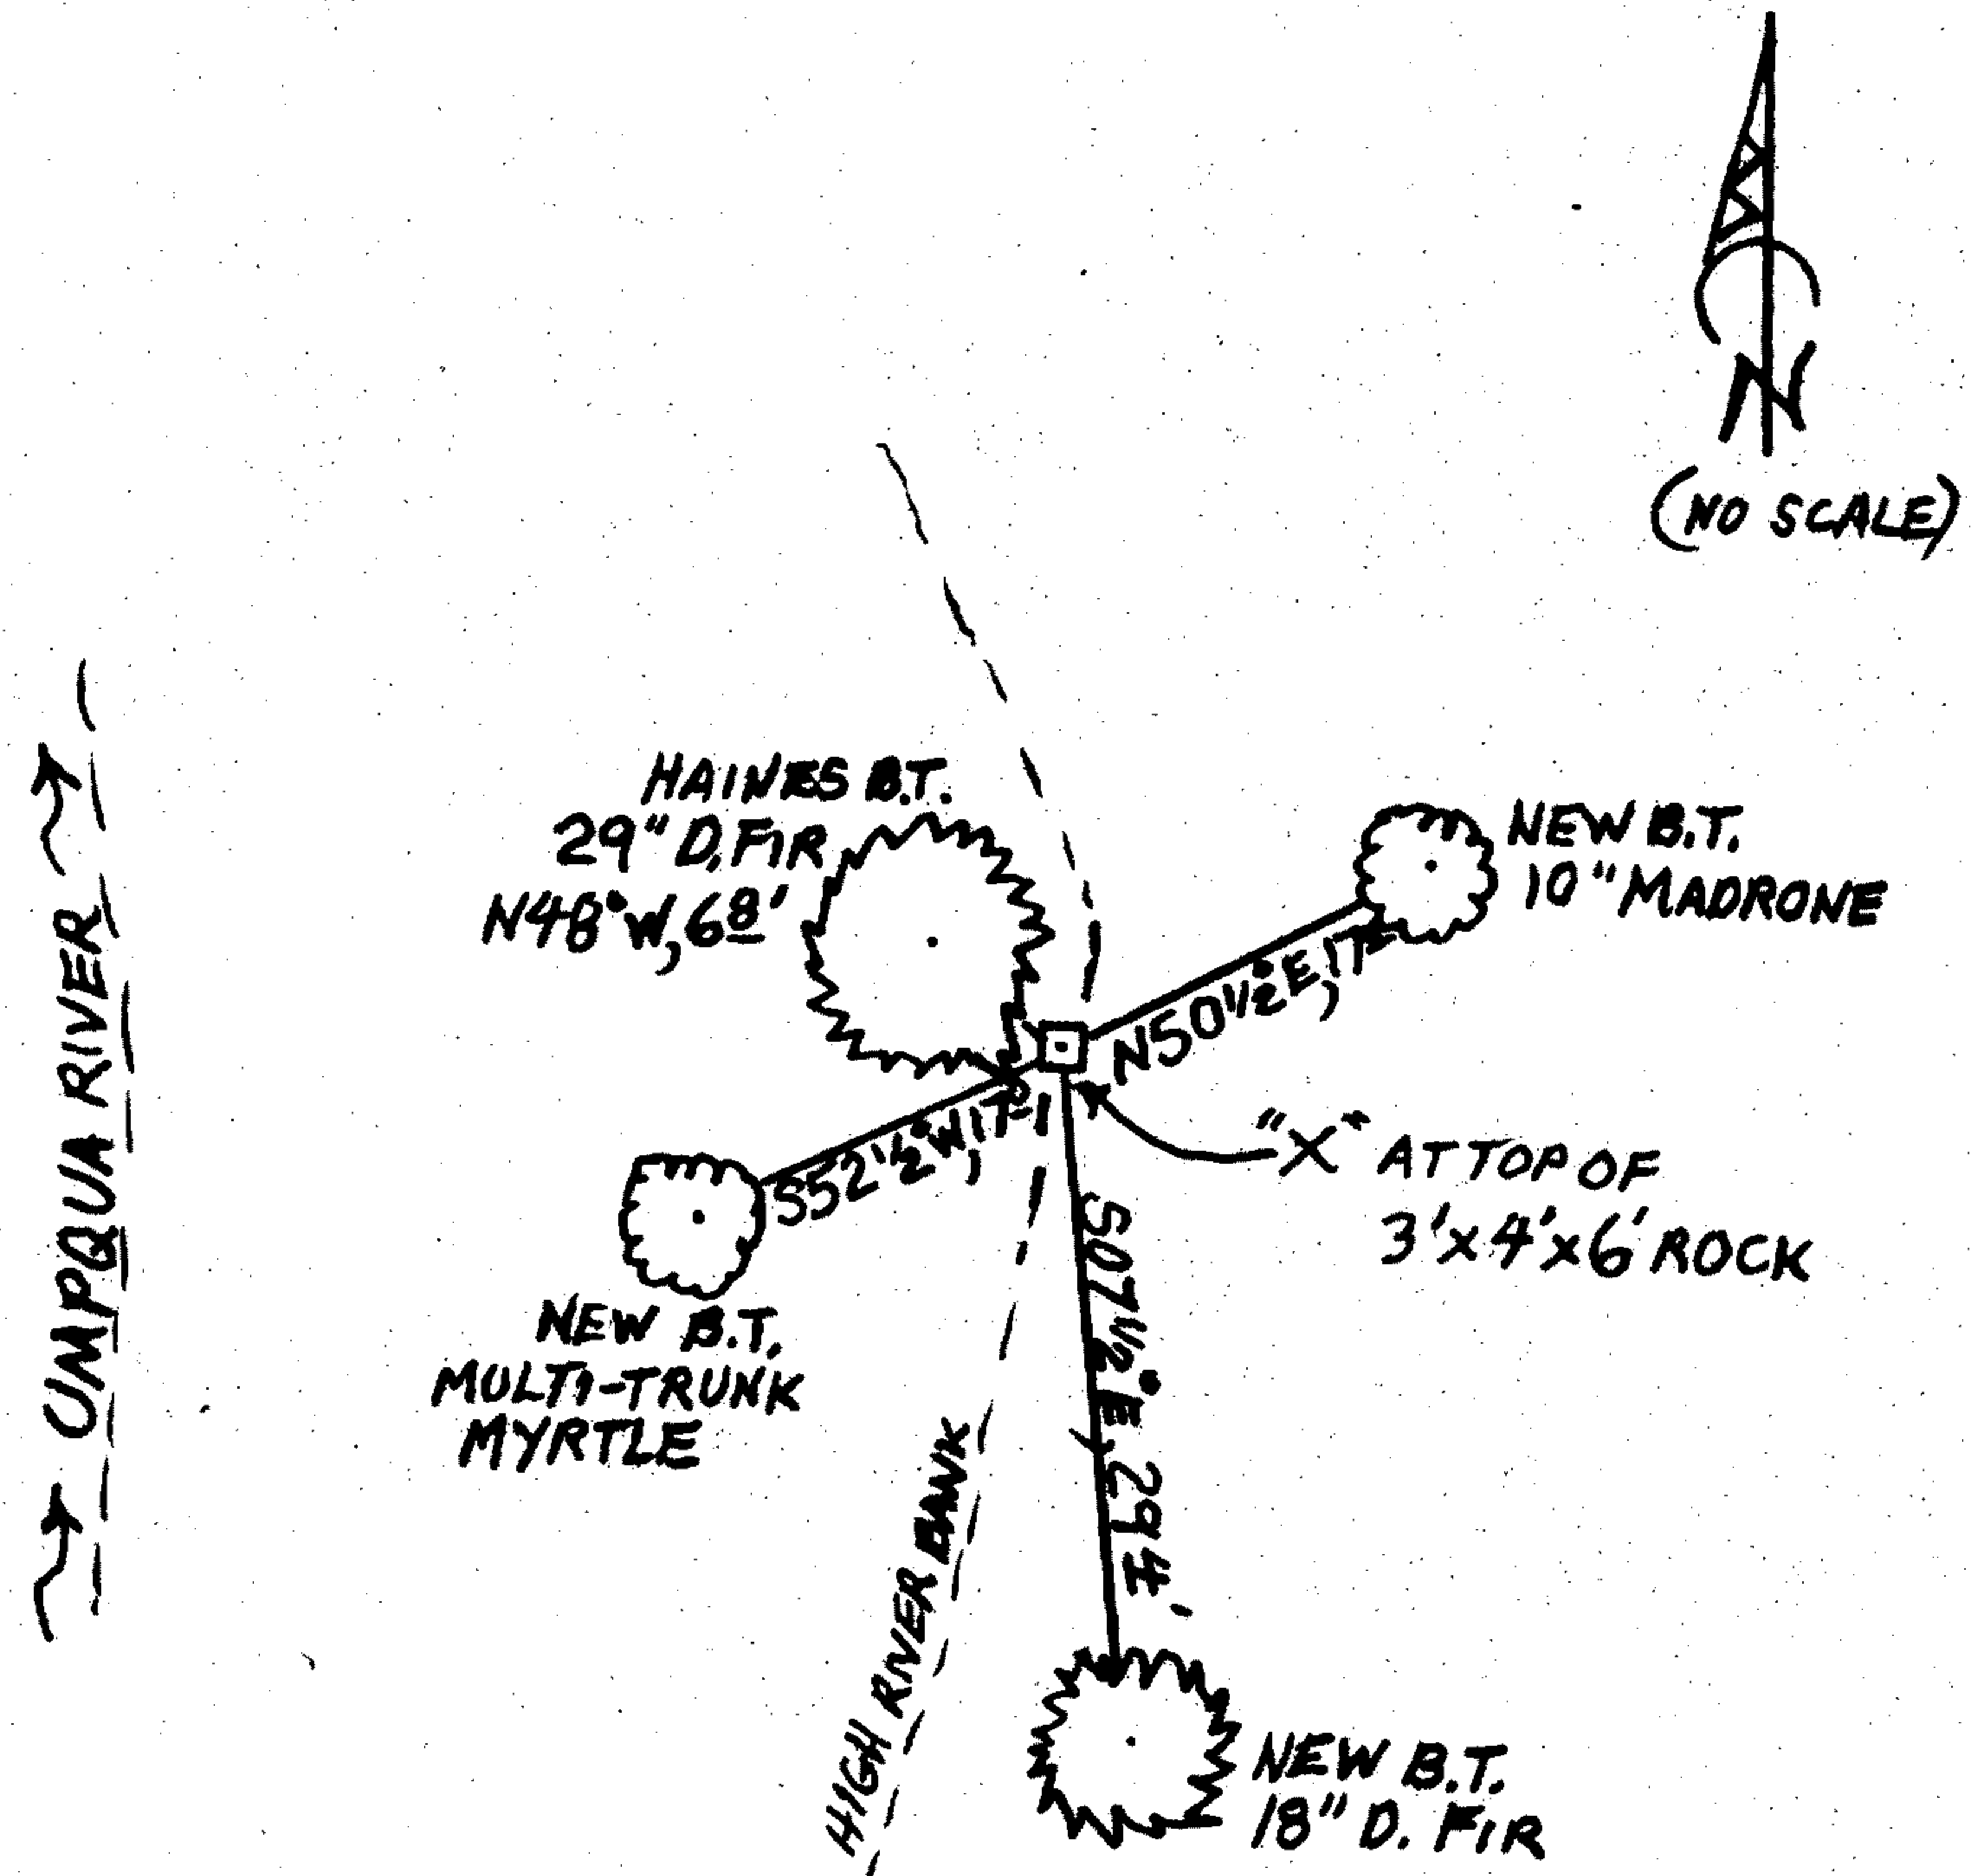

MONUMENT IS ON TOP OF HIGHEST RIGHT BANK OF THE UMPQUA RIVER IN OLDER MIXED FOREST OF FIR, MADRONE, MYRTLE AND OAK.

Comp. Decline. 15 1/2° E
 Agency D.C.S.O.
 Party Chief STEPHEN JOHN FLAUSE
 Note keeper Stephen John Flause
 Witnesses MIKE S. KOCH

Surveyor's Seal

REGISTERED
 PROFESSIONAL
 LAND SURVEYOR

Handwritten signature of Randall W. Smith

OREGON
 JULY 25, 1990
 RANDALL W. SMITH
 2400