

GOVERNMENT CORNER RESTORATION FORM

FILED

TOWNSHIP 24S RANGE 07W SEC. 4 PLSS # 340700

Date: 9/15/2014 By: JC
This survey consists of:

DOUGLAS COUNTY OREGON

DATE AUG. 13, 2014

Map: _____

Corner Designation

Narrative: _____

Corner Rpt: CS 67/41-47

DOUGLAS COUNTY
SURVEYOR

1/4 ———
S4 ONLY

- _____ Condition Report
- _____ Not Found
- Renewed
- _____ Unrecorded
- _____ Surveyed In
- _____ Referenced Out

Previous Renewals ESTABLISHED IN RESURVEY 1976, RENEWAL 1980
Monument(s) Found: (Condition and Source)

MONUMENT DETAIL

PLS 1038
T23S R7W
S4 1/4
T24S R7W
1980

1976 5/8" REBAR NOT SEEN.

FROM THE 1980 RENEWAL A 2 1/2 INCH DIAMETER BRASS CAP (MARKED AS AT RIGHT) ON A 1 1/2 INCH I.D. IRON PIPE SET PLUMB, PROTRUDING 7 INCHES ABOVE GROUND.

Accessories Found

EVIDENCE OF ONE 1976 ORIGINAL BEARING TREE:
A 32 INCH FIR NOW A ROTTED 30 INCH DIAM, 1 1/2 FOOT TALL FIR STUMP WITH NO BLAZE EVIDENCE REMAINING; BEARS S08°E, 412 FEET DISTANT (RECORD S12°E, 412 FT).
THE SW BEARING TREE POSITION NOW FALLS IN A SKID ROAD; NO EVIDENCE REMAINS.

THE ONE 1980 RENEWAL BEARING TREE:
A 20" W. FIR NOW A 33 INCH DIAM. GRAND FIR WITH A FULLY HEALED DOUBLE BLAZE; BEARS N88°W, 208 FEET DISTANT (AS PER RECORD).

Monument Set (Procedure and Description)

MONUMENT DETAIL

N/A

N/A

New Accessories

THREE NEW RENEWAL BEARING TREES:



A 16 INCH DIAM. GRAND FIR SCRIBED "1/4 S4CS" "BT" ON A DOUBLE BLAZE; BEARS S52 1/2° E, 98 FEET DISTANT

A 14 INCH DIAM. DOUGLAS FIR SCRIBED "1/4 S4" "CSBT" ON A DOUBLE BLAZE; BEARS S03° E, 20 FEET DISTANT

A 10 INCH DIAM. DOUGLAS FIR SCRIBED "1/4 S4CS" "BT" ON A DOUBLE BLAZE; BEARS S38 1/4° W, 38 FEET DISTANT.

Sketch of Monument, Accessories, and General Area (SKETCH SHOWS LIVE TREES ONLY)


Location & Comments

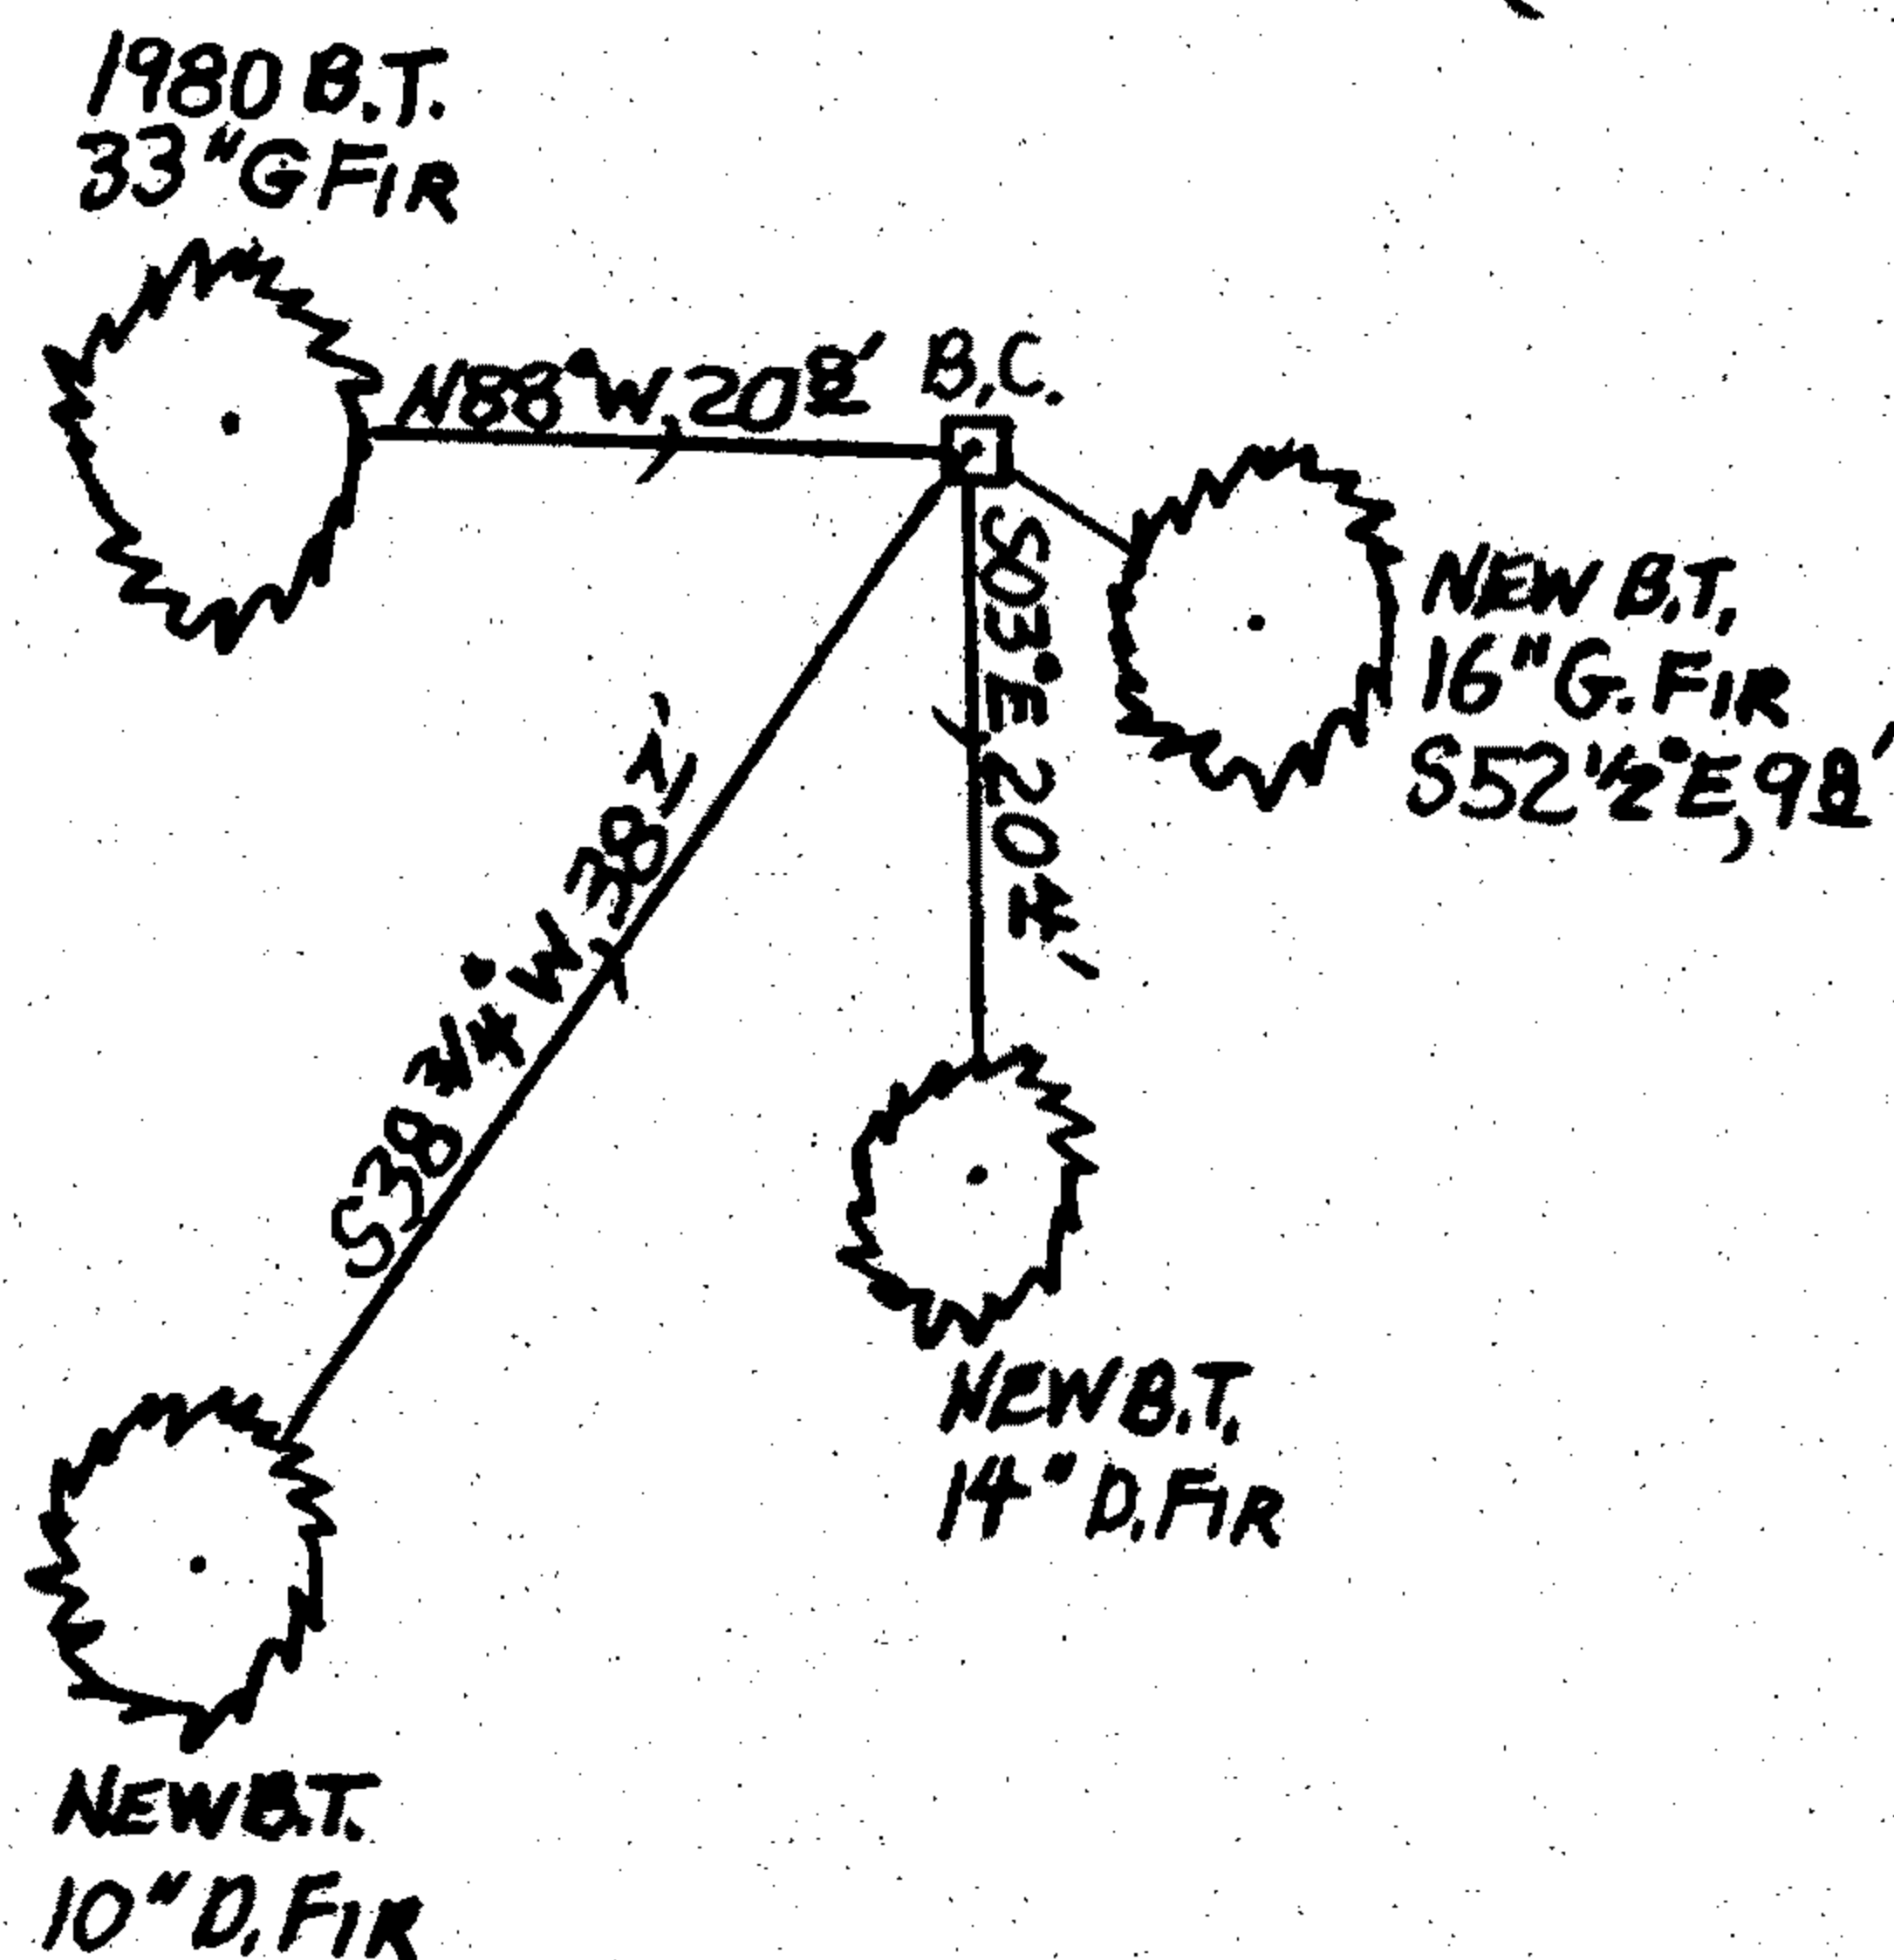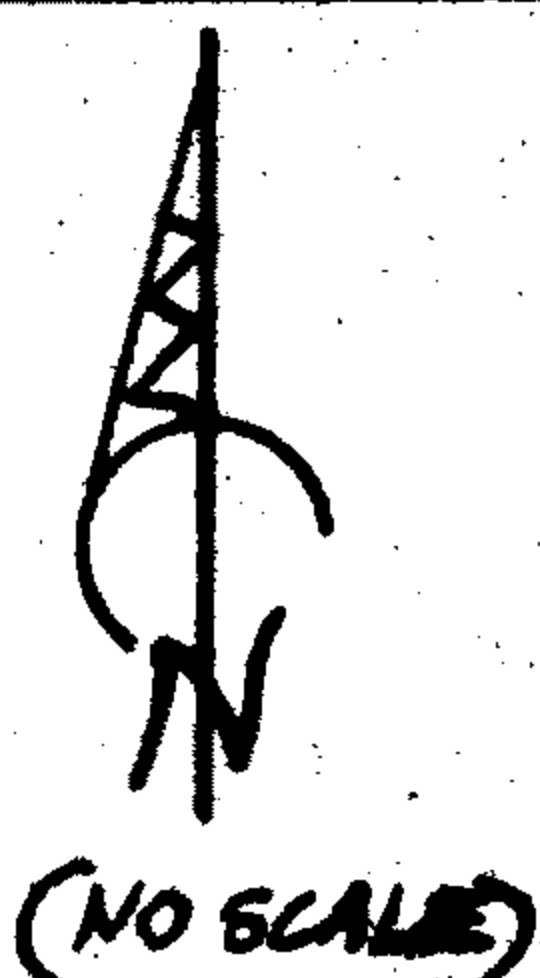

MONUMENT IS IN OLD GROWTH MIXED FIR FOREST WITH 30+ YEAR OLD FIR REPROD. TO SOUTH. MONUMENT IS ON GENTLE WEST SLOPE.

Comp. Decline. 15 1/2° E
Agency D.C.S.O.
Party Chief STEPHEN JOHN FLAISE
Note keeper Stephen John Flaese
Witnesses MIKE S. KOCH

Surveyor's Seal

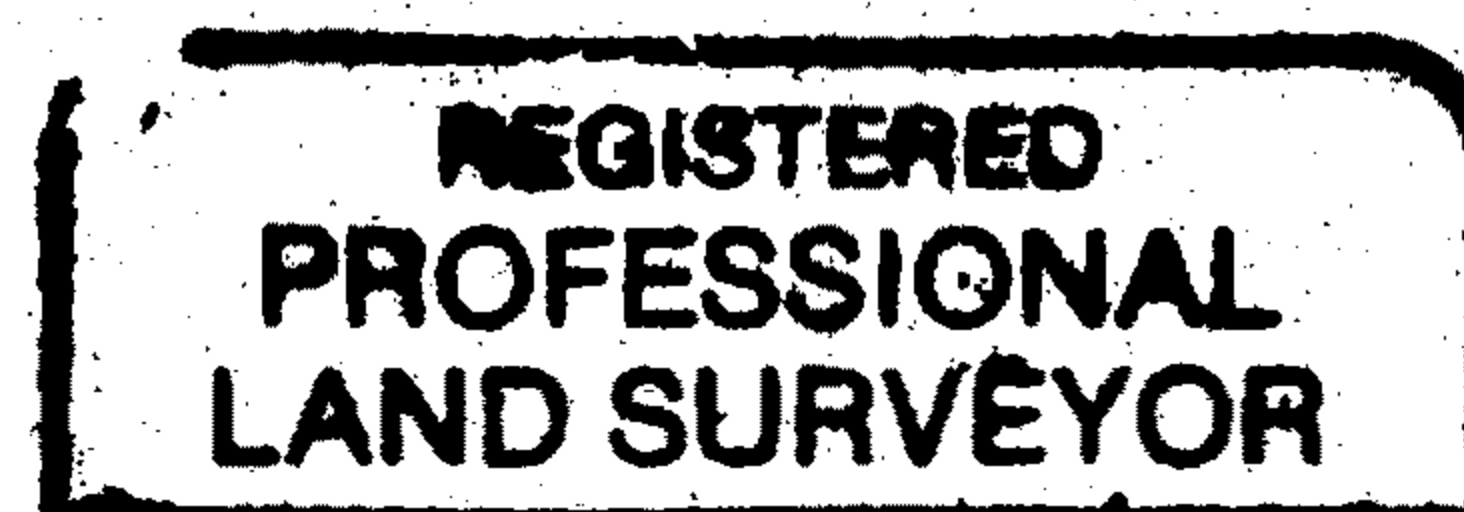

Handwritten signature of Randall W. Smith

