

GOVERNMENT CORNER RESTORATION FORM

FILED

TOWNSHIP 24 S RANGE 07 W SEC. 3 PLSS # 400640

Date: 9-15-2014 By: JC
This survey consists of:

DOUGLAS COUNTY OREGON

DATE AUG. 15, 2014

Map: _____

Narrative: _____

Corner Rpt: CS 67/41-49

Corner Designation

DOUGLAS COUNTY
SURVEYOR

$\frac{1}{4}$
S4 | S3

- _____ Condition Report
- _____ Not Found
- Renewed
- _____ Unrecorded
- _____ Surveyed In
- _____ Referenced Out

Previous Renewals REESTB. 1976
Monument(s) Found: _____ (Condition and Source)

MONUMENT DETAIL

FROM THE 1976 SURVEY REESTABLISHING CORNER:
A 5/8 INCH DIAMETER IRON ROD IS SET PLUMB
PROTRUDING 2 INCHES ABOVE GROUND.

N/A

Accessories Found

STUMPS IN AREA WERE SEARCHED FOR ORIGINAL BEARING TREE EVIDENCE, NONE WAS FOUND.

FROM THE 1976 SURVEY ONE BEARING TREE:
A 12" FIR NOW A 23 INCH DIAM. DOUGLAS FIR WITH ~~WITH~~ A FULLY HEALED SINGLE BLAZE;
BEARS S53°E, 74 FEET DISTANT.
THE OTHER 1976 B.T. POSITION FALLS IN AN EXCAVATED LOG LANDING NO EVIDENCE REMAINS.

C.S. File 67/41-49

Monument Set (Procedure and Description)

MONUMENT DETAIL

N/A

N/A

New Accessories


A 8 INCH DIAM. DOUGLAS FIR SCRIBED "1/4 S3CS" "BT" ON A DOUBLE BLAZE; BEARS N21 1/4° E, 22 1/2 FEET DISTANT.

A 6 INCH DIAM. DOUGLAS FIR SCRIBED "1/4 S4CS" "BT" ON A DOUBLE BLAZE; BEARS S37 1/2° W, 7 1/2 FEET DISTANT.

A 5 INCH DIAM. DOUGLAS FIR SCRIBED "X" "CSBT" ON A HIGH-LOW BLAZE; BEARS N39 3/4° W, 11 1/2 FEET DISTANT.

Sketch of Monument, Accessories, and General Area

Location & Comments

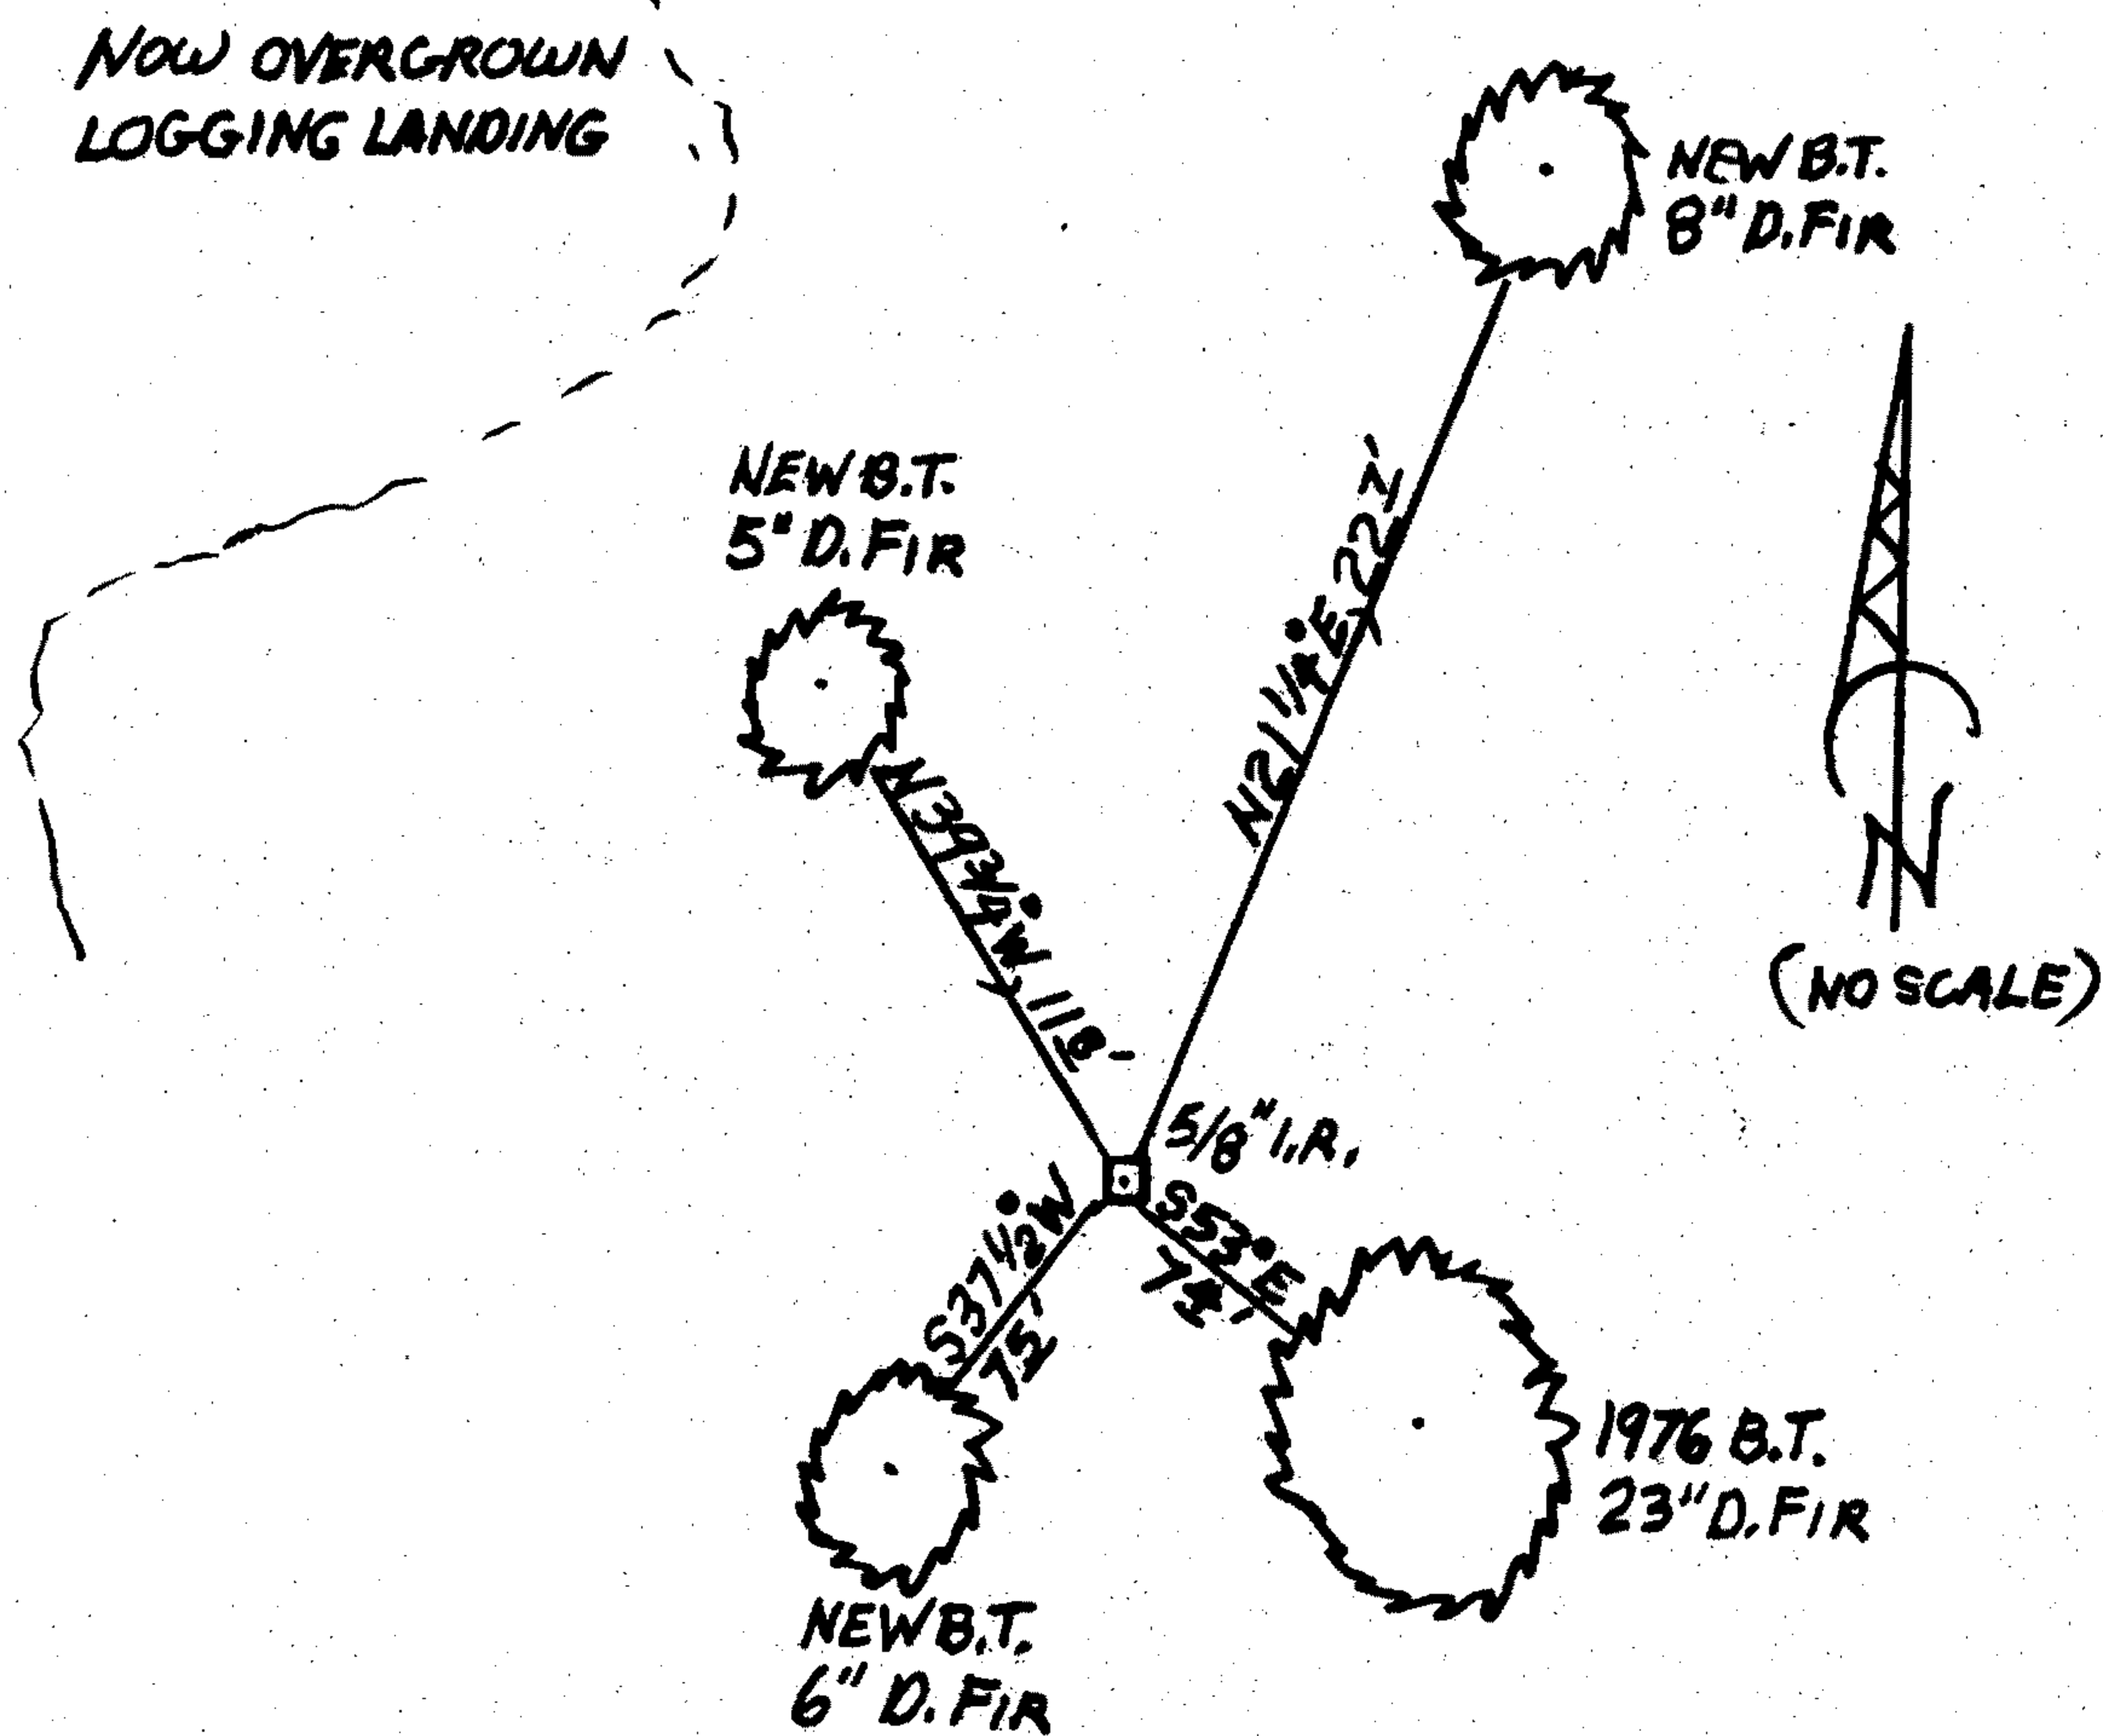

MONUMENT IS NEAR SE CORNER OF OLD LOGGING LANDING AT END OF A FOREST SPUR ROAD AND AT TOP OF A VERY STEEP WEST SLOPE. OLD GROWTH TIMBER TO SOUTH, YOUNG REPROD FIR TO NORTH

Comp. Decline. 15 1/2° E
Agency D.C.S.O.
Party Chief STEPHEN JOHN FLAUSE
Note keeper Stephen John Flause
Witnesses MIKE S. KOCH

Surveyor's Seal

REGISTERED PROFESSIONAL LAND SURVEYOR

Randall W. Smith

OREGON
JULY 25, 1999
RANDALL W. SMITH
2489

RENEWAL 6-30-2016