

GOVERNMENT CORNER RESTORATION FORM

FILED

TOWNSHIP 24S RANGE 07W SEC. 16 PLSS # 340400

Date: 9-15-2014 By: JC
This survey consists of:

DOUGLAS COUNTY OREGON

DATE AUG. 20, 2014

Map: _____

Corner Designation

Narrative: _____

Corner Rpt: CS 67/41-52

DOUGLAS COUNTY
SURVEYOR

$\frac{1}{4}$ $\frac{S16}{S21}$

- _____ Condition Report
- _____ Not Found
- Renewed
- _____ Unrecorded
- _____ Surveyed In
- _____ Referenced Out

Previous Renewals REESTB. 1970
Monument(s) Found: (Condition and Source)

THE 1970 PROPORTIONED IN CORNER MONUMENT:
A 5/8 INCH DIAMETER BRASS ROD SET PLUMB
AND PROTRUDING 3 INCHES ABOVE GROUND.

N/A

MONUMENT DETAIL

Accessories Found

NO EVIDENCE OF C.B.T. OAKS REMAINS IN AREA.

THE NEW BEARING FROM THE 1970 BARNES PROPORTIONED IN CORNER:
A 20" D. FIR NOW A 42 INCH DIAM. DOUGLAS FIR WITH A FULLY HEALED DOUBLE BLAZE;
BEARS S52°W, 130± FEET DISTANT (AS PER RECORD).

C.S. File 67/41-52

Monument Set (Procedure and Description)

MONUMENT DETAIL

N/A

N/A

New Accessories

THREE NEW BEARING TREES:


A 16 INCH DIAM. DOUBLE TRUNK MAPLE (DIAM MEASURED AT 3 FT. HEIGHT) SCRIBED "1/4 S16" "CS BT" ON A DOUBLE BLAZE (UPPER BLAZE IS AT BREAST HEIGHT AND BLAZES ARE ON THE MOST WESTERLY TRUNK); BEARS N67°E, 24 1/2 FEET DISTANT.

A 17 INCH DIAM. BLACK OAK SCRIBED "1/4 S21CS" "BT" ON A DOUBLE BLAZE; BEARS S43°E, 25 1/2 FEET DISTANT.

A 10 INCH DIAM. DOUGLAS FIR SCRIBED "1/4 S16CS" "BT" ON A DOUBLE BLAZE; BEARS N71 1/2°W, 26 1/2 FEET DISTANT.

Sketch of Monument, Accessories, and General Area

Location & Comments

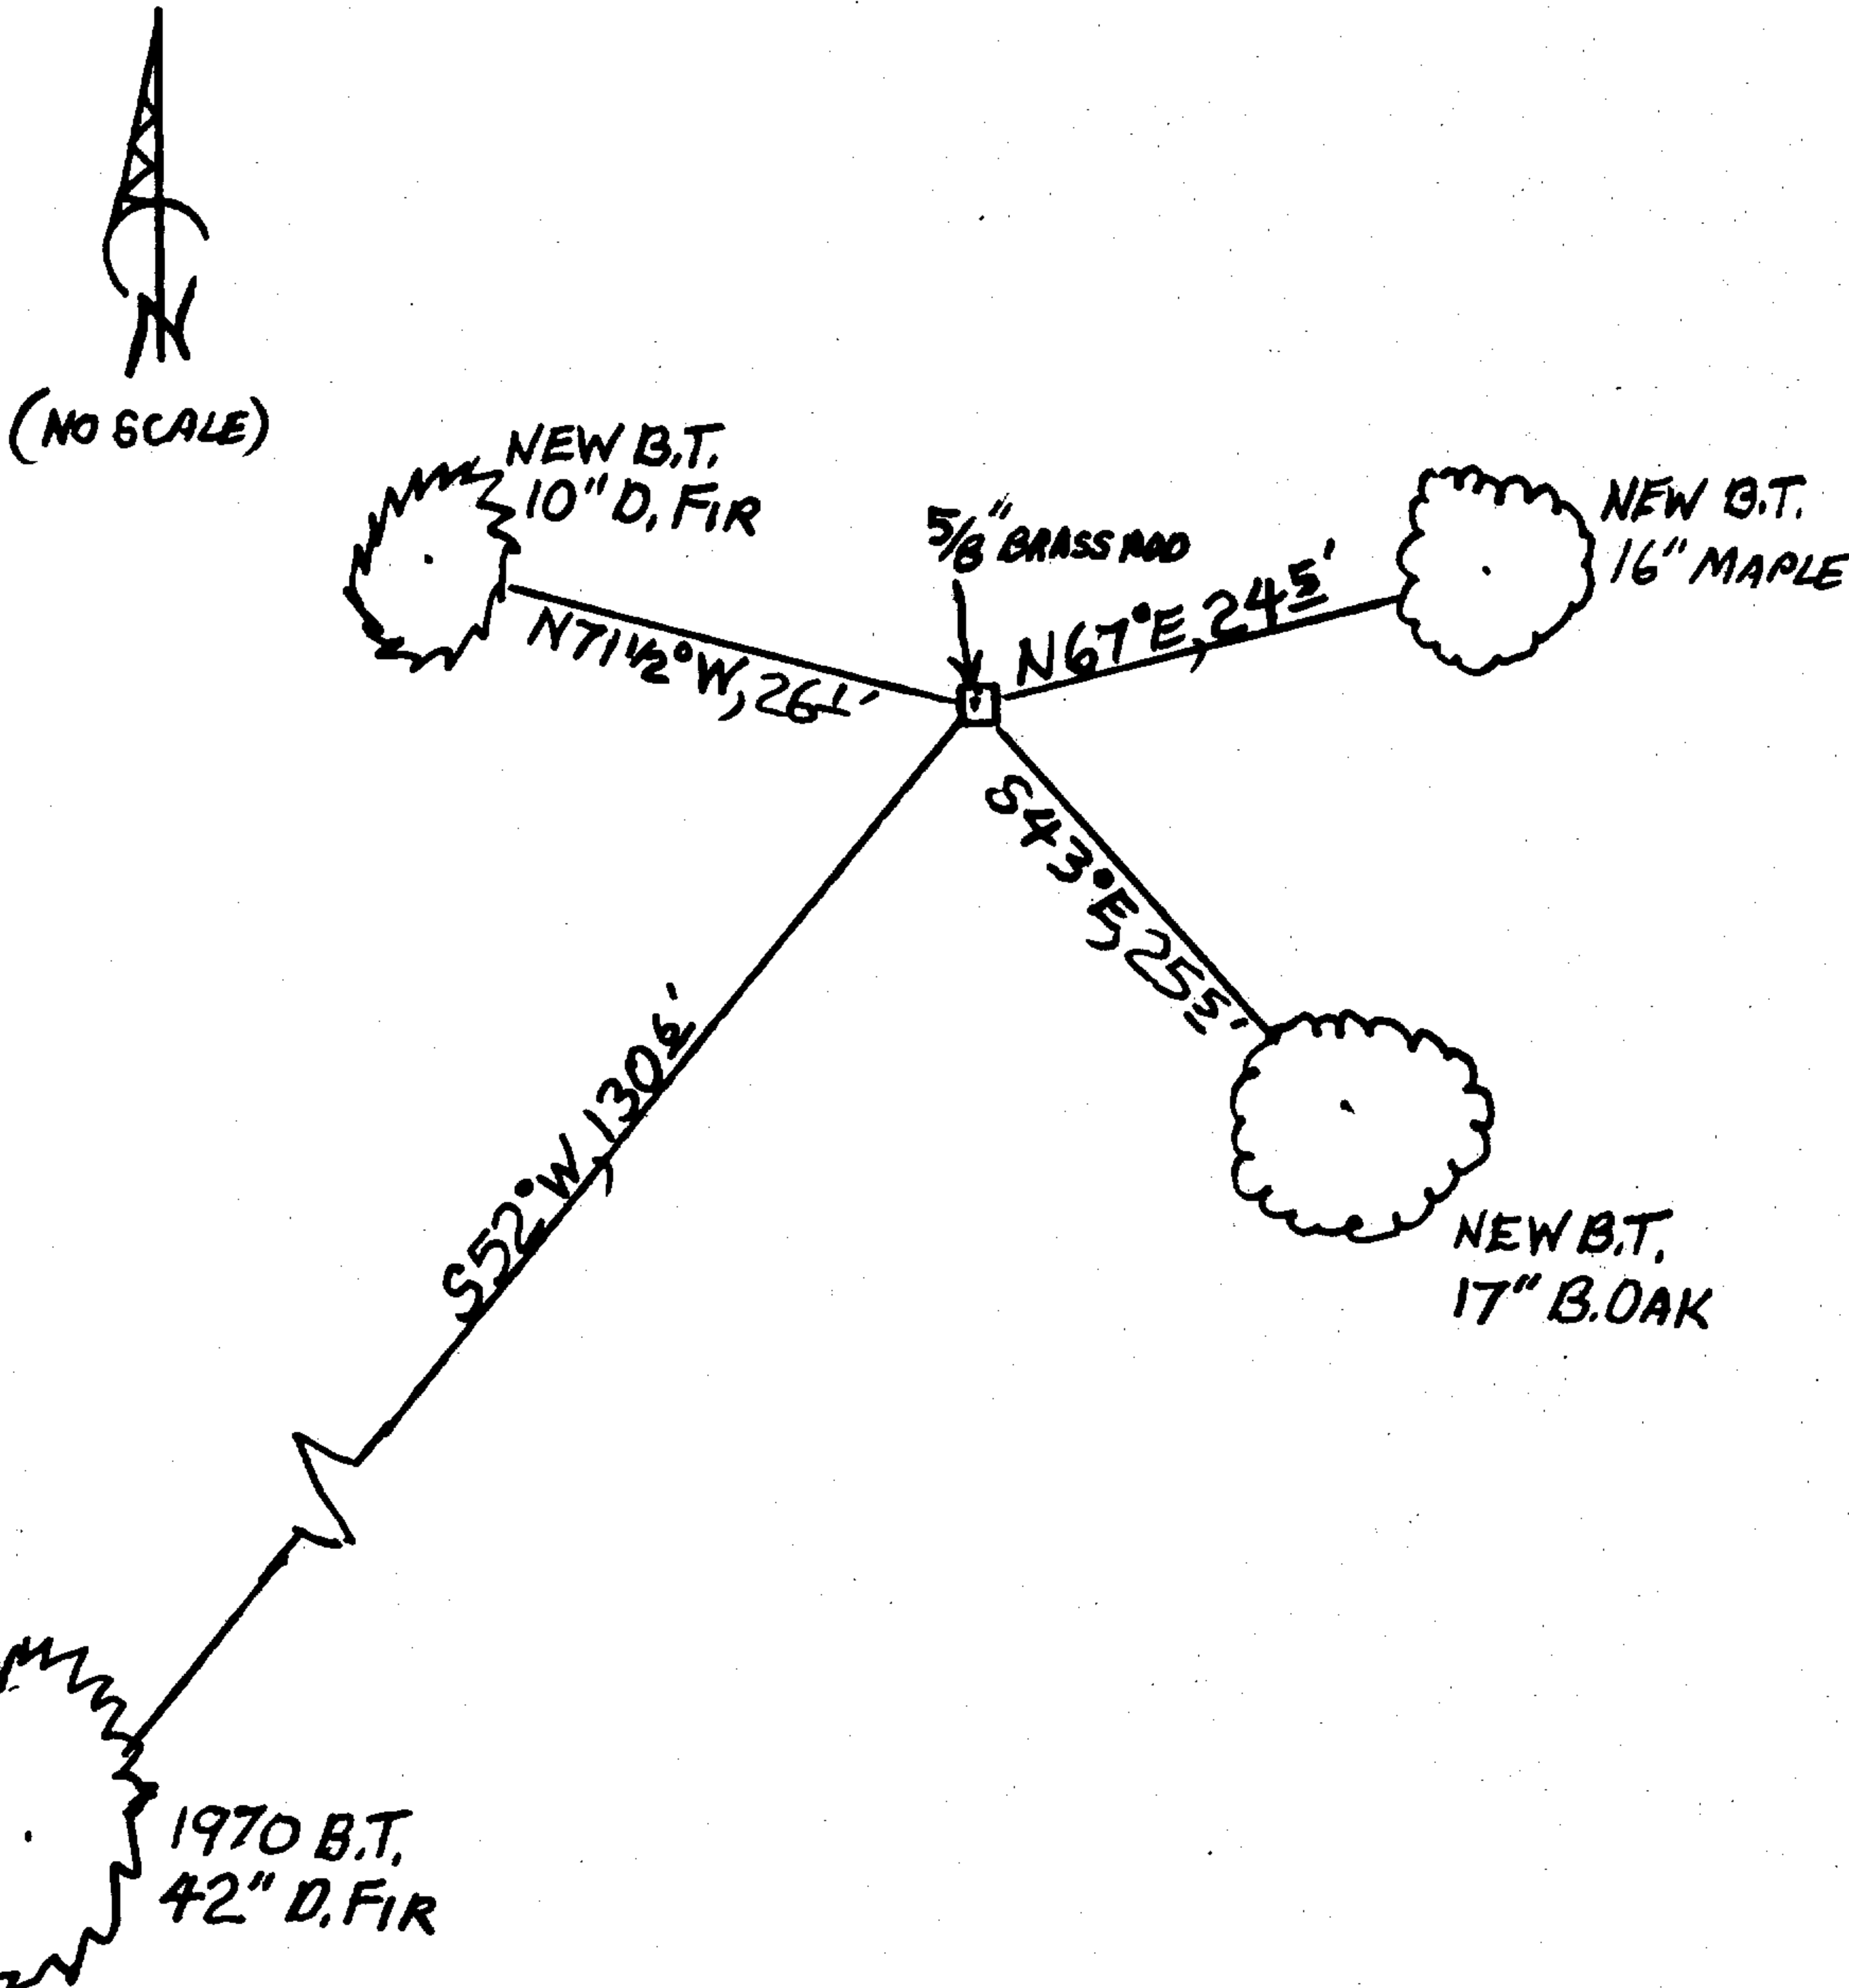

MONUMENT IS ON A MODERATE SOUTHERLY SLOPE IN A MIXED OPEN FOREST OF OLDER FIR MAPLE, OAK AND MADRONE.

Comp. Decline. 15 1/2°E
Agency D.L.S.O.
Party Chief STEPHEN JOHN FRAUSE
Note keeper Stephen John Frause
Witnesses MIKE S. KOCH

Surveyor's Seal

REGISTERED PROFESSIONAL LAND SURVEYOR

Handwritten signature of Randall W. Smith

OREGON
JULY 25, 1999
RANDALL W. SMITH
2488

RENEWAL 6-30-2016