

GOVERNMENT CORNER RESTORATION FORM

FILED

TOWNSHIP 24S RANGE 07W SEC. 17 PLSS # 240440

Date: 9-15-2014 By: X
This survey consists of:

DOUGLAS COUNTY OREGON

DATE AUG. 21, 2014

Map: _____

Corner Designation

Narrative: _____

Corner Rpt: CS 67/41-53

DOUGLAS COUNTY
SURVEYOR

C 1/4 S17

Previous Renewals ESTABLISHED 1976, NO RENEWALS
Monument(s) Found: (Condition and Source)

- _____ Condition Report
- _____ Not Found
- Renewed
- _____ Unrecorded
- _____ Surveyed In
- _____ Referenced Out

THE ORIGINAL MONUMENT FROM THE 1975-76
BLM SURVEY:
A 3/4 INCH DIAMETER BRASS CAP (MARKED AS AT
RIGHT) ON A 2 INCH I.D. IRON PIPE IS SET PLUMB
PROTRUDING 1 INCH ABOVE GROUND.

MONUMENT DETAIL

U. S. DEPT. OF THE INTERIOR
C 1/4 S17
T24S R7W
1976
BUR. OF LAND MANAGEMENT

Accessories Found

THE TWO ORIGINAL 1976 BEARING TREES:
A GRAND FIR 6" DIA. (MISIDENTIFIED SPECIES) NOW A 16 INCH DIAM. DOUGLAS FIR WITH A
FULLY HEALED DOUBLE BLAZE; BEARS S74°W, 21 1/2 FEET DISTANT (AS PER RECORD).
A FIR 8" DIA. NOW A 17 INCH DIAM. DOUGLAS FIR WITH A FULLY HEALED DOUBLE BLAZE;
BEARS N58 1/2°W, 16 3/4 FEET DISTANT (AS PER RECORD).

Monument Set (Procedure and Description)

MONUMENT DETAIL

N/A

N/A

New Accessories


TWO NEW BEARING TREES:

A 14 INCH DOUGLAS FIR SCRIBED "C 1/4 S17CS" "BT" ON A DOUBLE BLAZE; BEARS N 58 1/2° E, 18' FEET DISTANT.

A 13 INCH DOUGLAS FIR SCRIBED "C 1/4 S17" "CSBT" ON A DOUBLE BLAZE; BEARS S 34° E, 13' FEET DISTANT.

Sketch of Monument, Accessories, and General Area

Location & Comments

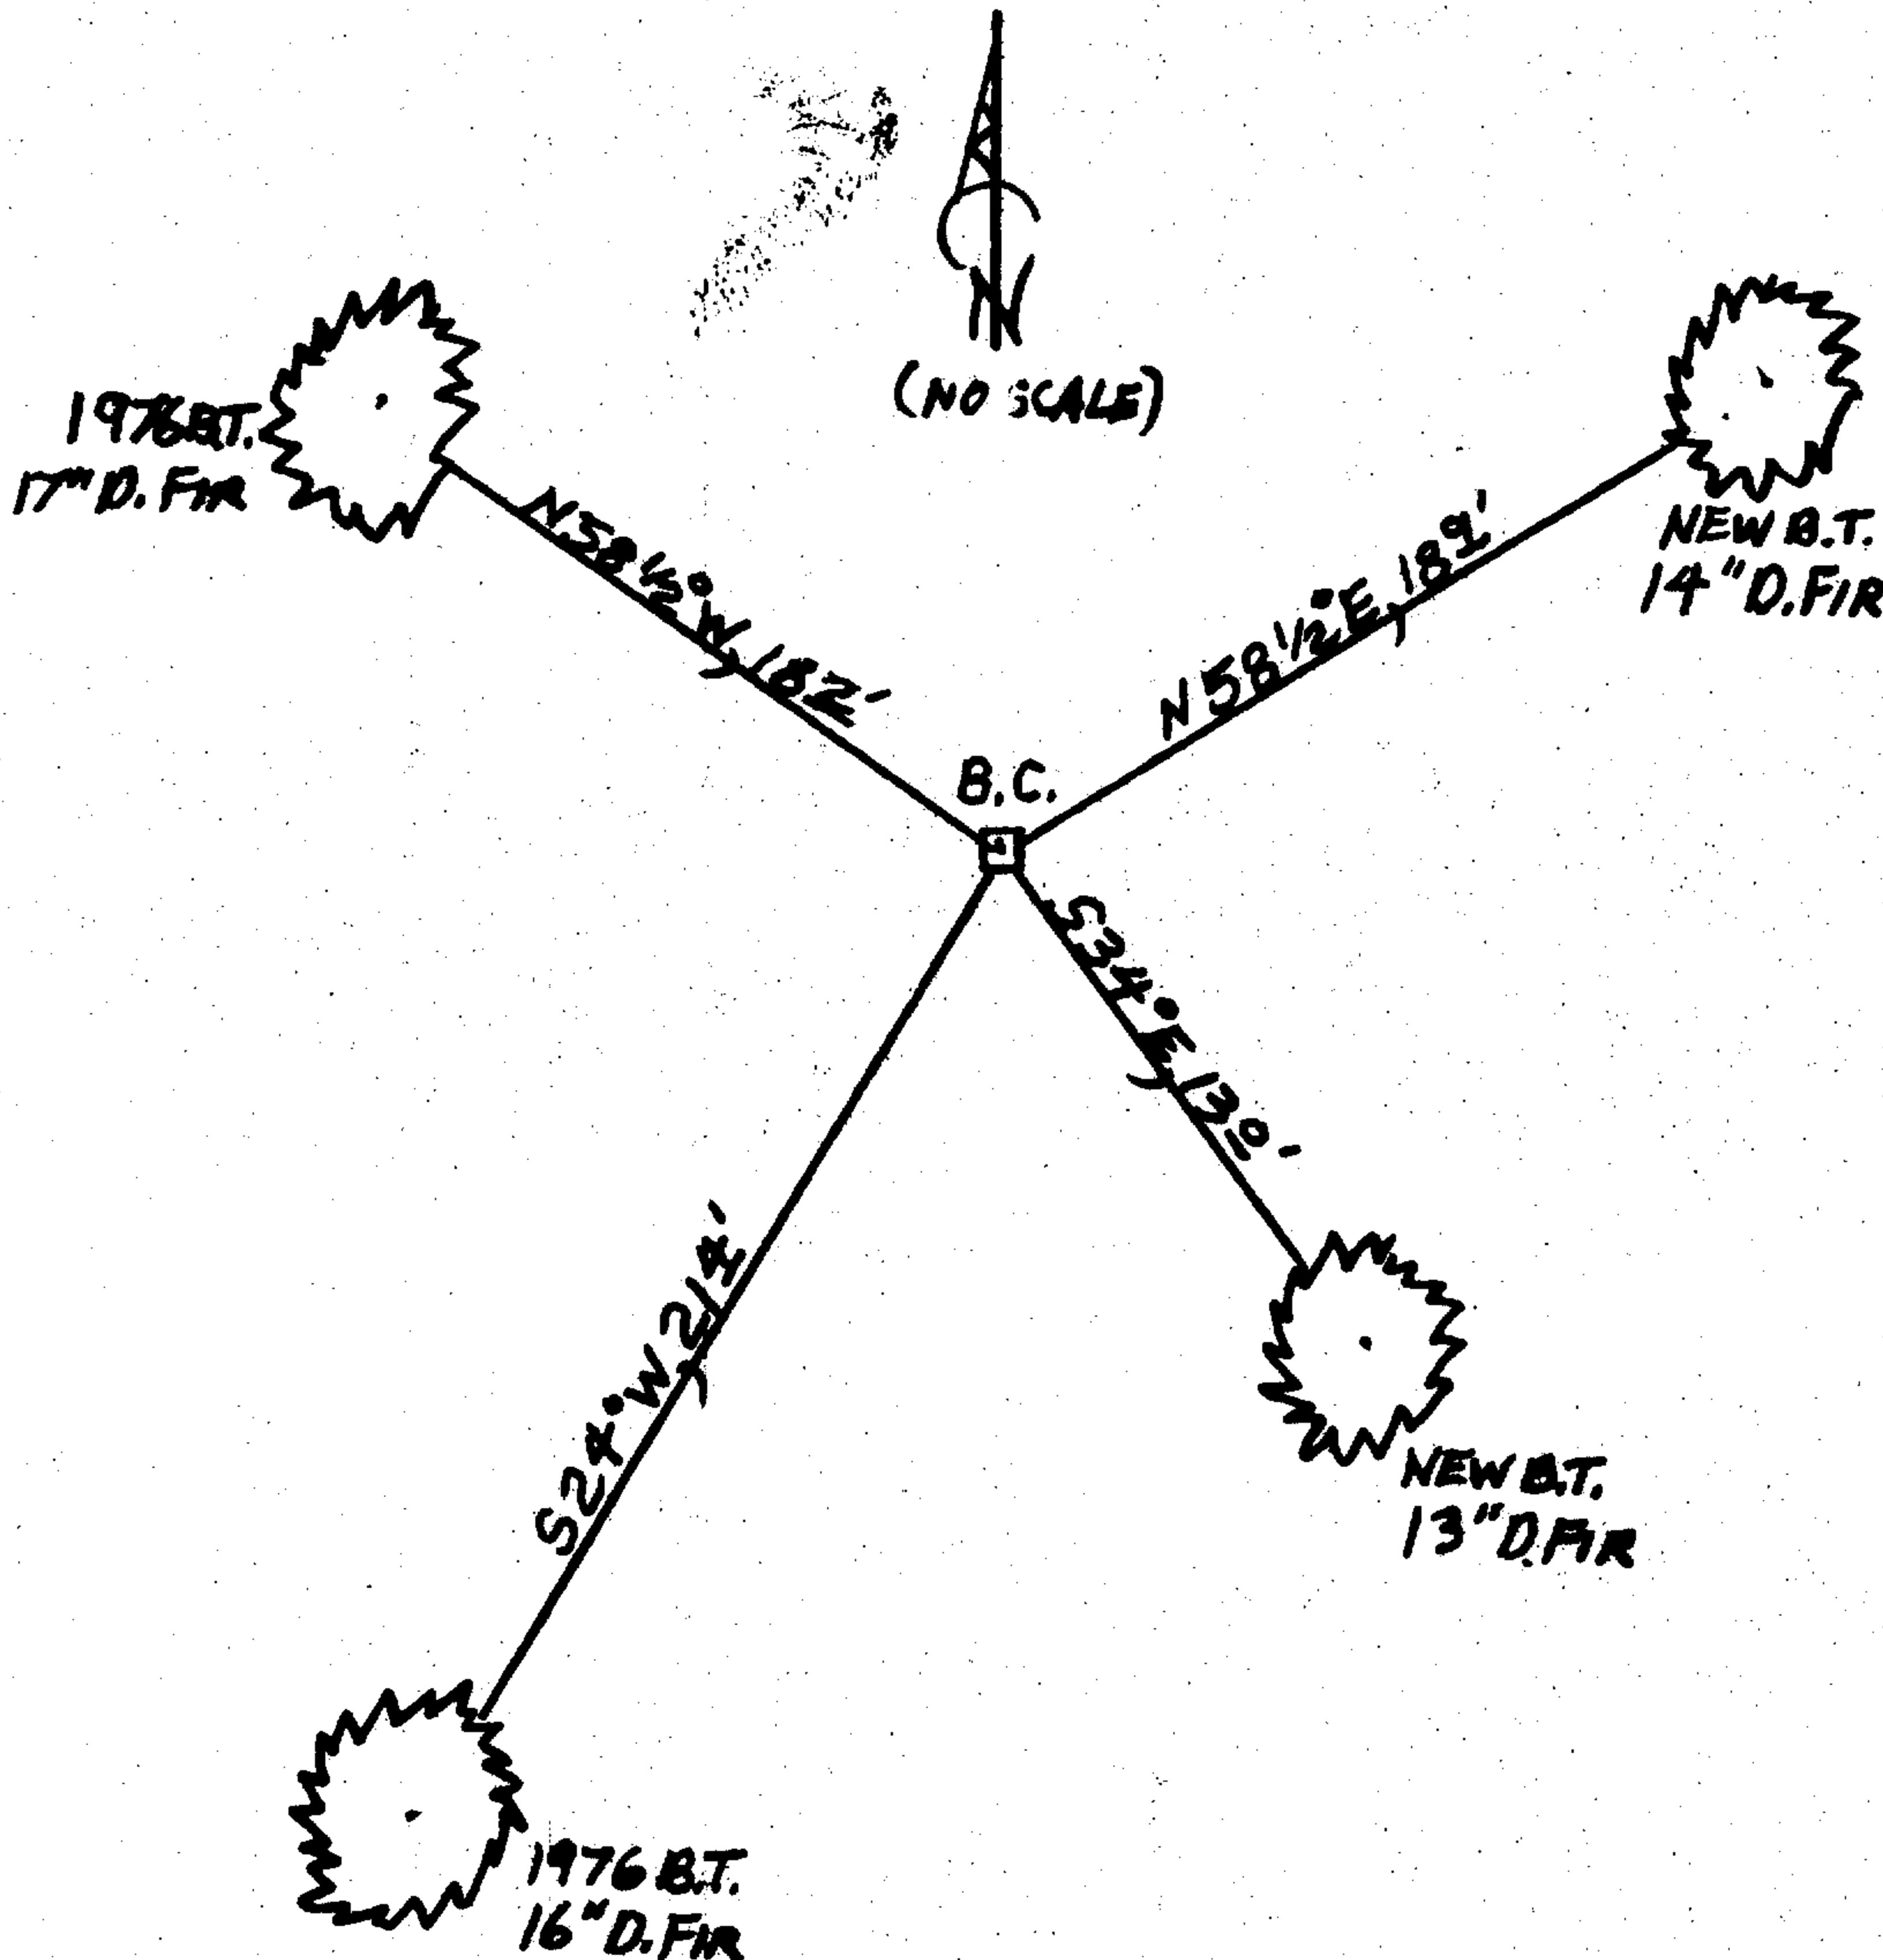

MONUMENT IS ON MODERATELY STEEP SE'LY SLOPE IN AN OLD REPROD. FIR FOREST. FROM THE INTERSECTION OF BASIN CREEK RD. AND A PRIVATE ROAD, GO N 16° E, APPROX. 145 FEET ALONG PRIVATE RD. THEN WEST APPROX. 28 FEET FROM CENTERLINE TO C 1/4.

Comp. Decline. 15 1/2° E
Agency D.C.S.D.
Party Chief STEPHEN JOHN FLAISE
Note keeper Stephen John Flaise
Witnesses MIKE S. KOCH

Surveyor's Seal

REGISTERED
PROFESSIONAL
LAND SURVEYOR

Randall W. Smith

OREGON
JULY 25, 1990
RANDALL W. SMITH
2489

RENEWAL 6-30-2016