

GOVERNMENT CORNER RESTORATION FORM

FILED

TOWNSHIP 23S RANGE 07W SEC. 31 PLSS # 140100

Date: 9-22-2014 By: JC
This survey consists of:

DOUGLAS COUNTY OREGON

DATE AUGUST 26, 2014

Map: _____

Corner Designation

Narrative: _____

Corner Rpt: CS 67/41-56

DOUGLAS COUNTY
SURVEYOR

1/4 ——— S31

- _____ Condition Report
- _____ Not Found
- Renewed
- _____ Unrecorded
- _____ Surveyed In
- _____ Referenced Out

Previous Renewals PROPORTIONED IN BLM 1963
Monument(s) Found: (Condition and Source)

MONUMENT DETAIL

FROM THE 1963 BLM SURVEY:
A 3 1/4 INCH DIAMETER BRASS CAP (MARKED AS AT
RIGHT) ON A 2 INCH I.D. IRON PIPE SET PLUMB
PROTRUDING 3 INCHES ABOVE GROUND.

U. S. CADASTRAL SURVEY
T23S R7W
1/4 S31
1963
BUREAU OF LAND MANAGEMENT

Accessories Found

NO O.B.T. EVIDENCE REMAINS.

FROM THE 1963 BLM SURVEY, EVIDENCE OF ONE B.T.:
A FIR 16" DIA. NOW 24 INCH DIA. 2 FOOT TALL SAWED AND ROTTEN FIR STUMP WITH CLEAR
BLAZE EVIDENCE AT 16 INCHES DIA. BUT WITH NO SCRIBING REMAINING; BEARS N41°E,
399 FEET DISTANT (RECORD N43°E, 399 FEET).
NW BEARING TREE FALLS IN SKID ROAD, NO EVIDENCE FOUND.

RENEWAL

Monument Set (Procedure and Description)

MONUMENT DETAIL

N/A

N/A

New Accessories


A 25 INCH DIAM. GRAND FIR SCRIBED "1/4 S 31 CS" "BT" ON A DOUBLE BLAZE; BEARS N69°E, 82 FEET DISTANT.

A 9 INCH DIAM. GRAND FIR SCRIBED "1/4 S 31 CS" "BT" ON A DOUBLE BLAZE; BEARS N45°W, 19 FEET DISTANT.

A 6 INCH DIAM. DOUGLAS FIR SCRIBED "X" "CSBT" ON A HIGH-LOW BLAZE; BEARS N07 1/2°W, 10 FEET DISTANT.

Sketch of Monument, Accessories, and General Area

Location & Comments

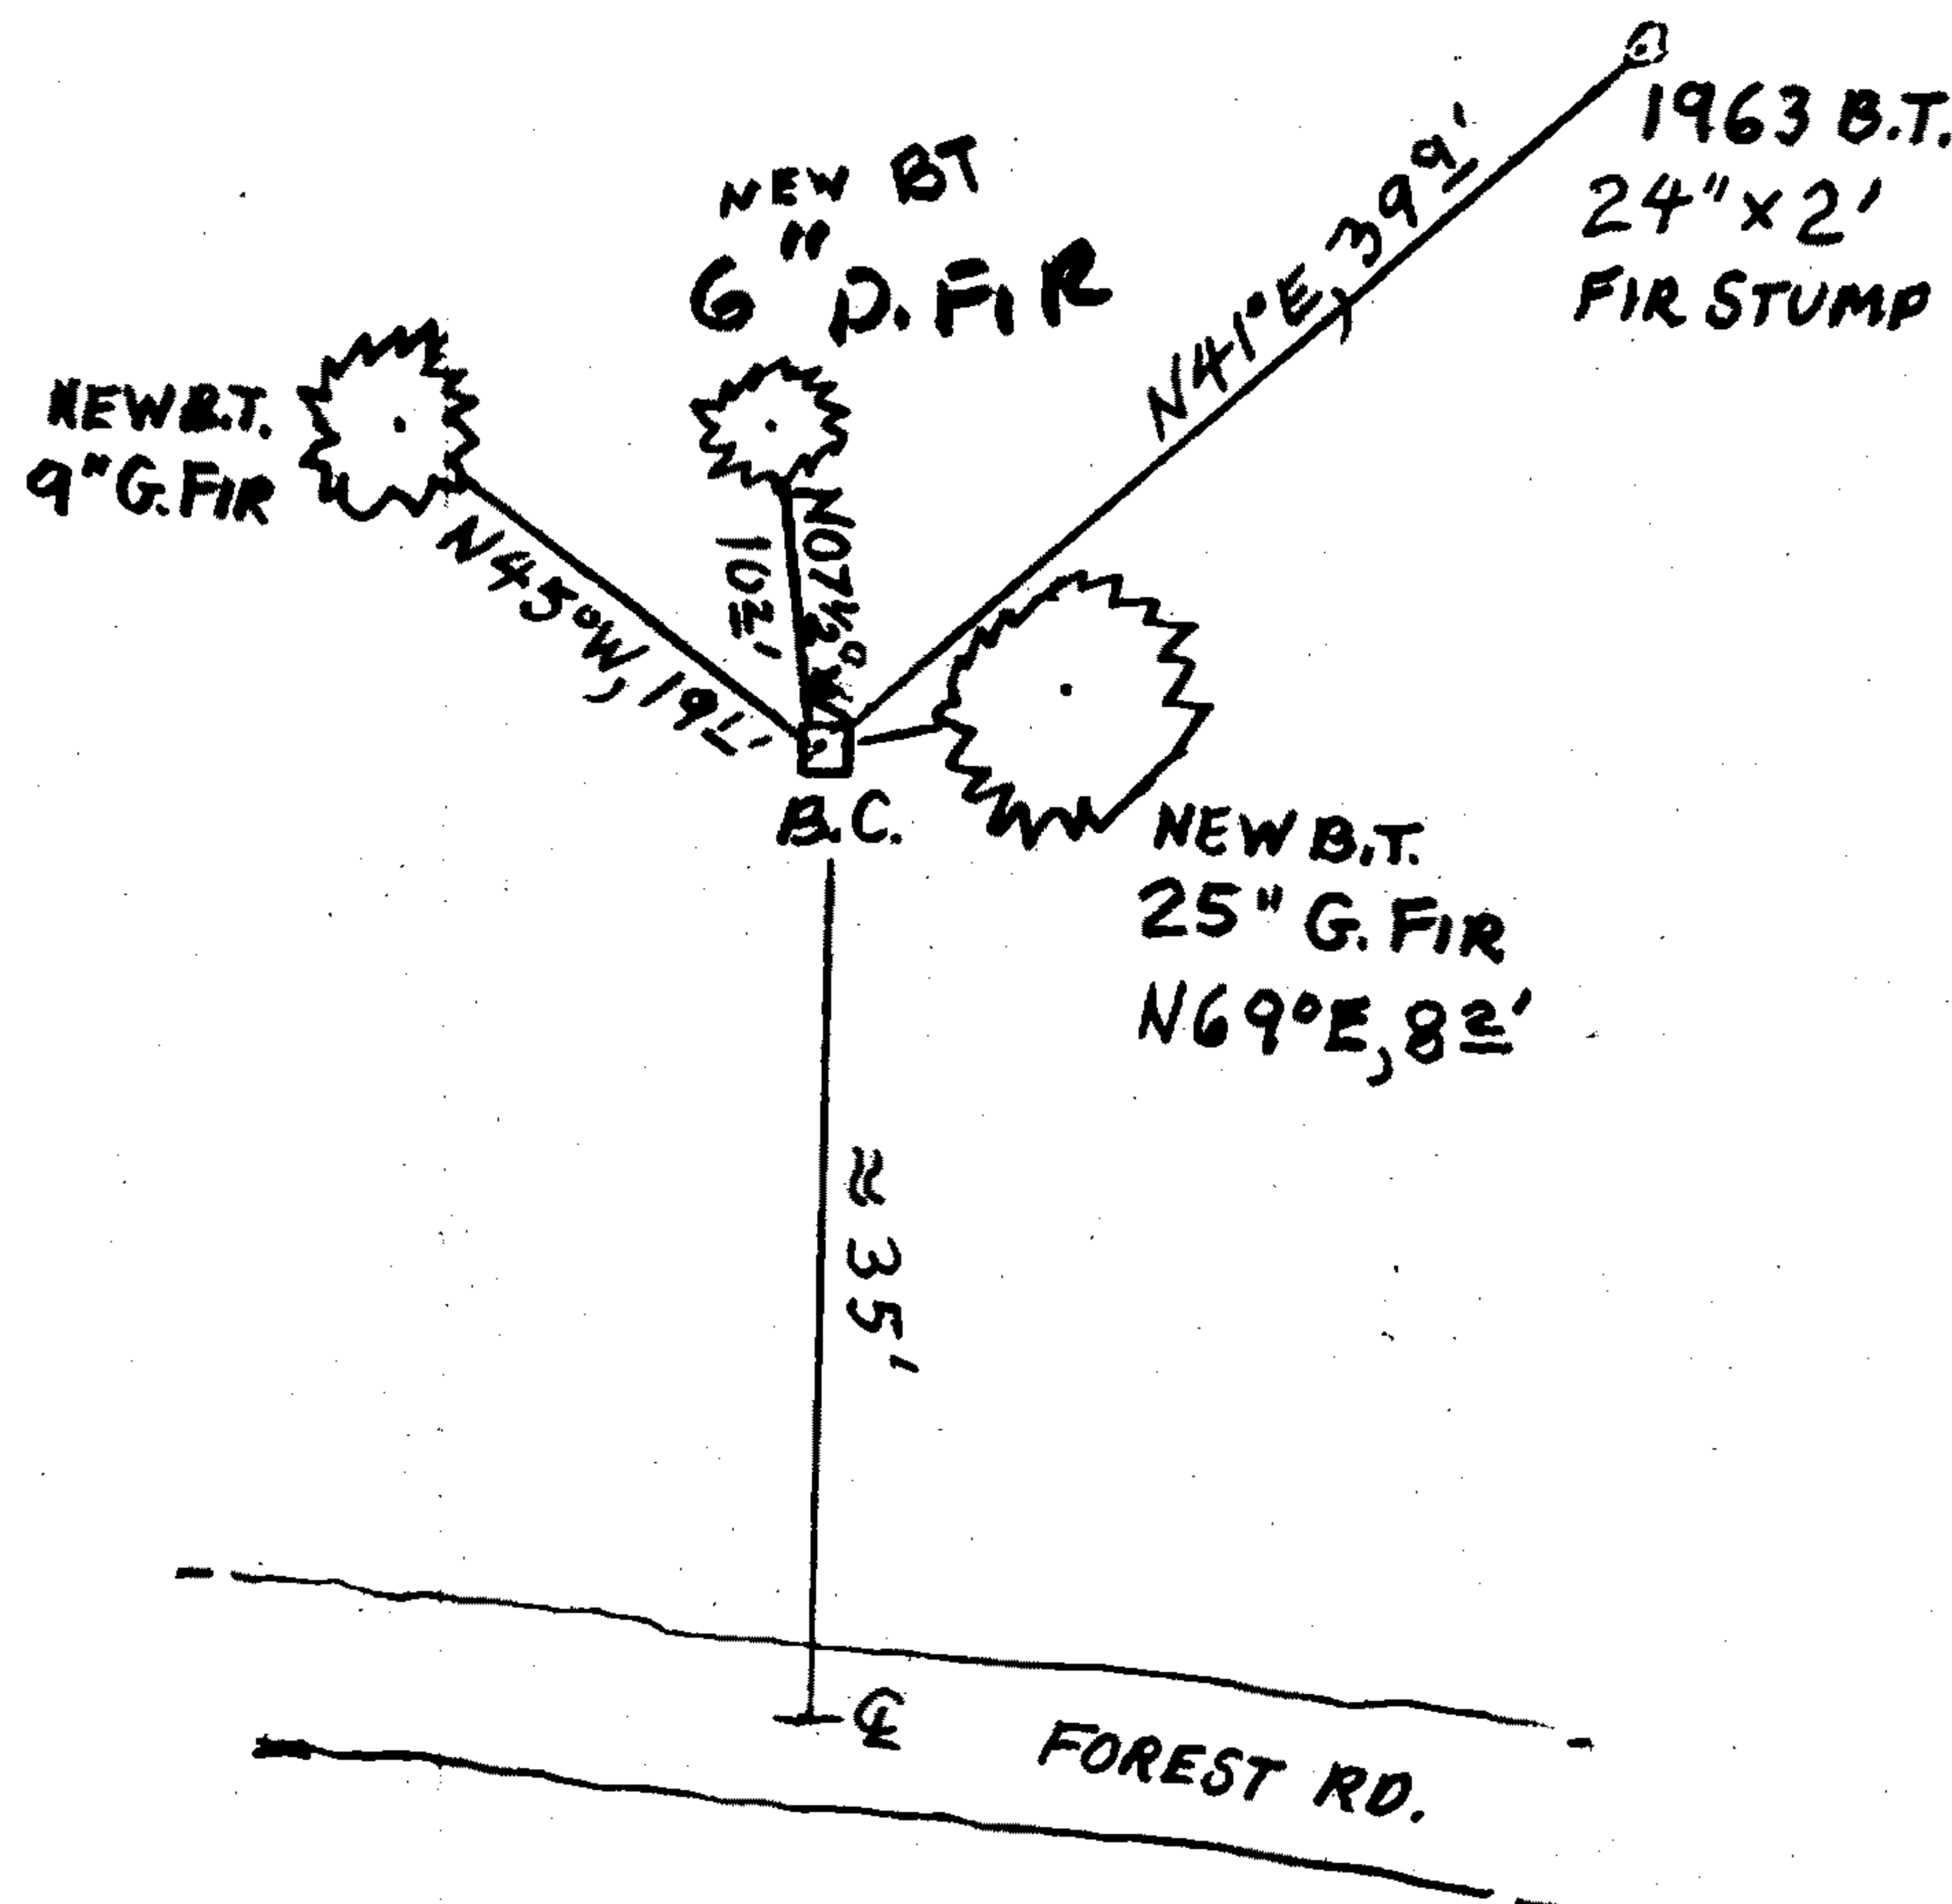

MONUMENT IS ON VERY GENTLE SOUTH SLOPE, IN OLD REPROD OF MIXED FIR AND SOME CEDAR. AN OLDER CLEAR-CUT IS IN NE QUADRANT.

Comp. Decline. 15 1/2°E
Agency D.C.S.O.
Party Chief STEPHEN JOHN FAUSE
Note keeper Stephen John Fause
Witnesses MIKE S. KOCH

Surveyor's Seal

REGISTERED PROFESSIONAL LAND SURVEYOR

OREGON JULY 25, 1900 RANDALL W. SMITH 2400

Randall W. Smith
RENEWAL 6-30-2016