

GOVERNMENT CORNER RESTORATION FORM

FILED

TOWNSHIP 24S RANGE R7W SEC. 5 PLSS # 220660

Date: 10/2/2014 By: JC
This survey consists of:

DOUGLAS COUNTY OREGON

DATE AUG. 29, 2014

Map: _____

Corner Designation

Narrative: _____
Corner Rpt: CS 67/41-57

DOUGLAS COUNTY
SURVEYOR

NW 1/16 S5

- _____ Condition Report
- _____ Not Found
- Renewed
- _____ Unrecorded
- _____ Surveyed In
- _____ Referenced Out

Previous Renewals ESTABLISHED 1963, NO RENEWALS.
Monument(s) Found: _____ (Condition and Source)

MONUMENT DETAIL

THE ORIGINAL 1963 MONUMENT:
A 3 1/4 INCH DIAMETER BRASS CAP (MARKED AS AT
RIGHT) ON A 2 INCH I.D. IRON PIPE IS SET PLUMB
PROTRUDING 6 INCHES ABOVE GROUND.

U.S. CADASTRAL SURVEY

NW 1/16 S5

1963

BUREAU OF LAND MANAGEMENT

Accessories Found

EVIDENCE OF THE TWO 1963 ORIGINAL BEARING TREES:

A FIR, 12 INS. DIAM., NOW A SMALL DISTINCT ROOT-HOLE; BEARS N41°E, 19± FEET
DISTANT (AS PER RECORD).

A FIR, 14 INS. DIAM., NOW A MOSTLY ROTTEN AWAY FIR STUMP 4 INCHES IN DIAM. AT
TOP AND 2 FEET TALL WITH EVIDENCE OF A HEALED WOUND WHICH IS OPENED TO FIND
THE SCRIBING "NW 1/16 S5 BT". THIS STUMP BEARS N66°W, 6± FEET DISTANT (AS PER
RECORD).

C.S. File 67/41-57

N/A

N/A

New Accessories



TWO NEW BEARING TREES:

A DOUGLAS FIR, 13 INCHES IN DIAM., SCRIBED "NW 1/16 S 5" "CSBT"; BEAR S 83° W, 13² FEET DISTANT.

A DOUGLAS FIR, 17 INCHES IN DIAM., SCRIBED "NW 1/16 S 5 CS" "BT"; BEARS N 35° W, 38² FEET DISTANT.

Sketch of Monument, Accessories, and General Area

Location & Comments

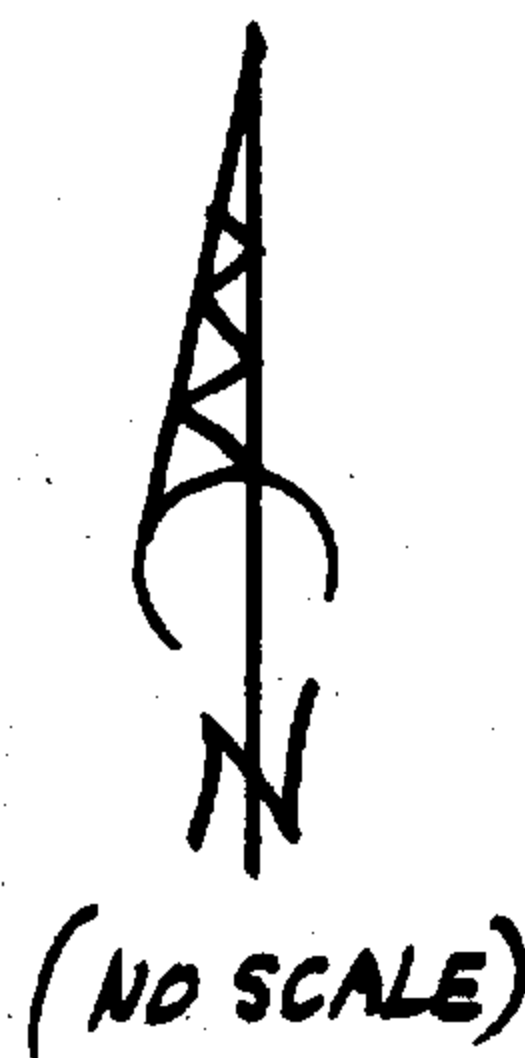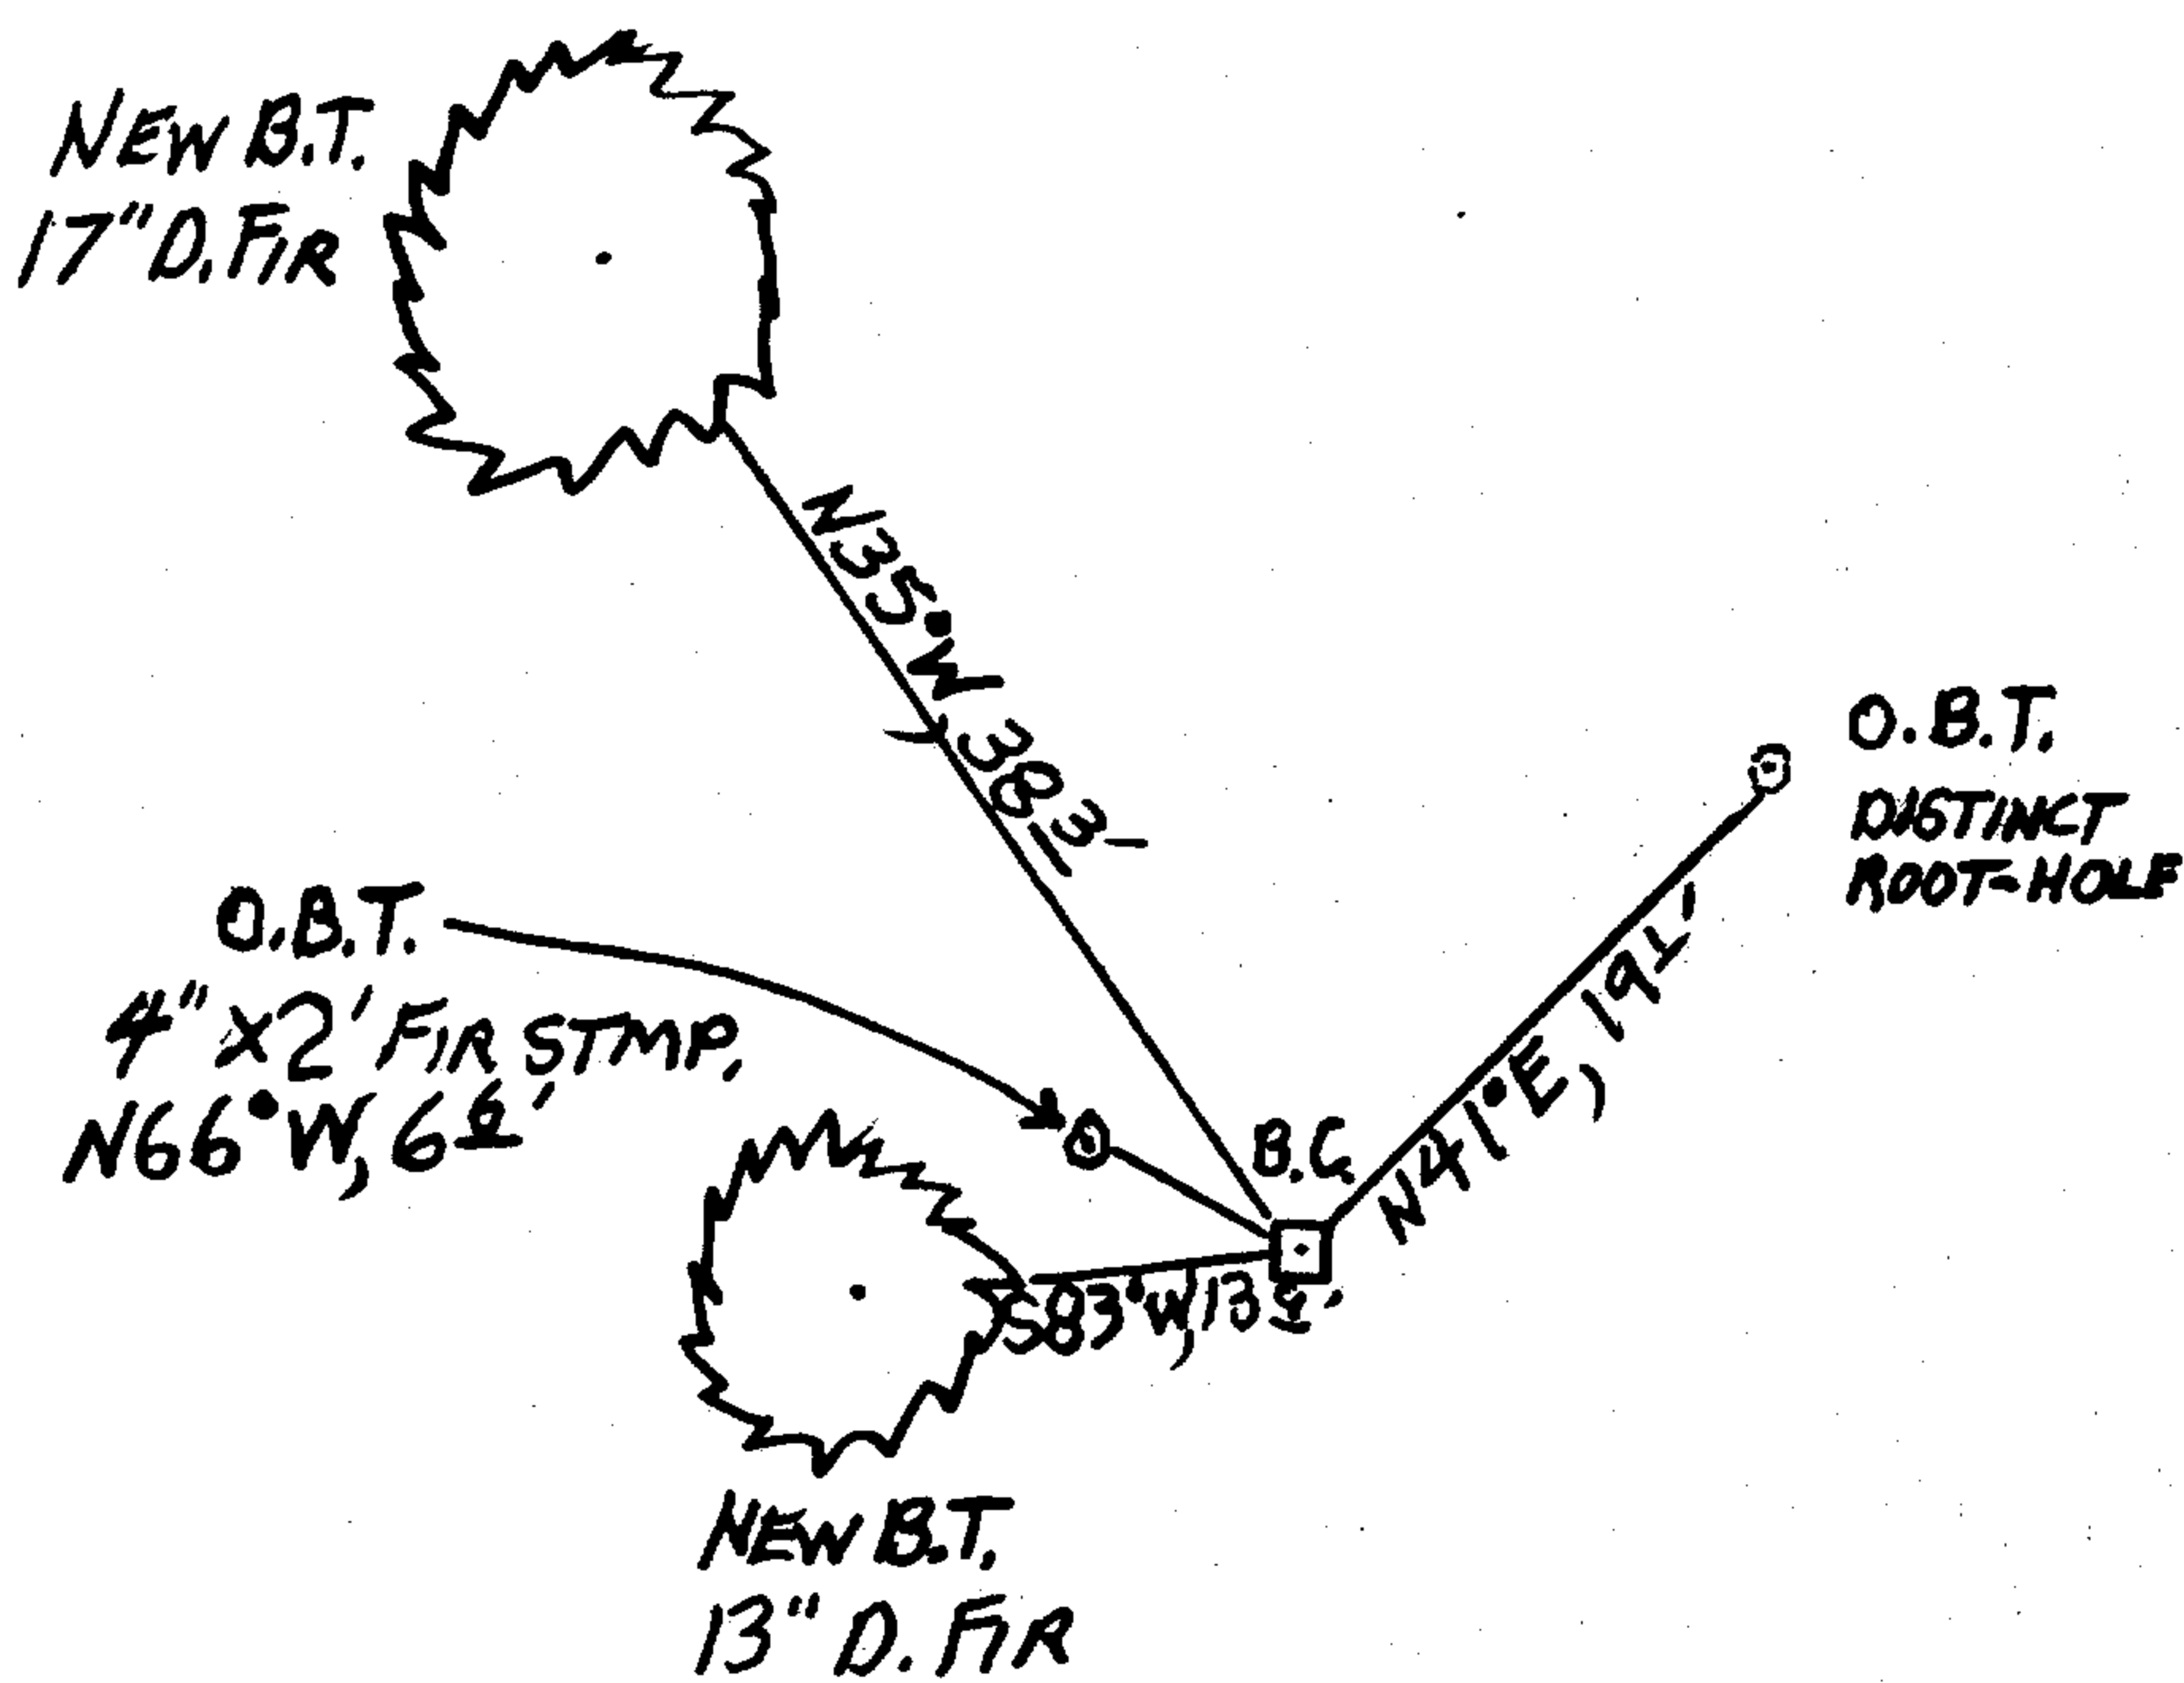

MOSTLY FALLEN WIRE FENCES
RUN SOUTH AND EAST FROM CORNER.
MONUMENT IS ON GENTLE EAST SLOPE
AT EDGE OF PASTURE WHICH IS TO
EAST AND NORTH. SOUTHWEST
QUADRANT IS MEDIUM AGE REPPON
FIR.

Comp. Decline. 15' 2" E
 Agency D. C. S. O.
 Party Chief STEPHEN JOHN FLAISE
 Note keeper Stephen John Flaish
 Witnesses MIKE S. KOCH.

Surveyor's Seal

REGISTERED
 PROFESSIONAL
 LAND SURVEYOR

Handwritten signature of Randall W. Smith

OREGON
 JULY 25, 1990
 RANDALL W. SMITH
 2488

RENEWAL 6-30-2016