

GOVERNMENT CORNER RESTORATION FORM

FILED

TOWNSHIP 24S RANGE 07W SEC. 06 PLSS # 140700

Date: 10-2-2014 By: JC  
This survey consists of:

DOUGLAS COUNTY OREGON

DATE SEPT. 05, 2014

Map: \_\_\_\_\_

Narrative: \_\_\_\_\_  
Corner Rpt: CS 67/41-60

Corner Designation

DOUGLAS COUNTY  
SURVEYOR

N 1/4 ———  
S6 ONLY

- \_\_\_\_\_ Condition Report
- \_\_\_\_\_ Not Found
- Renewed
- \_\_\_\_\_ Unrecorded
- \_\_\_\_\_ Surveyed In
- \_\_\_\_\_ Referenced Out

Previous Renewals ESTABLISHED 1979, NO RENEWALS  
Monument(s) Found: (Condition and Source)

MONUMENT DETAIL

N 1/4 SECTION 6 ONLY ESTABLISHED BY ROBERTS 1979:  
A 2 1/2 INCH DIAMETER BRASS CAP (MARKED AS AT RIGHT)  
ON A 1 INCH I.D. IRON PIPE IS SET PLUMB, PROTRUDING  
8 INCHES ABOVE GROUND.

LS 1939  
T23S R7W  
—————  
S6 1/4  
T24S R7W  
1979

Accessories Found

EVIDENCE OF THE TWO 1979 BEARING TREES:  
A 22" FIR, NOW A SAWED AND VERY ROTTED 20 INCH DIAMETER 2 1/2 FOOT TALL FIR STUMP WITH ALL THE  
BLAZE EVIDENCE ROTTEN AWAY; BEARS S57°W, 35.6 FEET DISTANT (AS PER RECORD).  
A 14" W. FIR NOW A 16 INCH DIAM. GRAND FIR (A.K.A. LOWLAND WHITE FIR) WITH A FULLY HEALED  
DOUBLE BLAZE; BEARS S22°E, 7.6 FEET DISTANT (AS PER RECORD).

THE S 1/4 SECTION 31, T23S, R7W; BEARS N89 1/2°E, 154.0 FEET DISTANT (AS PER RECORD). 13C/IP

C.S. File 67/41-60

Monument Set (Procedure and Description)

MONUMENT DETAIL

N/A

N/A


New Accessories

A GRAND FIR, 16 INCHES IN DIAM., SCRIBED "1/4 S 6" "CSBT" ON A DOUBLE BLAZE; BEARS S 16 1/2° W, 17 1/2 FEET DISTANT.

A GRAND FIR, 13 INCHES IN DIAM., SCRIBED "1/4 S 6 CS" "BT" ON A DOUBLE BLAZE; BEARS S 84° W, 14 3/4 FEET DISTANT.

Sketch of Monument, Accessories, and General Area

Location & Comments

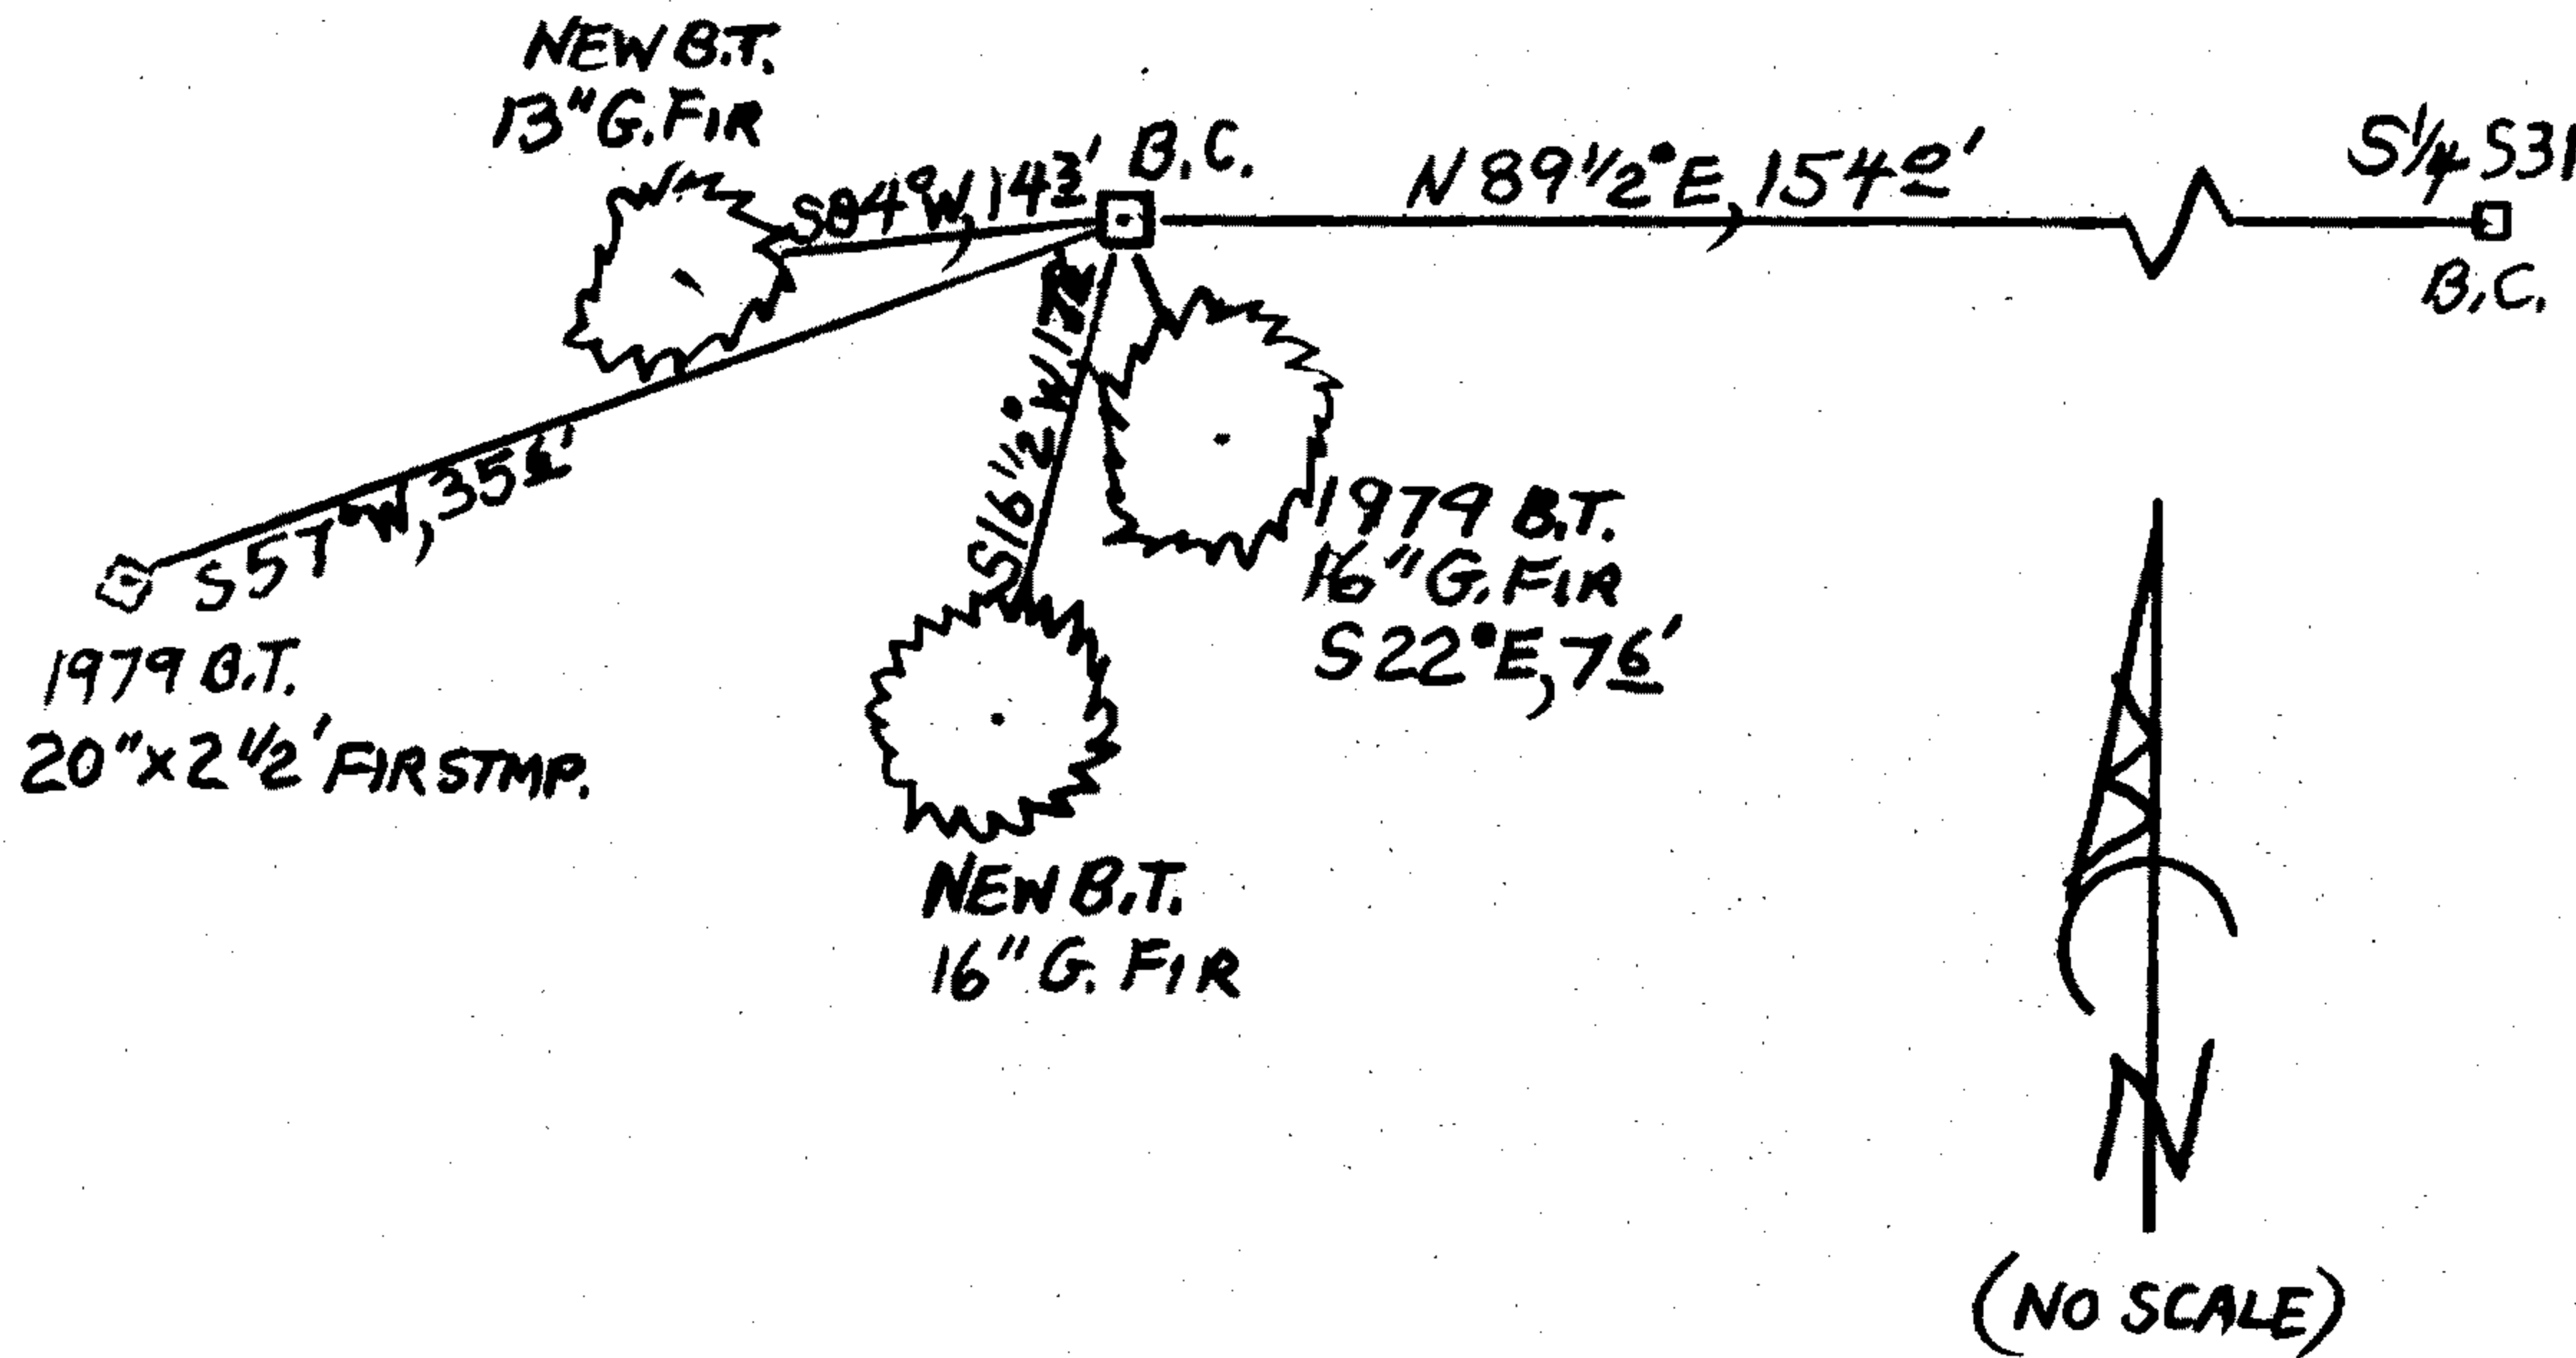

MONUMENT IS ON A VERY GENTLE EAST SLOPE IN AN OLD REPROD. FOREST OF MIXED FIR WITH SOME CEDAR.

Comp. Decline. 15 1/2° E  
Agency B.C.S.D.  
Party Chief STEPHEN JOHN FLAUSE  
Note keeper Stephen John Flause  
Witnesses MIKE S. KOCH

Surveyor's Seal

REGISTERED PROFESSIONAL LAND SURVEYOR

*Handwritten signature*

OREGON  
JULY 25, 1990  
RANDALL W. SMITH  
2488

RENEWAL 6-30-2016