

GOVERNMENT CORNER RESTORATION FORM

FILED

TOWNSHIP 235 RANGE 08W SEC. 25 PLSS # 600200

Date: 11/6/2014 By: JC
This survey consists of:

DOUGLAS COUNTY OREGON

DATE SEPT. 23, 2014

Map: _____

Narrative: _____

Corner Rpt: CS 67/42-3

Corner Designation

S26 | S25
S35 | S36

DOUGLAS COUNTY
SURVEYOR

Previous Renewals 1893, 1964
Monument(s) Found: _____ (Condition and Source)

- _____ Condition Report
- _____ Not Found
- _____ Renewed
- _____ Unrecorded
- _____ Surveyed In
- _____ Referenced Out

FROM THE 1964 BLM RENEWAL:
A 3 1/4 INCH DIAMETER BRASS CAP (MARKED AS AT
RIGHT) ON A 2 INCH I.D. IRON PIPE, SET PLUMB AND
PROTRUDING 4 INCHES ABOVE GROUND.

MONUMENT DETAIL

U.S. DEPT OF THE INTERIOR
T235 RBW

S26 | S25
S35 | S36
1964

BUR. OF LAND MANAGEMENT

Accessories Found

EVIDENCE OF ONE O.B.T.:
A FIR 6" DIA. NOW A LARGE INDISTINCT ROOT-HOLE; THE CENTER OF WHICH BEARS APPROX.
N 30° W, 14 1/2 FEET DISTANT (AS PER RECORD).

THE 1893 RENEWAL BEARING TREE:
A MAPLE 14" DIA. NOW A 25 INCH DIAM. MAPLE WITH A FULLY HEALED, PREVIOUSLY OPENED
BLAZE (HOLE IN BACK OF TREE REVEALS ROTTED CENTER, NO EVIDENCE OF FACE OR SCRIBING
REMAINS). THIS TREE BEARS S 72° W, 42 1/2 FEET DISTANT (AS PER RECORD).

EVIDENCE OF THREE 1964 RENEWAL BEARING TREES:
A FIR 5" DIA. NOW A 25 INCH DIAM. GRAND FIR WITH A FULLY HEALED SINGLE BLAZE;
BEARS N 74° E, 33 1/2 FEET DISTANT (AS PER RECORD).
A FIR 5" DIA. NOW A SMALL DISTINCT ROOT-HOLE; BEARS S 46° W, 60 1/2 FEET DISTANT (AS PER RECORD).
A FIR 5" DIA. NOW A 17 INCH DIAM. DOUGLAS FIR WITH A FULLY HEALED SINGLE BLAZE (THIS
BLAZE FACES APPROX. N 60° E NOT S 84° E AS RECORD WOULD INDICATE); BEARS N 84° W, 57 1/2 FEET
DISTANT (AS PER RECORD).

C.S. File 67/42-3

Monument Set (Procedure and Description)

N/A

N/A

New Accessories


A 13 INCH DIAM. DOUGLAS FIR, SCRIBED "T235 RBWS36" "CSBT" ON A DOUBLE BLAZE;
BEARS S45°E, 297 FEET DISTANT.

FOUND: A 1/2 INCH IRON ROD WITH A YELLOW FOREST BOUNDARY SIGN IS APPROX. SOUTH, 53 FEET
DISTANT.

Sketch of Monument, Accessories, and General Area

Location & Comments

SKETCH ONLY SHOWS LIVE BT'S

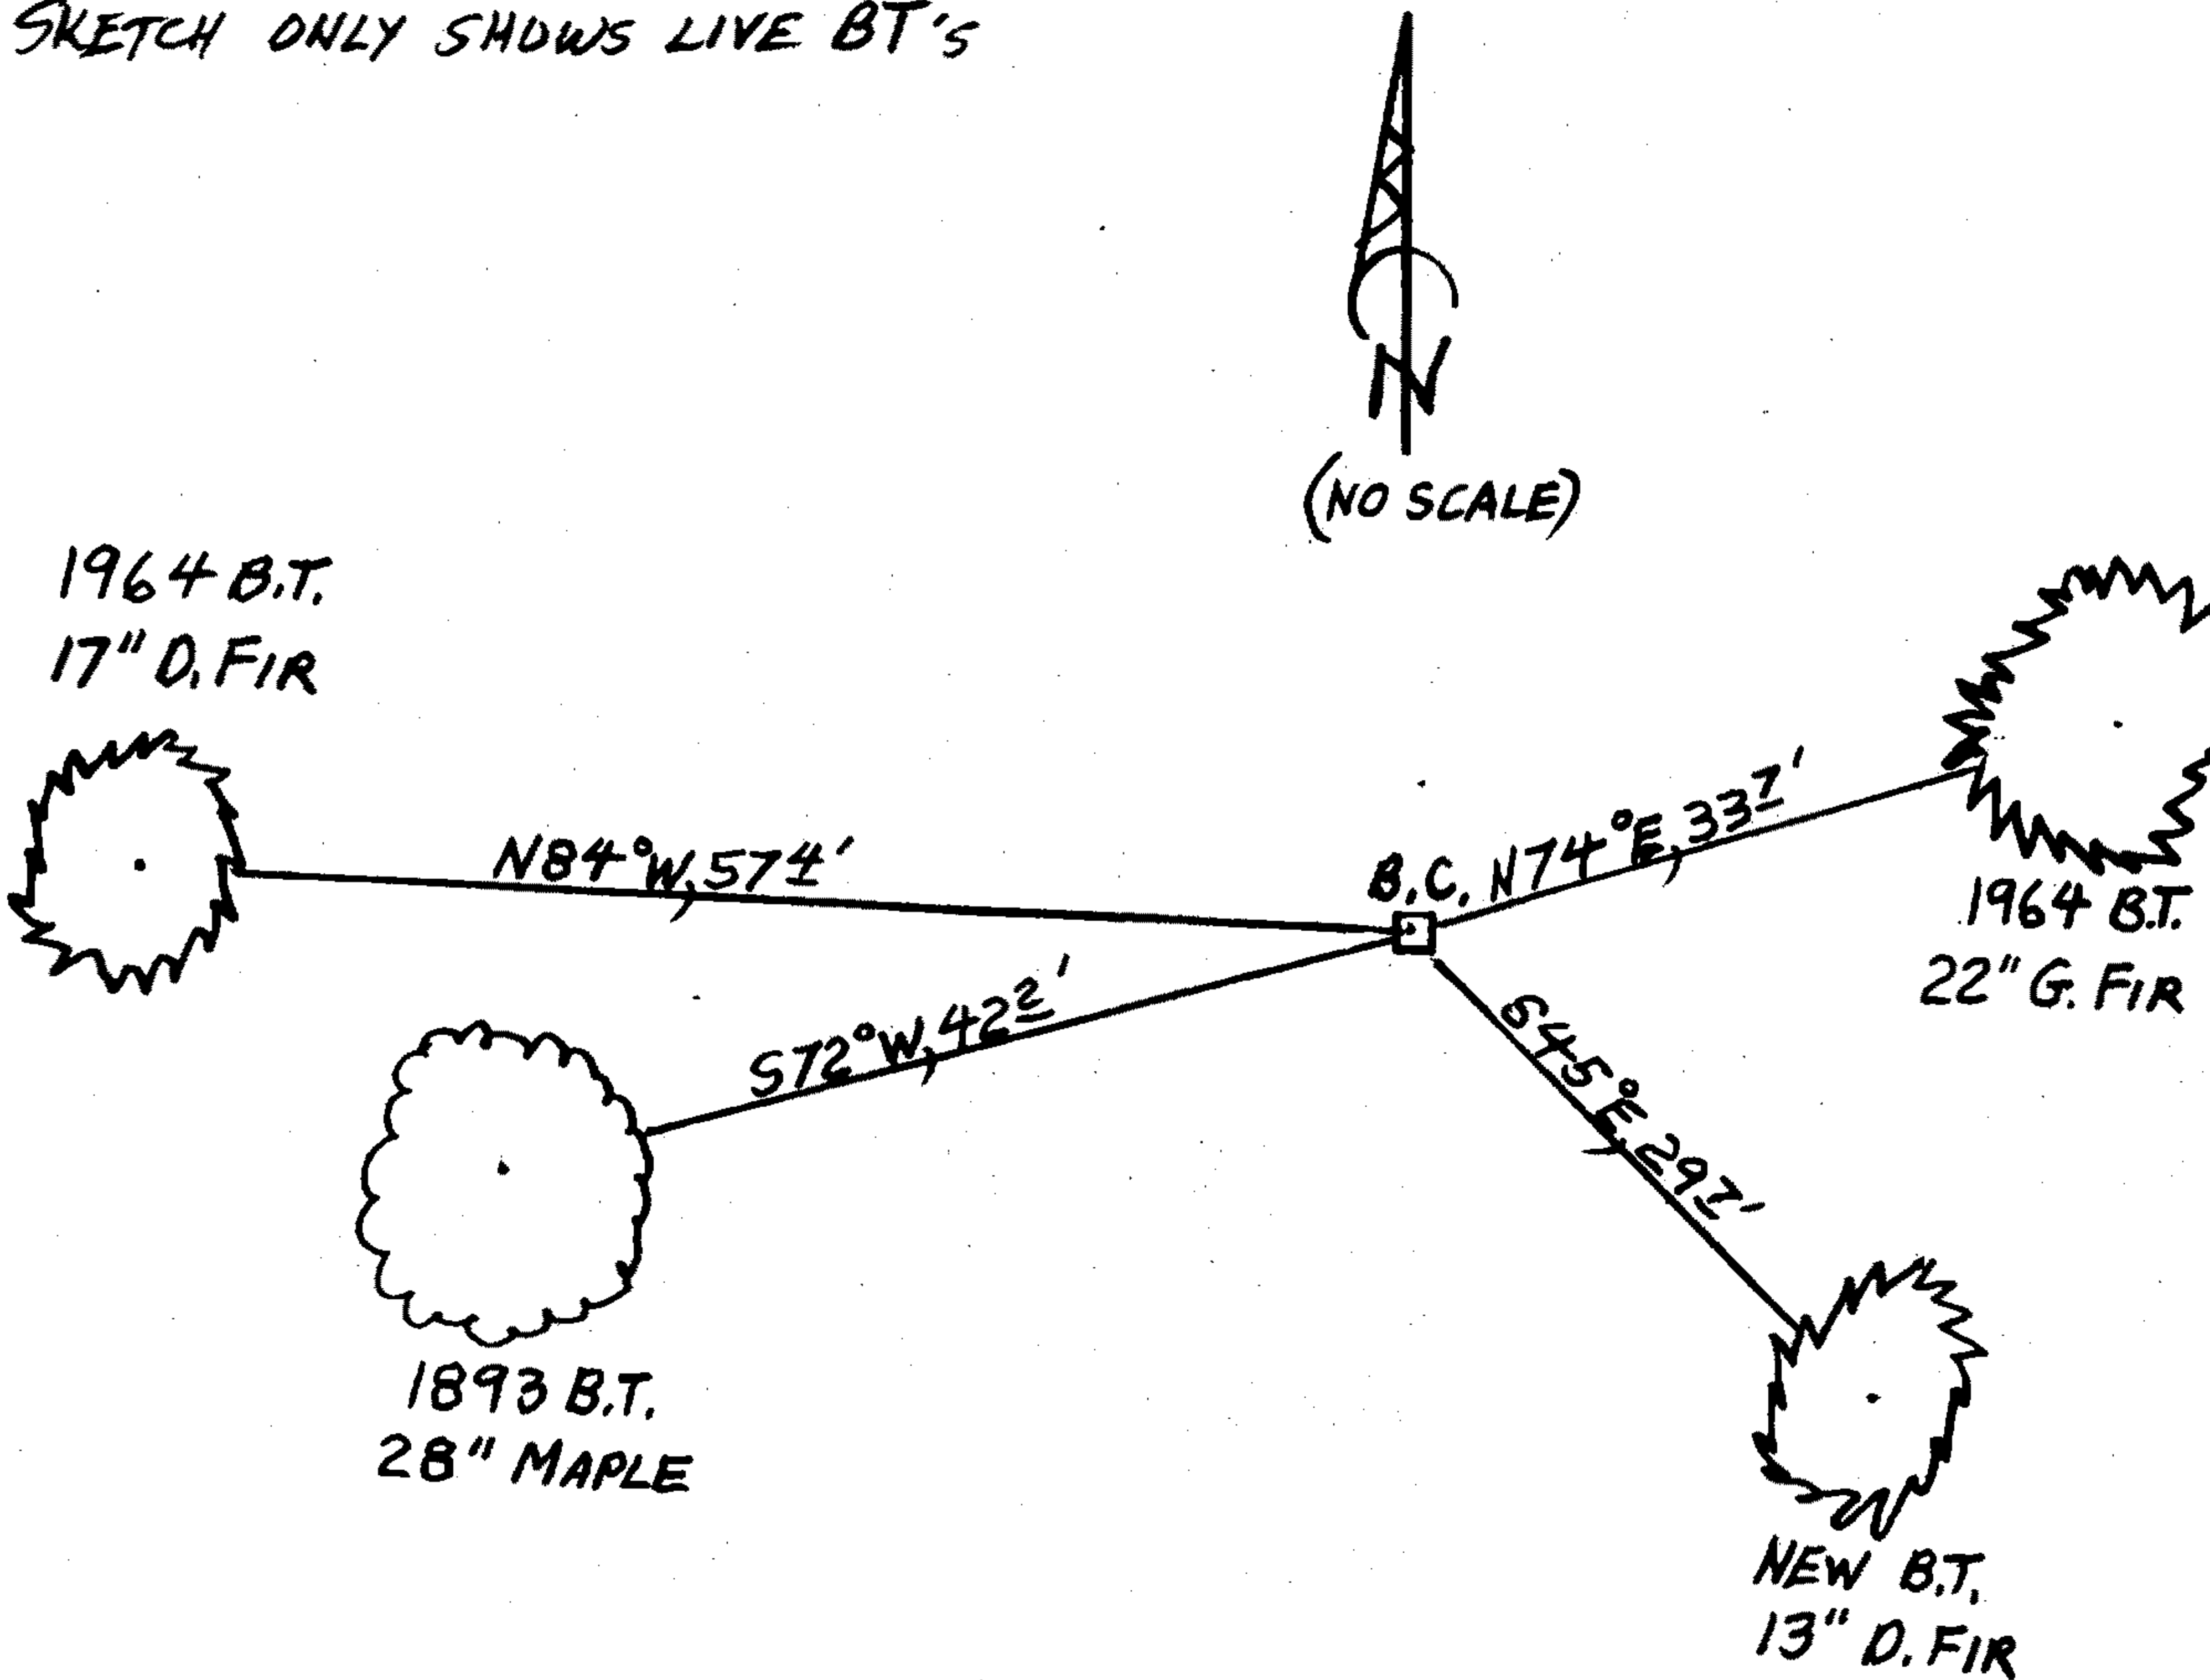

MONUMENT IS ON A VERY GENTLE
NE'LY SLOPE IN OLD MIXED FIR
REPROD. WITH SOME MAPLE.

Comp. Decline. 15 1/2° E
Agency D.C.S.O.
Party Chief STEPHEN JOHN FLAUSE
1964 B.T. Note keeper Stephen John Flause
22" G. FIR Witnesses MIKE S. KOCH

Surveyor's Seal

REGISTERED
PROFESSIONAL
LAND SURVEYOR

Randall W. Smith

OREGON
JULY 25, 1900
RANDALL W. SMITH
2400

REWORK 6-30-2016