

GOVERNMENT CORNER RESTORATION FORM

FILED

TOWNSHIP 245 RANGE 24W SEC. 17 PLSS # 040060

Date: 11-24-2015 By: X  
This survey consists of:

DOUGLAS COUNTY OREGON

DATE FEB. 20, 2015

Map: \_\_\_\_\_

Corner Designation

Narrative: \_\_\_\_\_

Corner Rpt: CS67/42-11

DOUGLAS COUNTY  
SURVEYOR

Previous Renewals 1963  
Monument(s) Found: \_\_\_\_\_ (Condition and Source)

- \_\_\_\_\_ Condition Report
- \_\_\_\_\_ Not Found
- Renewed
- \_\_\_\_\_ Unrecorded
- \_\_\_\_\_ Surveyed In
- \_\_\_\_\_ Referenced Out

FROM THE 1963 RENEWAL A 2 1/2 INCH DIAMETER BRASS CAP (MARKED AS AT RIGHT) ON A 1 INCH I.D. IRON PIPE IS FIRMLY SET PROTRUDING 12 INCHES ABOVE GROUND.

MONUMENT DETAIL

COUNTY SURVEYORS OFFICE

ESE	T
DLC	24
40	S
R4W	
1963	

Accessories Found

ONE ORIGINAL BT AN DAK 12" DIA., NOW A 30 INCH DIAMETER WHITE OAK WITH PARTIALLY HEALED, PREVIOUSLY OPENED BLAZES (NO VISIBLE SCRIBING); BEARS N50°E, 21± FEET DISTANT (AS PER RECORD).  
NO EVIDENCE OF OTHER DBT REMAINS.

TWO 1963 RENEWAL BEARING TREES. A 12" W. DAK NOW A DOUBLE TRUNK WHITE OAK THE MOST NORTHERLY 17 INCH DIAMETER TRUNK OF WHICH HAS A FULLY HEALED DOUBLE BLAZE. THE C.R.C. OF THIS TREE BEARS S03'2"W, 32.0 FEET DISTANT (RECORD OF S 2°W, 31.2' IS TO SCRIBED TRUNK).

A 14" W. DAK NOW A 20 INCH DIAMETER WHITE OAK WITH A FULLY HEALED DOUBLE BLAZE; BEARS S66'2"W, 24± FEET DISTANT (RECORD S65°W (BEARING TO BLAZE), 24.1').

C.R.C. = Center Root Collar

C.S. File 67/42-11

Monument Set (Procedure and Description)

MONUMENT DETAIL

N/A


N/A

New Accessories

AN 18 INCH DIAMETER BLACK OAK SCRIBED "ESE DLG 40" "CS BT" ON A DOUBLE BLAZE; BEARS N 46 1/2° W, 75' FEET DISTANT.

Sketch of Monument, Accessories, and General Area


Location & Comments

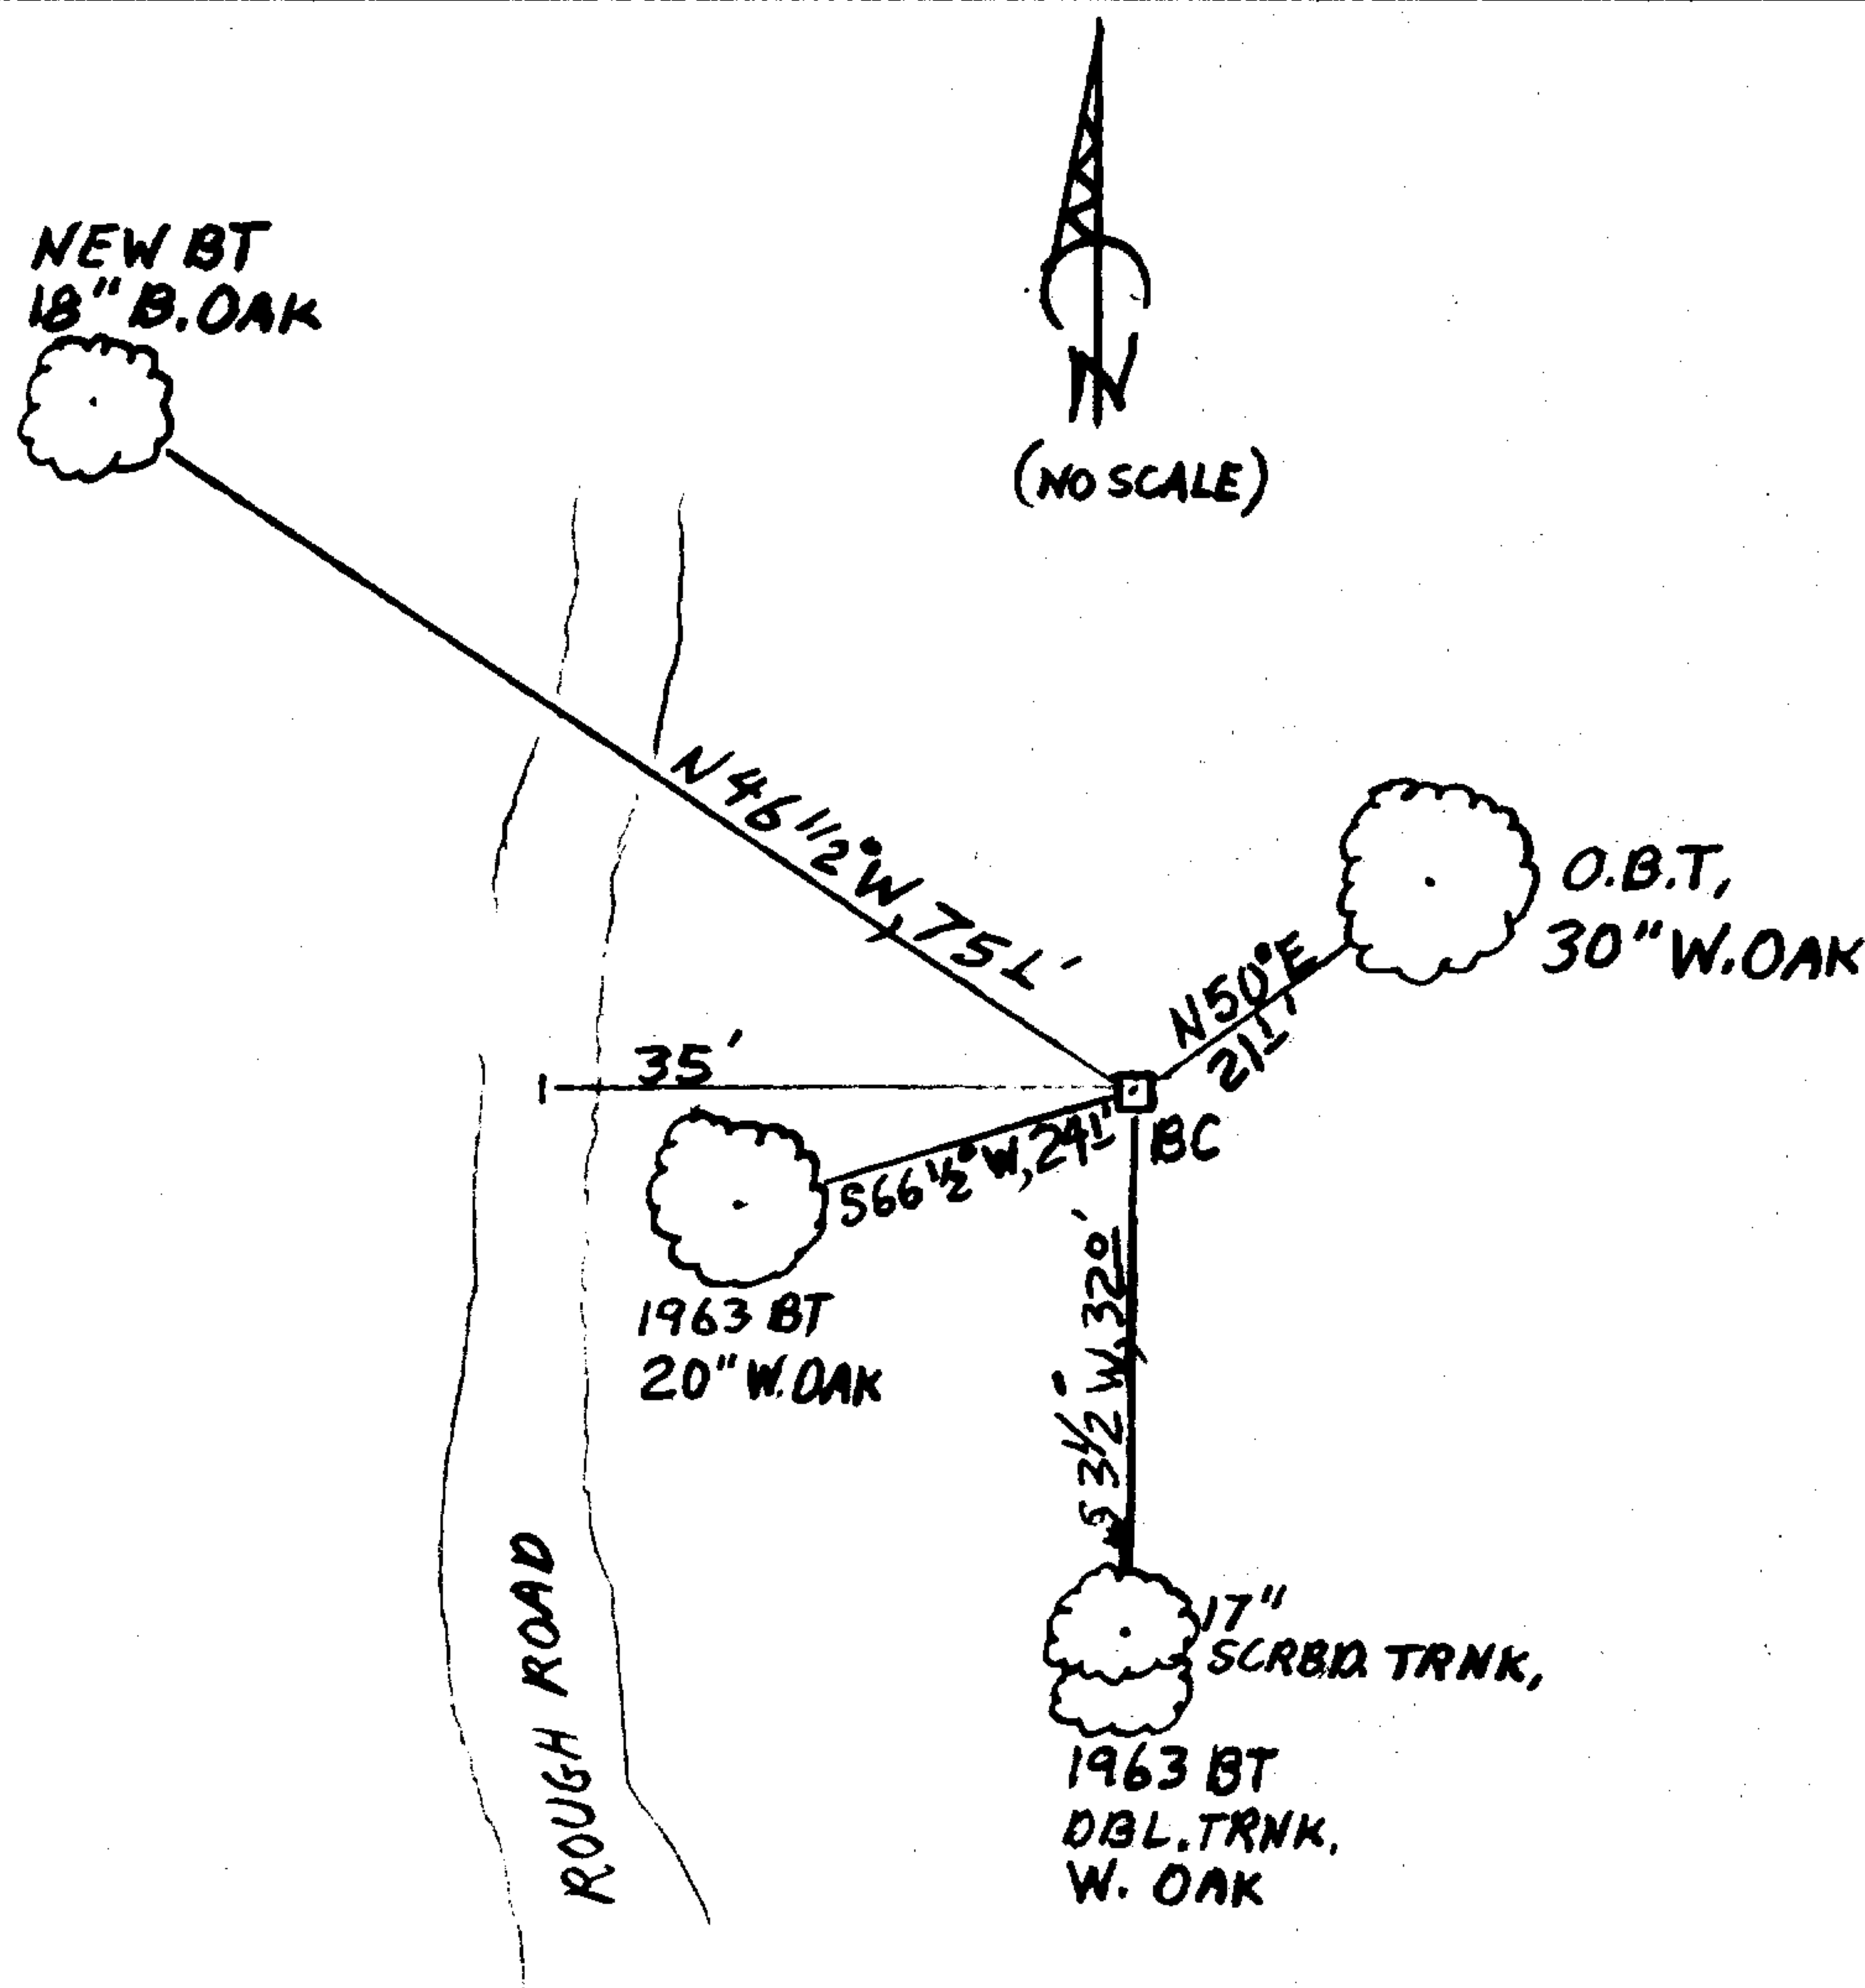


MONUMENT IS ON GENTLE SOUTH SLOPE IN OPEN WOOD MAINLY OF OAK AND HAWTHORN WITH SOME FIR AND MADROGNE

Comp. Decline. 15 1/4° E  
Agency DCSO  
Party Chief STEPHEN JOHN FLAUSE  
Note keeper Stephen John Flause  
Witnesses MIKE S. KOCH

Surveyor's Seal

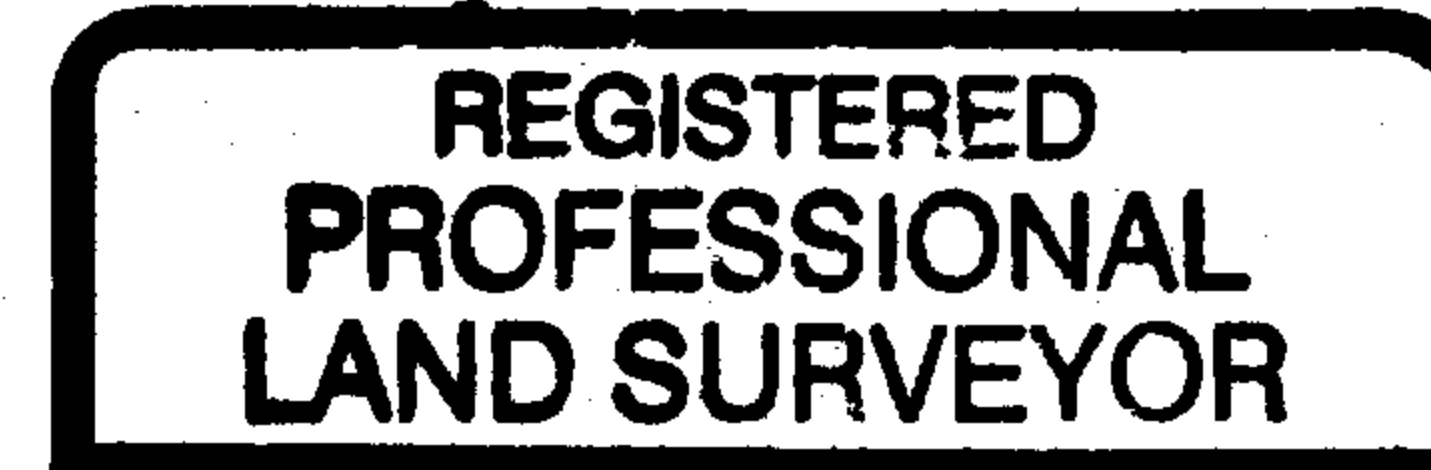

*Kristian O. DeGroot*

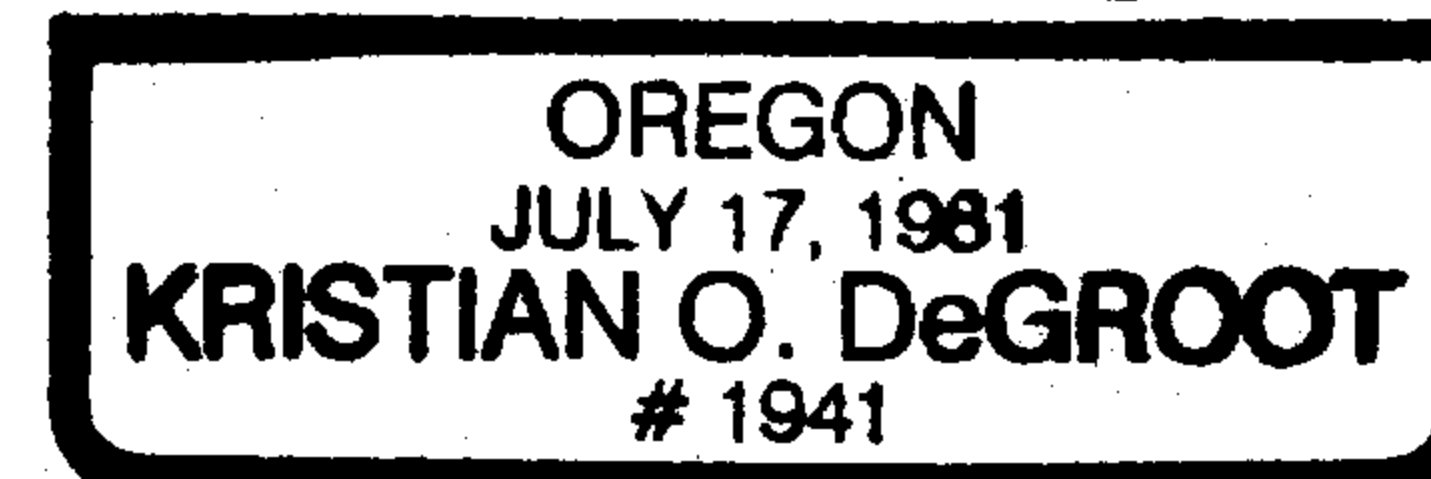

RENEWAL 12/31/15