

GOVERNMENT CORNER RESTORATION FORM

FILED

TOWNSHIP 24S RANGE 04W SEC. 16 PLSS # 047010

Date: 11-24-2015 By: X
This survey consists of:

DOUGLAS COUNTY OREGON

DATE FEB. 23, 2015

Map: _____

Narrative: _____

Corner Designation

Corner Rpt: 67/42-12

DOUGLAS COUNTY
SURVEYOR

NE
DLC 47

- Condition Report
- Not Found
- Renewed
- Unrecorded
- Surveyed In
- Referenced Out

Previous Renewals 1963
Monument (s) Found: _____ (Condition and Source)

FROM THE 1963 RENEWAL A 2 1/2 INCH DIAMETER BRASS CAP (MARKED AS AT RIGHT) ON A 1 INCH I.D. IRON PIPE IS FIRMLY SET PROTRUDING 10 INCHES ABOVE GROUND.

MONUMENT DETAIL

COUNTY SURVEYORS OFFICE
T24S

NE | R
DLC | 4
47 | W

1963

Accessories Found

ONE ORIGINAL BEARING TREE:
AN OAK, 15" DIA. NOW A 17 INCH DIAMETER 3 FOOT TALL ROTTEN OAK STUMP WITH A PREVIOUSLY OPENED BLAZE (PREVIOUSLY FOUND SCRIBING NOW ROTTED AWAY); BEARS N50°E, 21 1/2 FEET DISTANT (RECORD N50°E, 20 1/2 FEET DISTANCE POSSIBLE FACE MEAS.). NO EVIDENCE OF SW OBT REMAINS.

THE TWO 1963 RENEWAL BEARING TREES:
A 6" W. OAK, NOW A 9 INCH DIAM. WHITE OAK WITH A FULLY HEALED DOUBLE BLAZE; BEARS S77°W, 5 1/2 FEET DISTANT (RECORD S77°W, 5 1/2').
A 7" W. OAK, NOW AN 8 INCH DIAM. WHITE OAK WITH A FULLY HEALED DOUBLE BLAZE; BEARS N20°W, 25 1/2 FEET DISTANT (RECORD N20°W, 24 1/2').

A N-S FENCELINE IS 2 FEET WEST OF CORNER MONUMENT.

C.S. File 67/42-12

RENEWAL

Monument Set (Procedure and Description)

MONUMENT DETAIL

N/A

N/A


New Accessories

THE HIGHEST POINT ON THE EASTERLY EDGE OF A 4 1/2 x 3 x 2 FOOT TALL BOULDER BEARS N25 3/4° E, 82 1/2 FEET DISTANT.

A 8 INCH DIAM. MADRONE SCRIBED "NE DLC 47 CS" "BT" ON A DOUBLE BLAZE; BEARS N61° E, 26 1/2 FEET DISTANT.

Sketch of Monument, Accessories, and General Area

Location & Comments

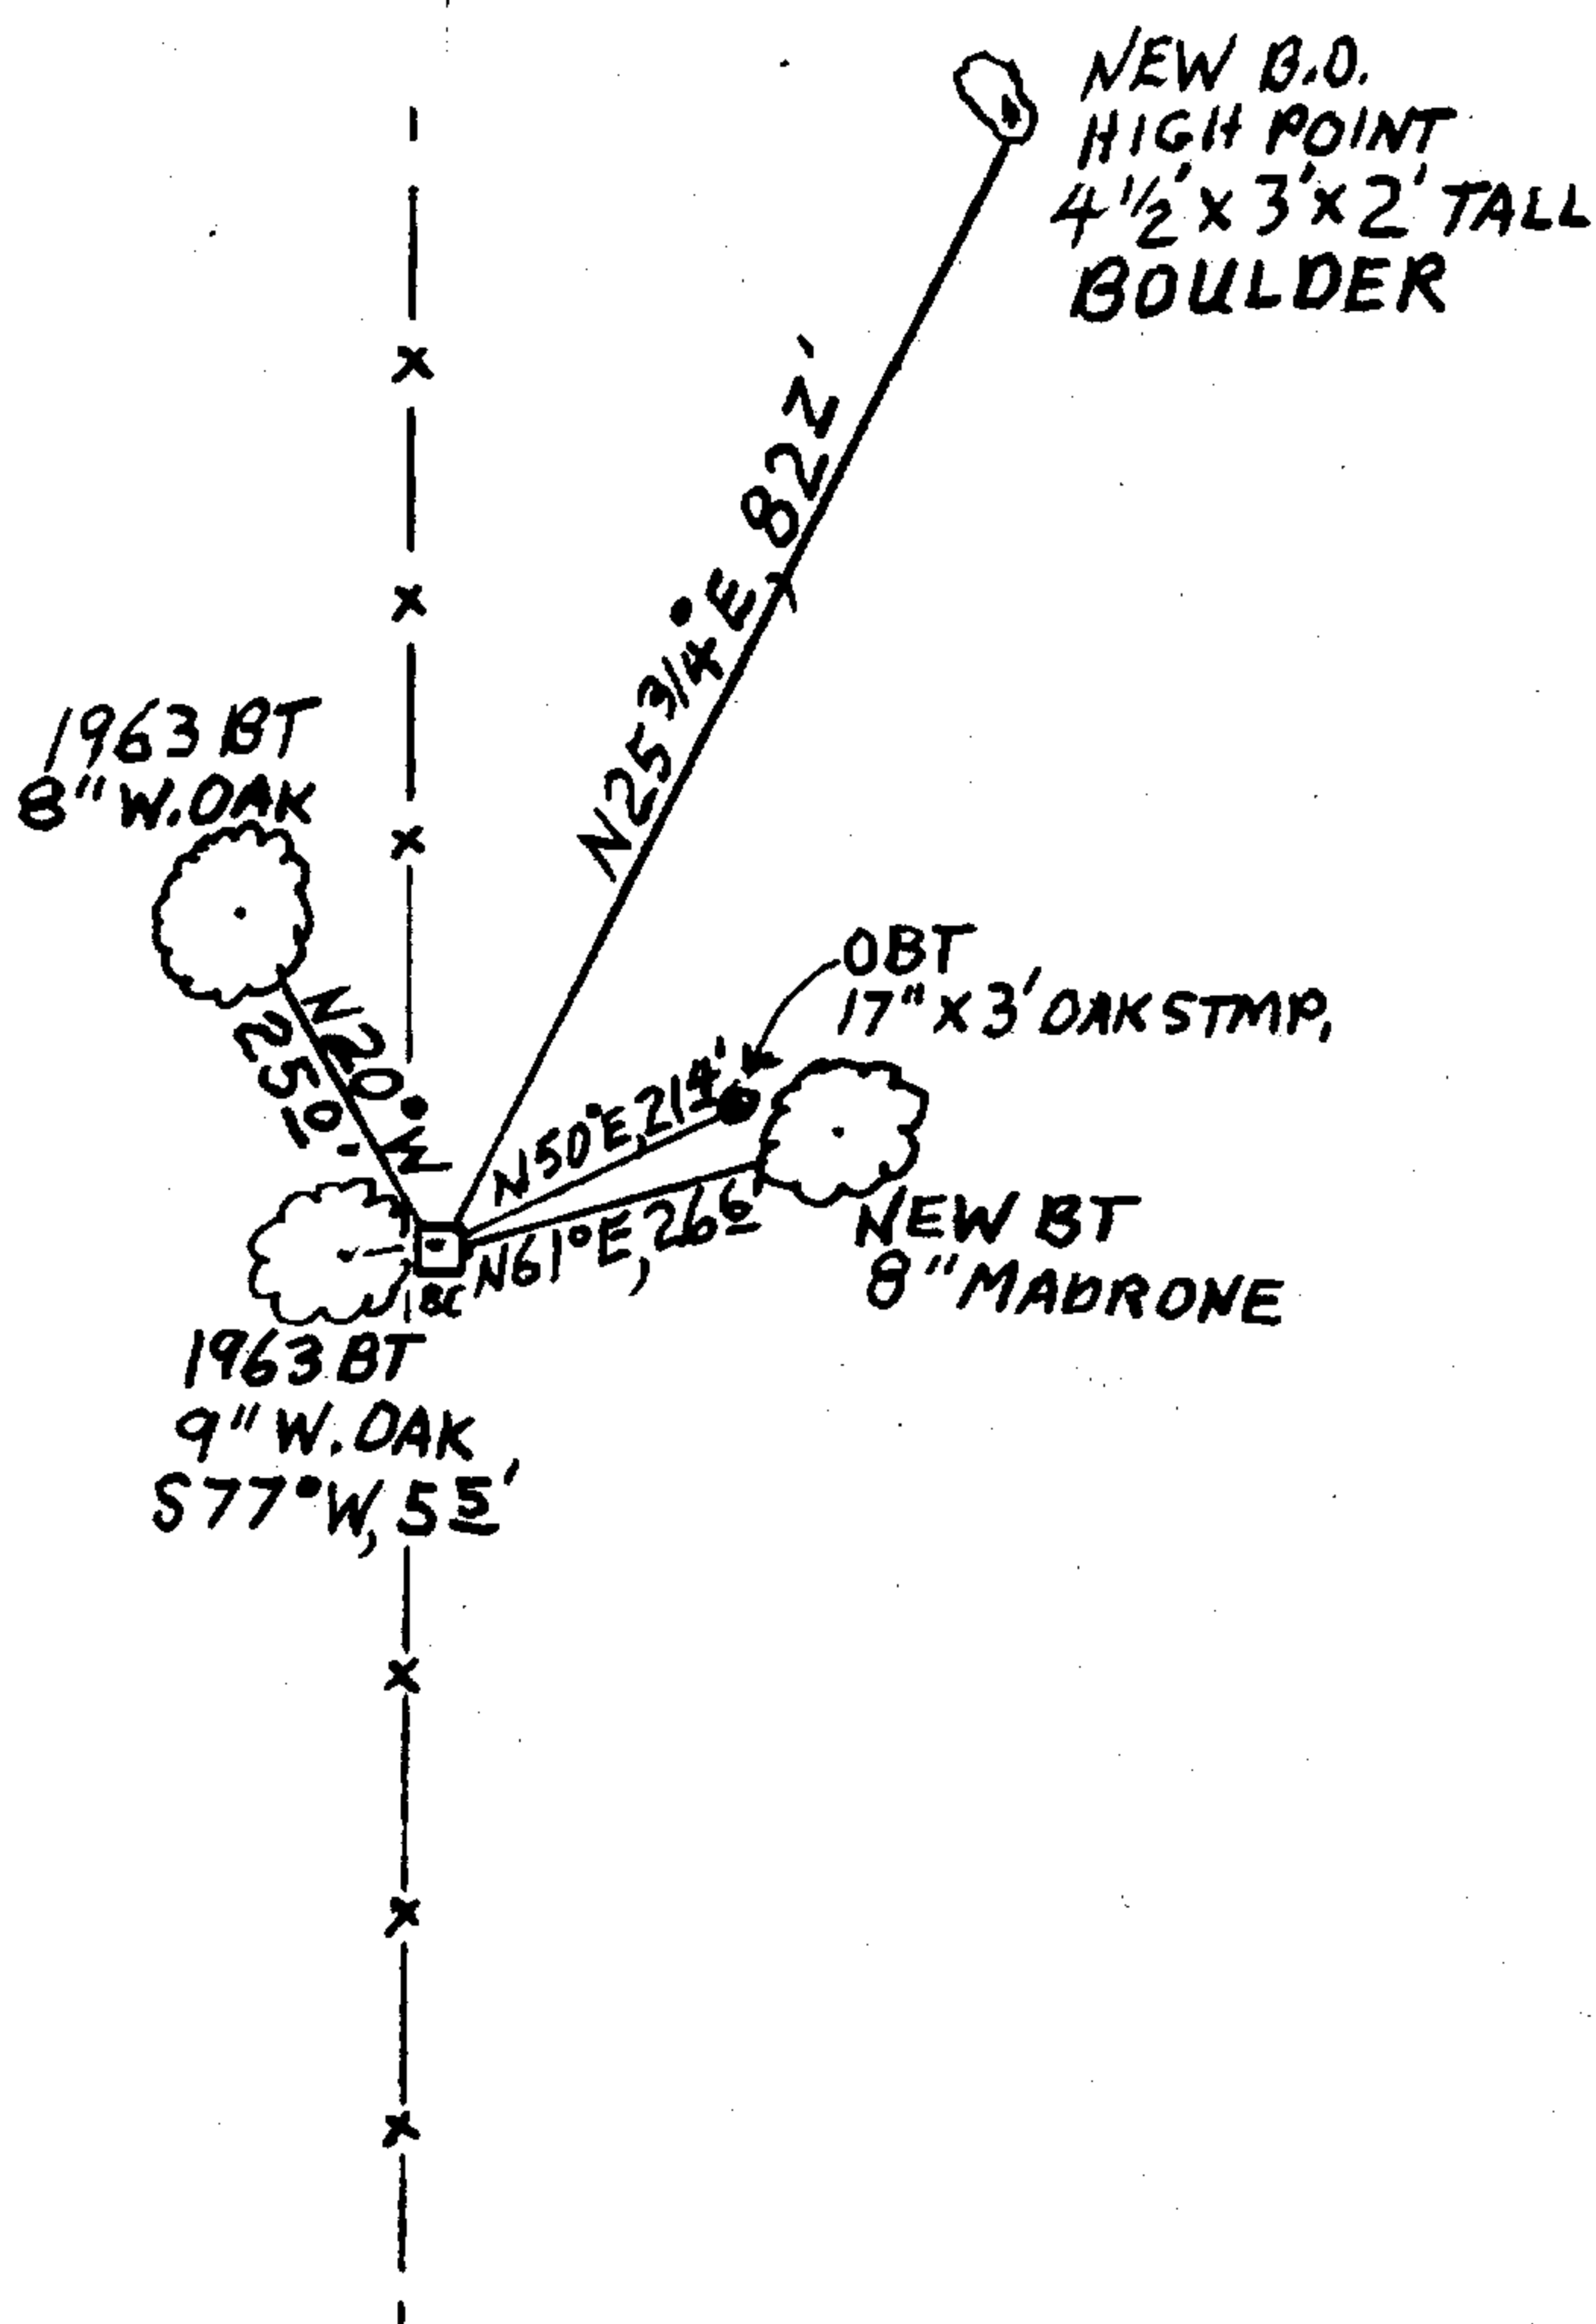

MONUMENT IS ON GENTLE SOUTH SLOPE IN AN OAK WOODLAND WITH SCATTERED MADRONE, FIR AND CEDAR.

Comp. Decline. 15 1/4° E
Agency DCSO
Party Chief STEPHEN JOHN FRALISE
Note keeper Stephen John Fralise
Witnesses MIKE S. KOCH

Surveyor's Seal

REGISTERED PROFESSIONAL LAND SURVEYOR

Kristian O. DeGroot

OREGON
JULY 17, 1981
KRISTIAN O. DeGROOT
1941

RENEWAL 12/31/15