

GOVERNMENT CORNER RESTORATION FORM

FILED

TOWNSHIP 24S RANGE 04W SEC. 15 PLSS # 046060

Date: 11/24/2005 By: X
This survey consists of:

DOUGLAS COUNTY OREGON DATE MARCH 5, 2015

Map: _____
Narrative: _____
Corner Rpt: CS67/42-16

Corner Designation

DOUGLAS COUNTY
SURVEYOR

ESE
DLC46

- Condition Report
- Not Found
- Renewed
- Unrecorded
- Surveyed In
- Referenced Out

Previous Renewals 1963, 1979, 1982 (FILED DATE, MON. FOUND IN '79 RENWL.)
Monument(s) Found: _____ (Condition and Source)

MONUMENT DETAIL

BENTZ 5/8 INCH I.R. NOT SEEN (MAY BE BURIED ON EDGE OF BC MONUMENT BELOW).

FROM THE 1979 BLM RENEWAL A 3 1/4 INCH DIAMETER BRASS CAP (MARKED AS AT RIGHT) ON A 2 1/2 INCH I.D. IRON PIPE FIRMLY SET PROTRUDING 6 INCHES ABOVE GROUND.

U.S. DEPT. OF THE INTERIOR
T24S R4W

DLC46/S15
S22
1979

BUR. OF LAND MANAGEMENT

Accessories Found

1982 BENTZ NOTED 18" SNAG GONE

BEARING OBJECT FROM 1979 BLM RENEWAL:
A 3 1/4 INCH DIAMETER BRASS CAP WITH THE STAMPING "T24S R4W S15"
FIRMLY SET PROTRUDING 4 INCHES ABOVE GROUND; RM
BEARS N83°E, 40± FEET DISTANT (RECORD N85 1/2°E, 40± FT.). ←
1979

A 5" DAK BT IS GONE (REMOVED BY LAND CLEARING).

THE BC MONUMENT FOR S15/S14 BEARS EAST 299± FEET DISTANT (BENTZ RECORD N89 1/4°E, 299± FEET). S22/S23

C.S. File 67/42-16

Monument Set (Procedure and Description)

MONUMENT DETAIL

N/A

N/A


New Accessories

A 10 INCH DIAM. INCENSE CEDAR SCRIBED "ESE DLC46 CS" "BT" ON A DOUBLE BLAZE; BEARS S60 1/2°W, 54 1/2 FEET DISTANT.

A 5 INCH DIAM. DOUGLAS FIR SCRIBED "X" "CSBT" ON A HIGH-LOW BLAZE; BEARS N27°W, 4 1/2 FEET DISTANT.

Sketch of Monument, Accessories, and General Area

Location & Comments

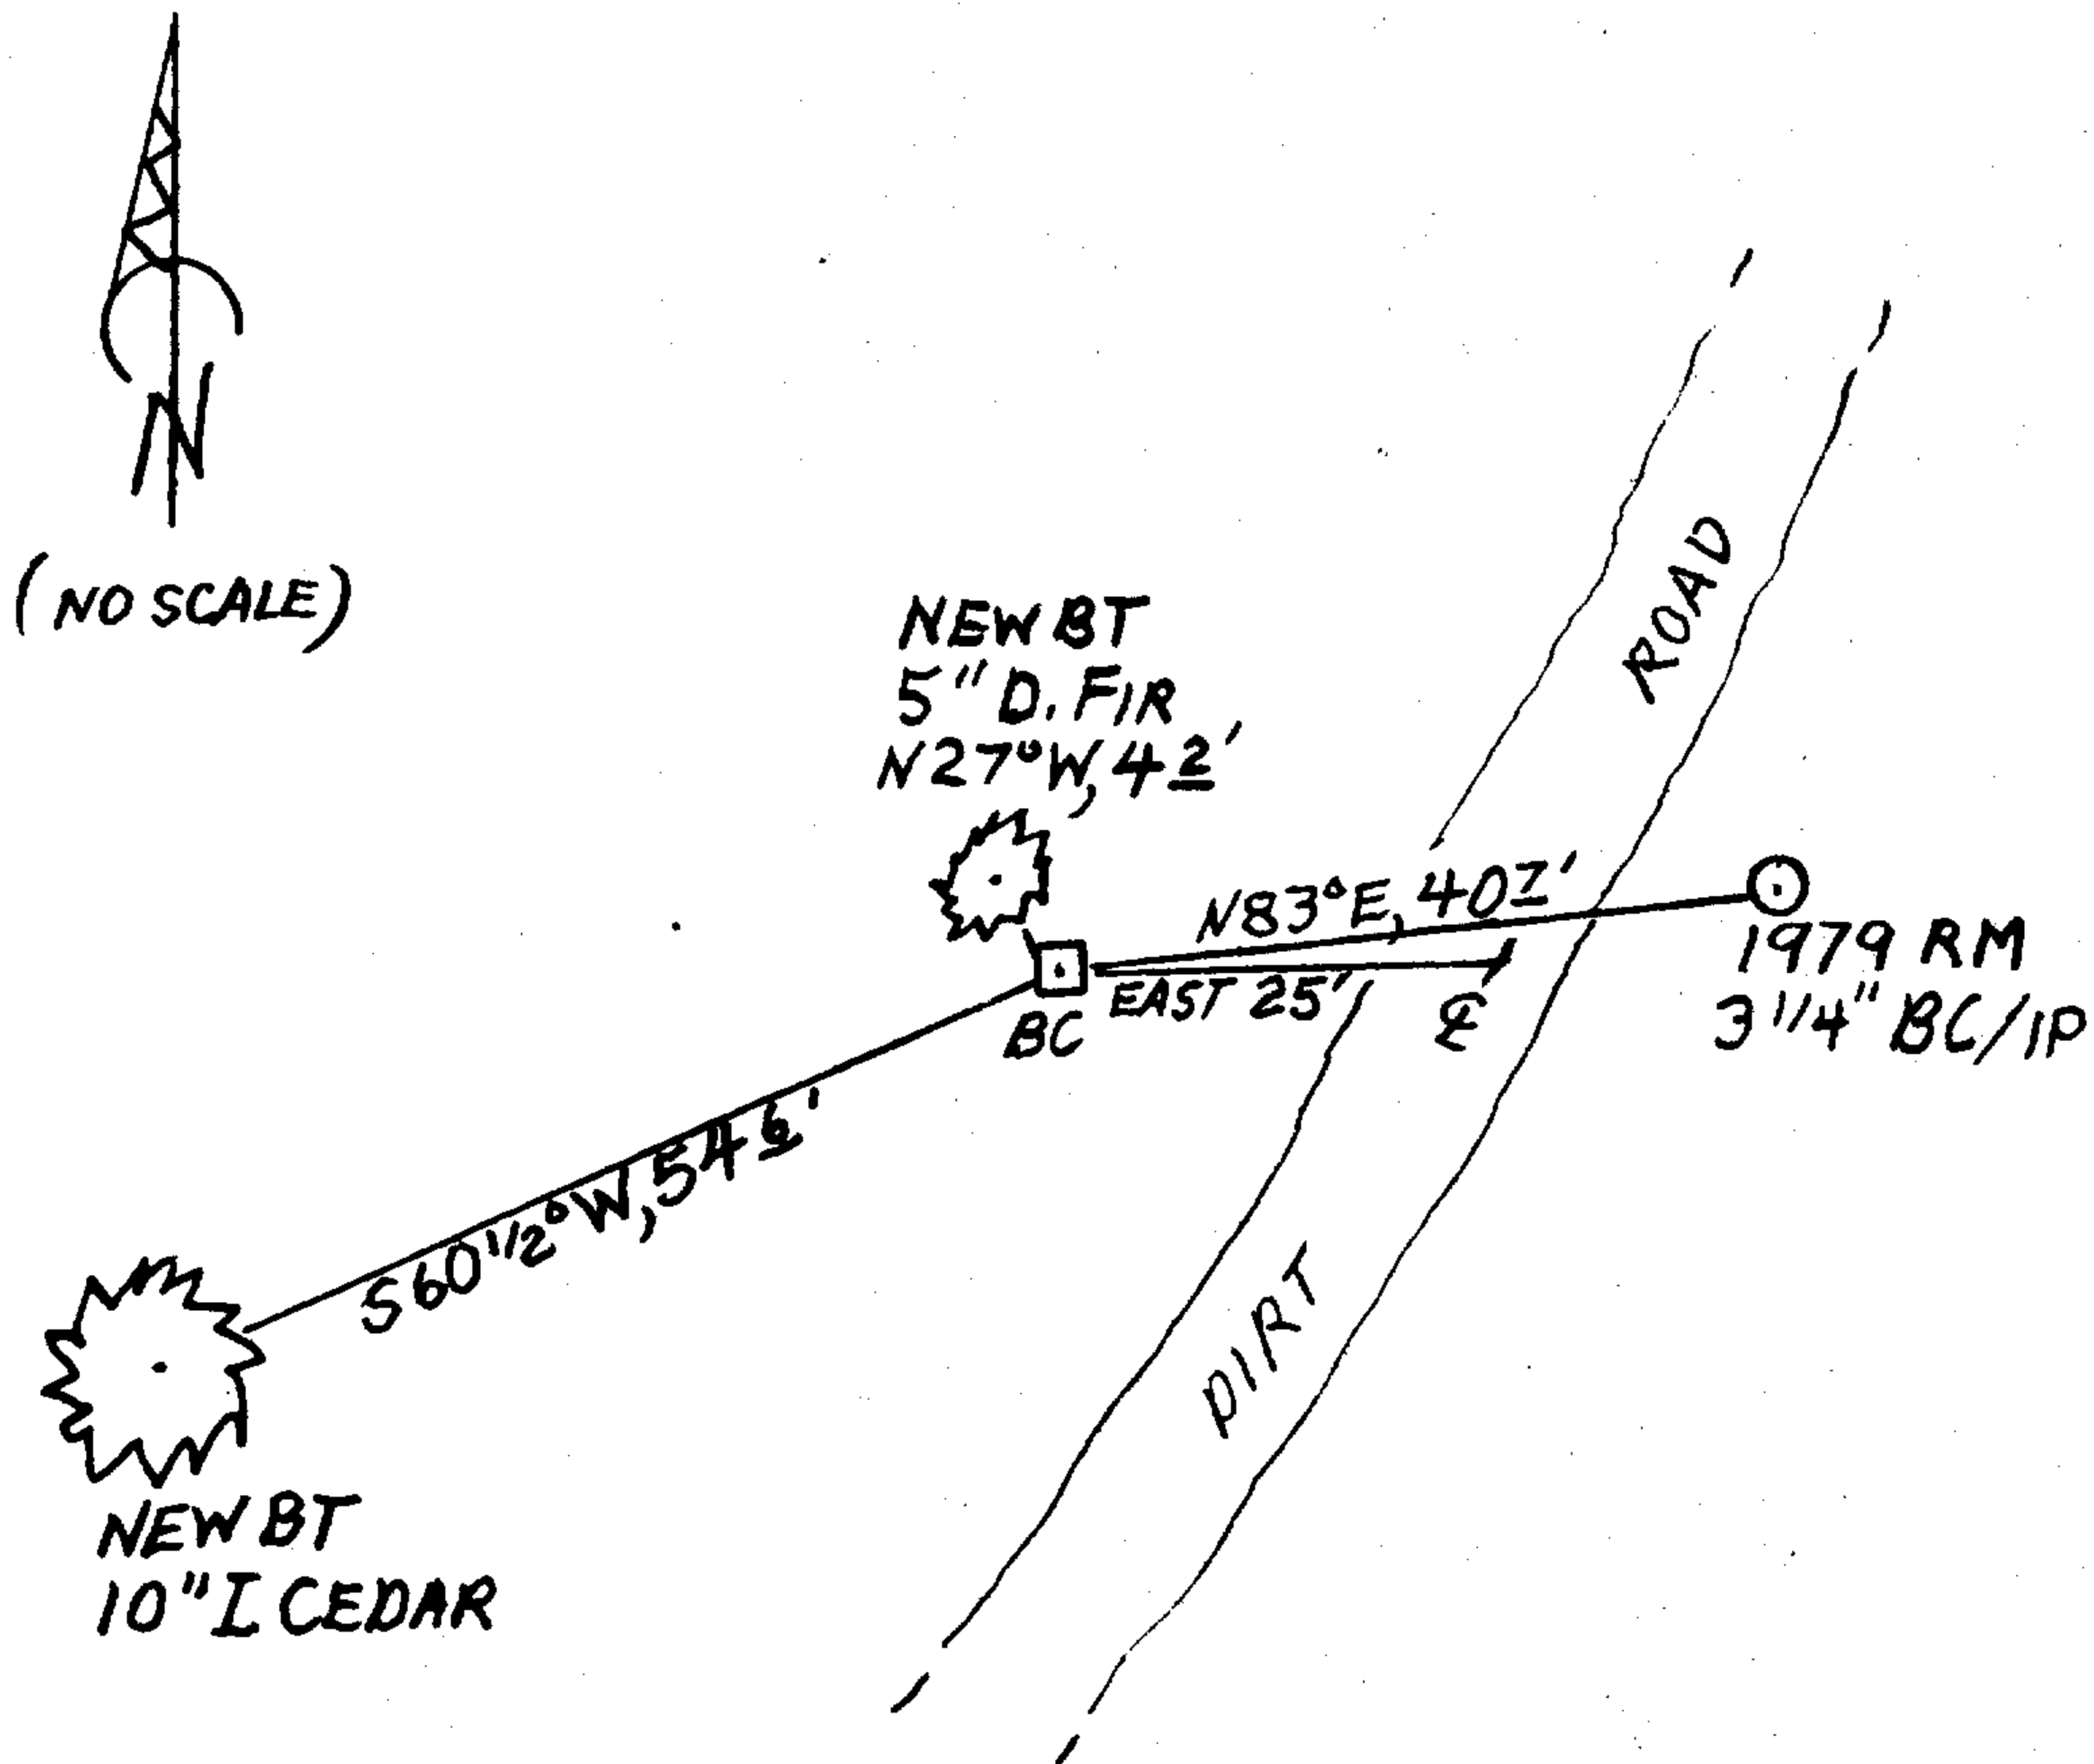

CORNER MONUMENT IS APPROX. 30 FEET EASTERLY FROM TOP OF NE-SW RUNNING HIGH RIDGE. MONUMENT IS IN SCATTERED FIR, CEDAR, OAK AND MADRONE REPROD.

Comp. Decline. 15 1/4°E
Agency DCSD
Party Chief STEPHEN JOHN FRAUSE
Note keeper Stephen John Frause
Witnesses MIKE S. KOCH

Surveyor's Seal

REGISTERED PROFESSIONAL LAND SURVEYOR

Kristian O. DeGroot

OREGON
JULY 17, 1981
KRISTIAN O. DeGROOT
1941

RENEWAL 12/31/15