

GOVERNMENT CORNER RESTORATION FORM

FILED

TOWNSHIP 24S RANGE 04W SEC. 27 PLSS # 043010

Date: 11-24-2015 By: X

This survey consists of:

DOUGLAS COUNTY OREGON

DATE MARCH 11, 2015

Map: \_\_\_\_\_

Narrative: \_\_\_\_\_

Corner Designation

Corner Rpt: CS 67/42-20

DOUGLAS COUNTY  
SURVEYOR

NE  
DLC43

- \_\_\_\_\_ Condition Report
- \_\_\_\_\_ Not Found
- Renewed
- \_\_\_\_\_ Unrecorded
- \_\_\_\_\_ Surveyed In
- \_\_\_\_\_ Referenced Out

Previous Renewals 1963  
Monument(s) Found: (Condition and Source)

MONUMENT DETAIL

COUNTY SURVEYORS OFFICE  
T24S

NE | R  
DLC | 4  
43 | W

1963

FROM THE 1963 RENEWAL A 2 1/2 INCH DIAMETER  
BRASS CAP (MARKED AS AT RIGHT) ON A 1 INCH I.D.  
IRON PIPE, FIRMLY SET AND PROJECTING 14  
INCHES ABOVE GROUND.

Accessories Found

ONE ORIGINAL BT:  
AN OAK 18" DIA. NOW A 38 INCH DIAM. WHITE OAK HEALED OVER PREVIOUSLY OPENED  
BLAZE; BEARS N80°E, 122 1/2 FEET DISTANT (RECORD N80°E, 125 1/2 FEET IS A GOOD  
SLOPE) DISTANCE AS NOTED IN 63 RENEWAL. NO EVIDENCE OF SW BT REMAINS.

ONE 1963 RENEWAL BT:  
A 12" W. OAK NOW A 13 INCH DIAM. WHITE OAK WITH A FULLY HEALED SINGLE BLAZE;  
BEARS N81°W, 15 1/2 FEET DISTANT (RECORD N81°W, 16 1/2 FEET IS A GOOD SLOPE  
MEASUREMENT).  
NO EVIDENCE OF NE RENEWAL TREE REMAINS.

C.S. File 67/42-20

Monument Set (Procedure and Description)

MONUMENT DETAIL

N/A


N/A

New Accessories

AN 11 INCH DIAM WHITE OAK SCRIBED "NE DLC 43 CS" "BT" ON A DOUBLE BLAZE; BEARS N18 1/2° E, 41 2/3 FEET DISTANT.  
A 15 INCH DIAM. WHITE OAK SCRIBED "NE DLC 43" "CSBT" ON A DOUBLE BLAZE; BEARS S13 1/2° W, 18 2/3 FEET DISTANT.

Sketch of Monument, Accessories, and General Area

Location & Comments

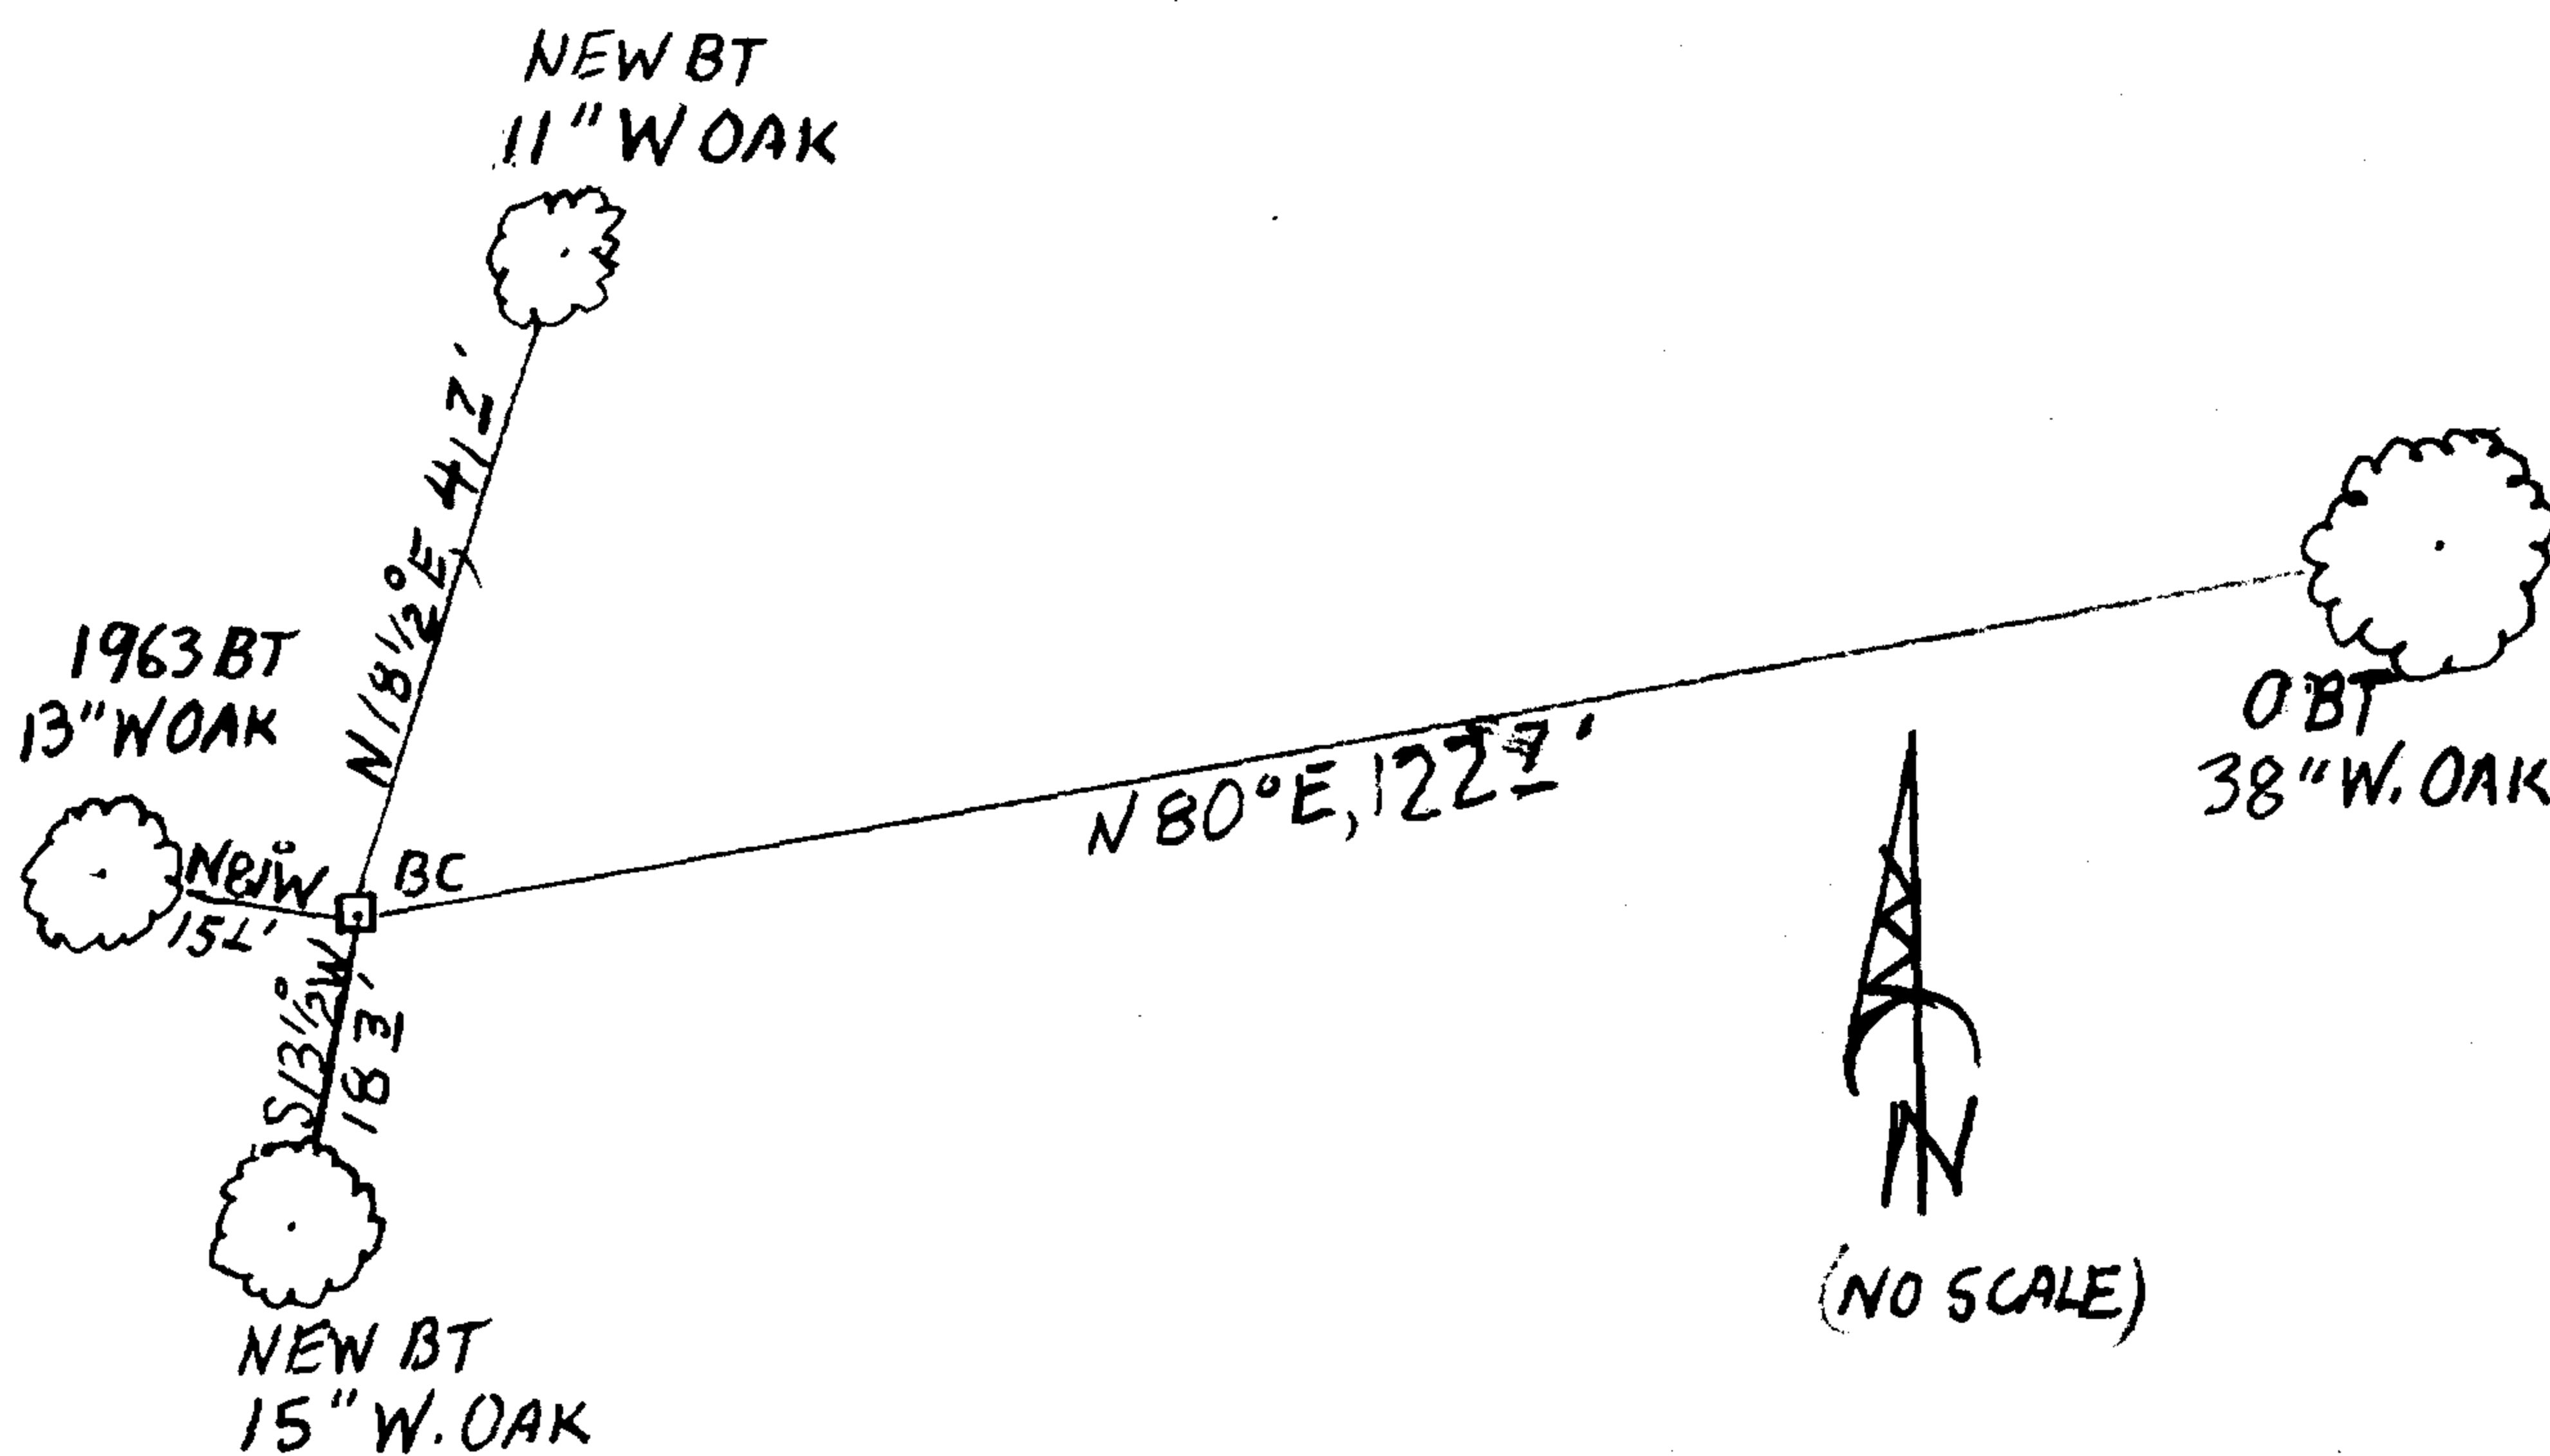

CORNER MONUMENT IS NORTH FACING SLOPE OF EASTERLY RUNNING DRAW. CORNER IS IN OPEN OAK WOOD.  
Comp. Decline. 15 1/4° E  
Agency DCSD  
Party Chief STEPHEN JOHN FLAUSE  
Note keeper Stephen John Flause  
Witnesses MIKE S. KOCH

Surveyor's Seal

REGISTERED PROFESSIONAL LAND SURVEYOR

*Kristian O. DeGroot*

OREGON  
JULY 17, 1981  
KRISTIAN O. DeGROOT  
# 1941

RENEWAL 12/31/15