

GOVERNMENT CORNER RESTORATION FORM

FILED

TOWNSHIP 24S RANGE 04W SEC. 15 PLSS # 460400

Date: 11-24-2015 By: JC

DOUGLAS COUNTY OREGON

DATE MARCH 13, 2015

This survey consists of:

Map: _____

Narrative: _____

Corner Rpt: CS 67/42-21

Corner Designation

DOUGLAS COUNTY
SURVEYOR

E 1/16 $\frac{S15}{S22}$

- Condition Report
- Not Found
- Renewed
- Unrecorded
- Surveyed In
- Referenced Out

Previous Renewals NONE
Monument(s) Found: _____ (Condition and Source)

MONUMENT DETAIL

U.S. DEPT. OF THE INTERIOR

E 1/16 $\frac{S15}{S22}$

1979

BUR. OF LAND MANAGEMENT

ORIGINAL 1979 MONUMENT:
A 3/4 INCH DIAMETER BRASS CAP (MARKED AS
AT RIGHT) ON A 2 1/2 INCH I.D. IRON PIPE, FIRMLY
SET PROTRUDING 2 INCHES ABOVE GROUND.
CORNER FALLS IN AN E-W FENCE LINE.

Accessories Found

THE TWO ORIGINAL BEARING TREES:
AN OAK, 8 INS. DIAM., NOW A 14 INCH DIAMETER BLACK OAK WITH A FULLY HEALED SINGLE
BLAZE; BEARS N45 1/4° E, 24 1/2 FEET DISTANT (RECORD N45 1/4° E, 25 FT. IS A SLOPE DIST.).
A FIR, 9 INS. DIAM., NOW A 25 INCH DIAMETER X 2 FOOT TALL SAWED DOUGLAS FIR STUMP
WITH A FULLY HEALED SINGLE BLAZE; BEARS S67 3/4° E, 71 1/2 FEET DISTANT (RECORD
S67 3/4° E, 72 1/2 FEET IS APPROX. SLOPE DIST.).

C.S. File 67/42-21

RENEWAL

Monument Set (Procedure and Description)

MONUMENT DETAIL

N/A


N/A

New Accessories

A 12 INCH DIAM. WHITE OAK SCRIBED "E 16522" "CSBT" ON A DOUBLE BLAZE; BEARS S48°E, 33 1/2 FEET DISTANT.

Sketch of Monument, Accessories, and General Area

Location & Comments

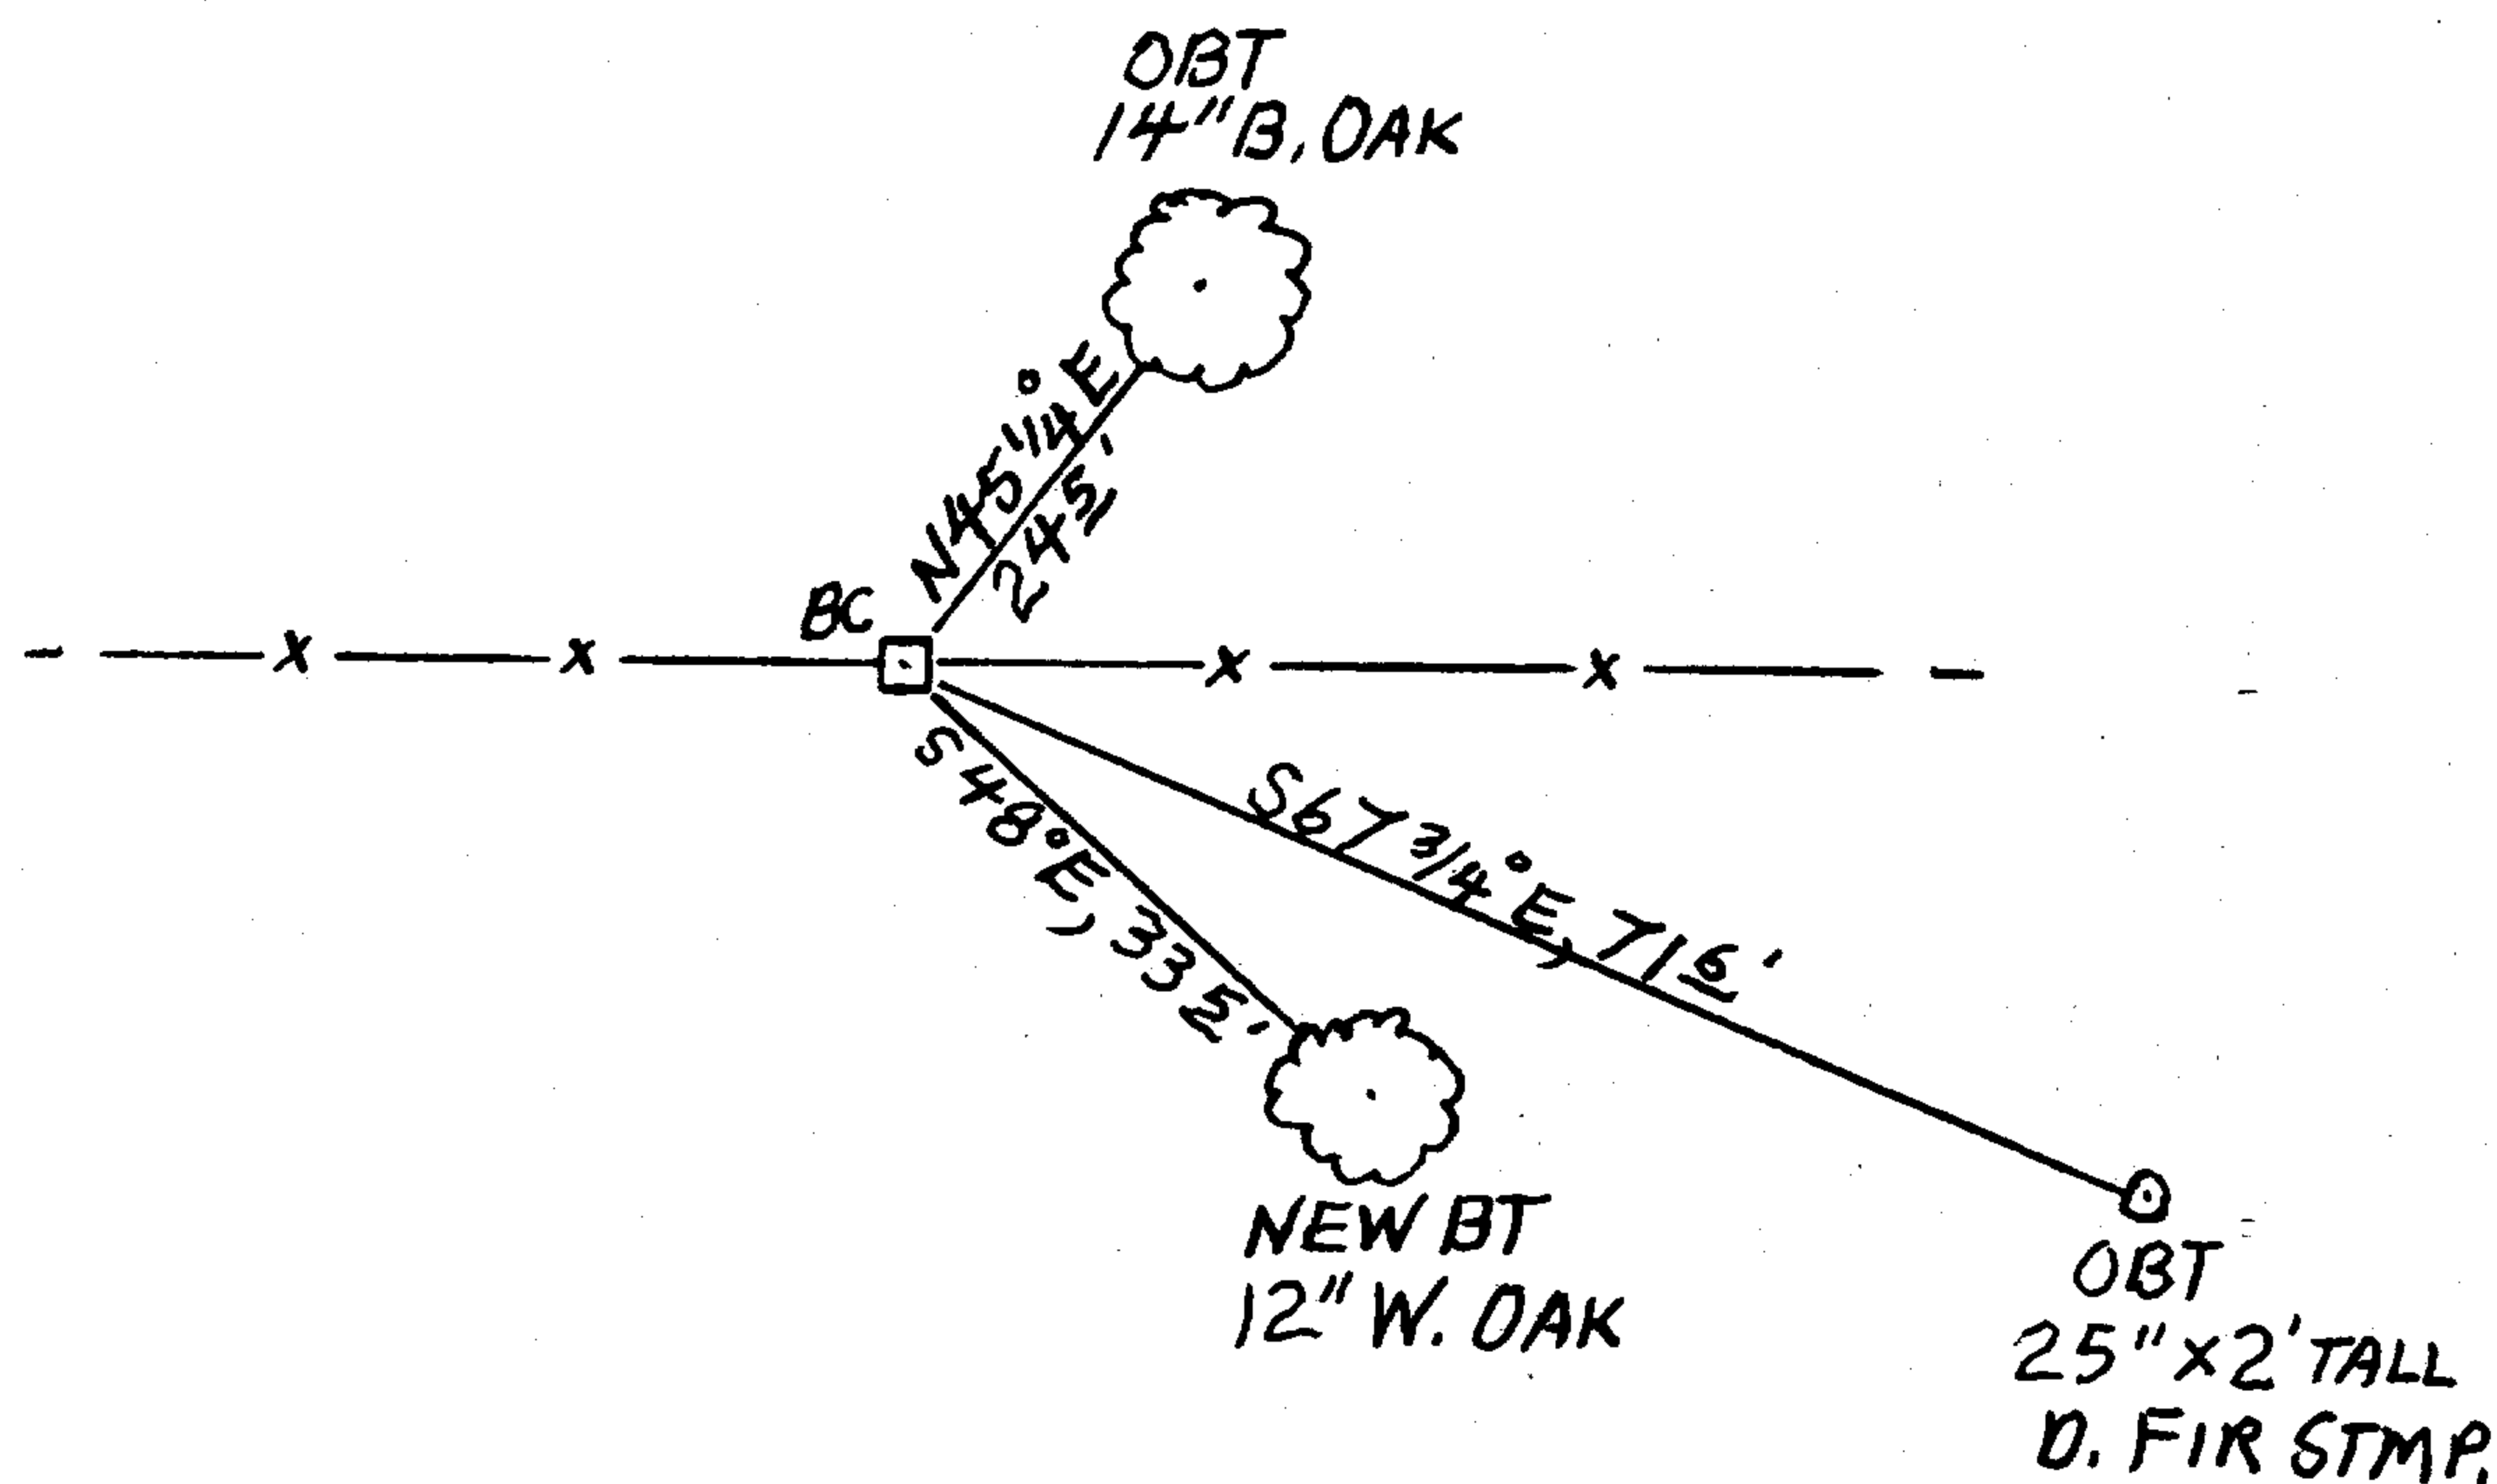

CORNER MONUMENT IS IN BOTTOM OF VERY SHALLOW, WESTERLY RUNNING DRAW. DENSE OAK AND FIR FOREST TO NORTH, CLEAR-CUT TO SOUTH.

Comp. Decline. 15 1/4° E
Agency DCSO
Party Chief STEPHEN JOHN FLAUSE
Note keeper Stephen John Flause
Witnesses MIKE S. KOCH

Surveyor's Seal

REGISTERED
PROFESSIONAL
LAND SURVEYOR

Kristian O. DeGroot

OREGON
JULY 17, 1981
KRISTIAN O. DeGROOT
1941

RENEWAL 12/31/15