

GOVERNMENT CORNER RESTORATION FORM
DOUGLAS COUNTY SURVEYOR

TOWNSHIP 31 SOUTH RANGE 1 WEST SECTION 33 PLSS/GCDB No. 31-01-340100

CORNER DESIGNATION: South 1/4 of Section 33 only

CORNER HISTORY, PREVIOUS RENEWALS OR SURVEYS:

- SEE DCSO SURVEY & CORNER RECORDS FOR PLSS 31-01-340100

MONUMENT (CONDITION AND SOURCE):

- Found a 1" i.d. iron pipe, firmly set, projecting 15" above the ground in a rough mound of stone with a 2 1/2" diam. brass cap marked as noted:

ACCESSORIES (CONDITION, SOURCE & RECORD):

An original bearing tree by D. Hathorn, USGLO Deputy Surveyor, in 1857:

- A 48" diam. I. cedar is uprooted and tipped out of the roothole which bears S.25°W., 34.3 feet. (Rec. S.15°W., 52 lks.)

And a bearing tree by R. Moore, USGLO Deputy Surveyor, in 1883:

- A 30" diam. x 3' tall rotted D. fir stump bears N.3°E., 19.1 feet with no evidence of blaze remaining.

And bearing trees by J.Powell, Douglas County Surveyors Office, in 1968 per C.S. File 54/71-21:

- A 22" diam. D. fir bears N.31° E., 46.6 feet, with a fully healed blaze. (Rec. N. 42° E.)
- A 33" diam. double trunk I. cedar bears N.58 1/2°W., 41.5 feet, with a fully healed blaze on SE trunk. (Rec. N.54°W., 41.0 feet)

And a new Bearing Object:

- The brass cap monument for the corner of Sections 4 & 5 only of Township 32 South Range 1 West (32-01-300700) bears West, 150.8 feet.

LOCATION & COMMENTS:

The corner falls on the edge of mixed timber cut line with fences running North and West and is located approximately 300 ft. north of an access road.

All bearing trees have BT Tags attached. All new bearing trees have double blazed faces with bearing measured to the center of the tree at the root crown and distances measured to a 4" mag spike in the side and center of the root crown.

GEODETIC COORDINATES
LATITUDE: 42°49'43.33"N.
LONGITUDE: 122°50'00.12"W.
DATUM: NAD 83
SOURCE: GeoXT6000
OREGON SOUTH-ZONE 3602:
FILE PATH: \\dcdnas\TraversePC\Corner Renewal DCSO\2019


COMPASS DECLINATION: 14 3/4° E.
AGENCY:DCSO
PARTY CHIEF: S. J. Flause
WITNESSES: J. Lorsung
NOTES: ATTACHED

FILED
Date: 1-28-2021
By: JC
Corner Form: CS 67/48-21
Field Notes: Attached
5 Pgs
DOUGLAS COUNTY SURVEYOR

DATE: June 4, 2019

- Condition Report Only
- Not Found
- Renewed
- Unrecorded
- Surveyed In
- Referenced Out

MONUMENT DETAIL

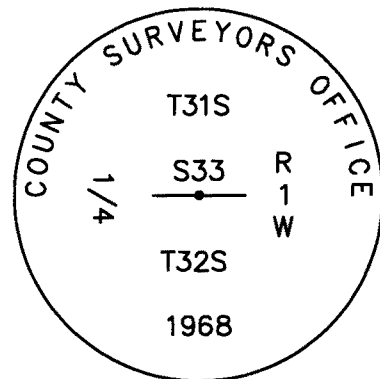

REGISTERED
PROFESSIONAL
LAND SURVEYOR
Kristian O. Degroot
OREGON
JULY 17, 1981
KRISTIAN O. DEGROOT
1941
RENEWAL DATE: 12-31-2021

CS 67/48-21

(1)

Filed 1/28/2021

PLSS: 340100

T31S, R01W, SEC 33

DATE: JUNE 4, 2019

S1/4 ONLY

CREW:

PARTY CHIEF - S. J. FLAUSE

TECH - J. A. LORSUNG

FOUND:

MONUMENT FROM 1968 DCSD RE-
NEWAL; A 2 1/2" DIA. BRASS CAP ON
A 1" I. D. IRON PIPE IN A ROUGH MOUND OF
LARGE STONES (NOT DISTURBED TO SEARCH
1883 STONE MON.) PROJ.: 15" ABOVE
BRASS CAP MARKED GROUND

AS FOLLOWS "

COUNTY SURVEYORS OFFICE"

ONE 1857

T31S

O.B.T FOUND

1/4

S33 R

A FALLEN 48"

T32S W

DIA. L. CEDAR WITH

1968

BLAZE SCAR NO LONGER EVIDENT. THE
CENTER OF THE VERY LARGE ROOTHOLE
BEARS S25°W, 34³ FT. DISTANT (BEARING
IS 1968 REC., DIST. IS 1857 REC.)

EVIDENCE OF ONE 1883 B.T.; A ROTTED
30" DIA., 3 FT. TALL D. FIR STUMP WITH

→
OVER

CS 67/48-21

(2)

(2)

T315, R01W, PLSS 340100 CONT'D

NO BLAZE OR SCRIBE EVIDENCE REMAINING;
BEARS N03°E, 19¹/₂ FT. DISTANT (AS PER RECORD),

TWO 1968 DCSD RENEWAL B.T.'S:


A 22" DIA. N. FIR WITH A FHDB; BEARS
N31°E, 46⁶/₁₆ FT DISTANT (REC. N42°E, 46⁶/₁₆ FT.)

A 33" DIA. DOUBLE TRUNK I. CEDAR WITH
A FHDB ON SE TRUNK; BEARS N58¹/₂°W,
41⁵/₁₆ FT. DISTANT (REC. N54°W, 41⁰/₁₆ FT.)

SECTION COR. 4 & 5 WEST, 1508 FT (REC. WEST 150¹/₁₆ FT.)
DECLINATION 14¹/₂°E

FENCE CORNER AT MONUMENT HAS FENCES
RUNNING NORTH AND WEST NOT SOUTH AND WEST

CS 67148-21 (3)

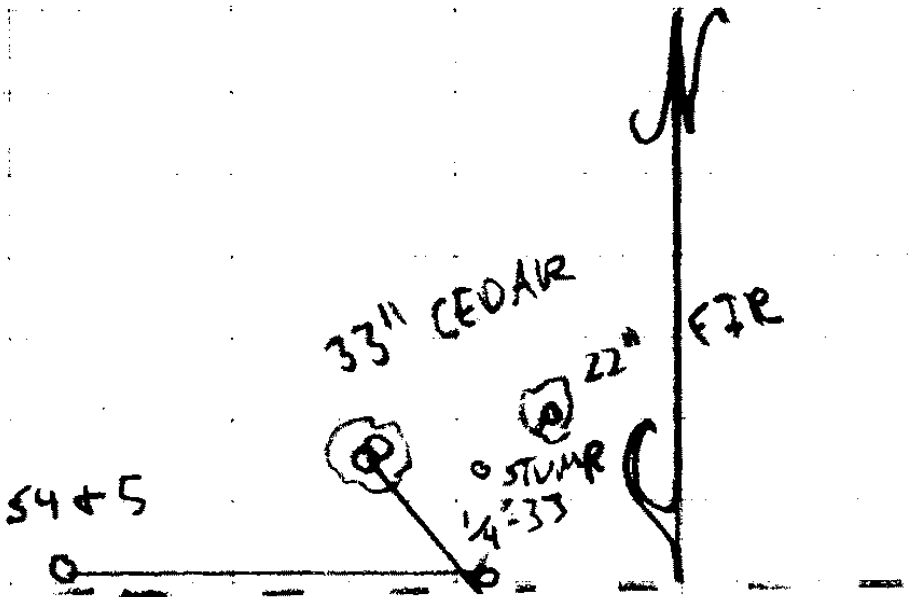

FENCE LINE

ACCESS ROAD

CS 67 / 48-21 (4)

TOWNSHIP 31 RANGE 01 POINT IDENTIFIER # 340100
~~302700~~

PRIMARY CORNER DESCRIPTION So. 1/4 Cor. for Sec. 33 only, T31-1

Alias _____ Description _____
Alias _____ Description _____
Alias _____ Description _____
Alias _____ Description _____

GLO survey by Dennis Hathorn, Deputy Surveyor under Contract #73, dated June 8, 1857 - (DCSO records Vol. 18 Page(s) 7461)

Set 1/4 sec. post, from which
A Fir 30" dia. bears N.30°W., 14 lks. dist.
A Cedar 36" dia. bears S.15°W., 52 lks. dist.

GLO Survey by Rufus S. Moore, Deputy Surveyor, under Contract #475, dated July 3, 1883 - (DCSO records Vol. 18 Page(s) 7488)

The old 1/4 sec. cor. on S. bdy. of sec. 33, which is a decayed post, with 1 BT still standing. I destroyed this post and replaced it with a basalt stone 14x10x8 ins. 10" in the ground mkd. 1/4 on N. face, from which
A Cedar 40" dia., bears S.15°W., 52 lks. dist. mkd. 1/4 S BT
A Fir 36" dia., bears N.3°E., 29 lks. dist. mkd. 1/4 S BT.
The Cedar is the one described in field notes of original survey and was newly marked.

Douglas Co. Surveyors Office - John M. Powell, and crew - July/Aug. 1968 - C.S. File 54/71-21
~~NOT SEEN~~ ----- P-----
Found - 14x10x8 corner stone mkd. with "1/4" on the N. face.
~~40"~~ **FALLEN 48"** now **16"** Cedar S.15°W., ~~39.0~~ **34.3** ft. (Rec. S.15°W., 34.3 ft.) shows scribing. **343**
30" DIA 3 FT TALL Fir now ~~30"~~ **36"** stump, N.6°E., 17.1 ft., opened and found scribing ("**1/4** BT") **✓** **PRD 15" BY GRND. IN ROUGH STAMPING**
Set Brass cap at cor. mkd: County Surveyors Office
T31S R1W 1/4 S 33
T32S R1W 1968
New BTs- 14" Cedar N.54°W., 41.0 ft. mkd. 1/4 S33 CS BT. **FHDB**
D. FIR 22" 12" Fir N.42°E., 40.6 ft. mkd. 1/4 S33 CS BT. "
Cor. lies in ~~W~~ **N**-W fence corner 150.1 ft. East of the sec. cor. to 4 & 5, T32-1W. and 300 ft. North of a road.

Fd. OK, Dec. 1992 by Kaiser - M 116-30

↓
COUNTY SURVEYORS OFFICE
T31S
1/4 S33 R
T32S W
1968 1

72
6
312
312
343

CS 67/48-21 (5)