

GOVERNMENT CORNER RESTORATION FORM
DOUGLAS COUNTY SURVEYOR

FILED
Date: 6/21/2021
By: JC
Corner Form & Field Notes:
C.S. File: 67/49-13
CDPS
DOUGLAS COUNTY SURVEYOR

TOWNSHIP 25 SOUTH RANGE 8 WEST

PLSS/GCDB No. 25-08-600540

CORNER DESIGNATION: 1/4 Corner of Sections 11 & 12

DATE: February 21, 2019

CORNER HISTORY, PREVIOUS RENEWALS OR SURVEYS:


- SEE DCSO SURVEY & CORNER RECORDS FOR PLSS 25-08-600540
- The corner was restored from original evidence by Donald R. Beck and John M. Jelley in 1964 under a USBLM Dependent Resurvey.

Condition Report Only
 Not Found
 Renewed
 Unrecorded
 Surveyed In
 Referenced Out

MONUMENT (CONDITION AND SOURCE):

- Found a 2 1/2" o.d. iron pipe by Beck and Jelley in 1965, firmly set, projecting 5" above the ground with a 3 1/4" diam. brass cap marked as noted:

MONUMENT DETAIL

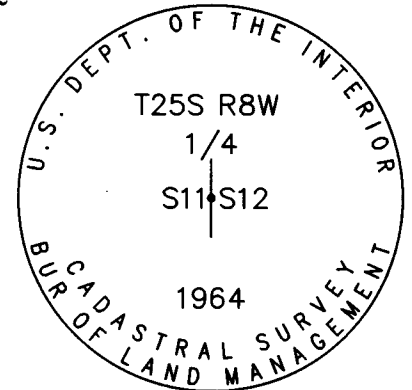

ACCESSORIES (CONDITION, SOURCE & RECORD):

No evidence of the original bearing trees by Flint in 1881.

Bearing trees by Beck and Jelley in 1964:

- A 16" diam. x 5' tall sawn fir stump bears N. 5 1/2° E., 37.0 ft. with a healed blaze. (Rec. N. 4 1/2° E.)
- NW bearing tree down and rotted.

A bearing tree by Johnstone in 1983 per M 94-63:

- A 13" diam. W. fir bears S. 11° W., 27.7 ft. with a healed blaze. (Rec. S. 15° W.)

New bearing trees:

- A 7" diam. D. fir bears N. 88° E., 9.6 ft. scribed "X" & "BT" on a double blaze.
- A 49" diam. D. fir bears N. 43 1/2° W., 25.0 ft. scribed "1/4S11" and "CSBT" on a double blaze.

LOCATION & COMMENTS:

Corner lies in old growth forest 90 ft. West of improved forest road. Old growth to the West with Reprod to the East.

All bearing trees have BT Tags attached. All new bearing trees have double blazed faces with bearing measured to the center of the trees at the root crown and distances measured to a 4" MAGHUB nail in the side and center of the root crown.

GEODETTIC COORDINATES
LATITUDE: NO GPS AVAIL.
LONGITUDE:
DATUM: NAD 83
SOURCE: GeoXT6000
OREGON SOUTH-ZONE3602:
FILE PATH: \\DCNAS\Surveyor\SurShared\TraversePC\Corner Renewal DCSO\2019

COMPASS DECLINATION: 14 3/4° E.
AGENCY: DCSO
PARTY CHIEF: S. J. Flause
WITNESSES: J. Lorsung
NOTES: ATTACHED

CS 67/49-13
(i)

REGISTERED
PROFESSIONAL
LAND SURVEYOR

Kristian O. Degroot
OREGON
JULY 17, 1981
KRISTIAN O. DEGROOT
1941

RENEWAL DATE: 12-31-2021

PLSS: 600540

T25SR08W S11

DATE: FEB. 21, 2019

CREW: ^{1/4}S11/S12

S.T. FLAUSE: PARTY CHIEF

JEFF LORSUNG: TECH.

MONUMENT: A 3 1/4" DIA. BRASS CAP
ON A 2" I.D. IRON PIPE, MARKED AS FOLLOWS."U.S. DEPT. OF THE INTERIOR"
T25SR08W^{1/4}S11/S12


PROJ: 5 INCHES

FOUND: BUR. OF LAND MANAGEMENT
1964

NO CLEAR EVIDENCE OF OBT'S

FROM 1964 BLM SURVEY: A 16" DIA., 5 FT TALL
SAWN FIR STUMP WITH A FULLY HEALED SINGLE BLAZE
BEARS N5 1/2° E, 37° FT. DISTANT. NW BT DOWN
ROTTEN AWAY.FROM 1983 JOHNSTONE SURVEY: A 13" DIA. WHITE FIR
NEW: WITH A FULLY HEALED SINGLE BLZ. S11° W, 27° FT.
DIST.A 7" DIA. D. FIR SCRIBED "X" "BT" ON A
HIGH-LOW BLAZE; BEARS N88° E, 9 1/2 FT. DISTANT.A 49" DIA. D. FIR SCRIBED "1/4 S11" "CS BT"
ON A DOUBLE BLAZE; BEARS N43° 2' W, 25° FT. DIST.— OLD GROWTH FOREST WEST OF MON. YOUNG
REPROD TO EAST,
MON. 90 FT. WEST FROM IMPROVED FOREST RD.

SKETCH

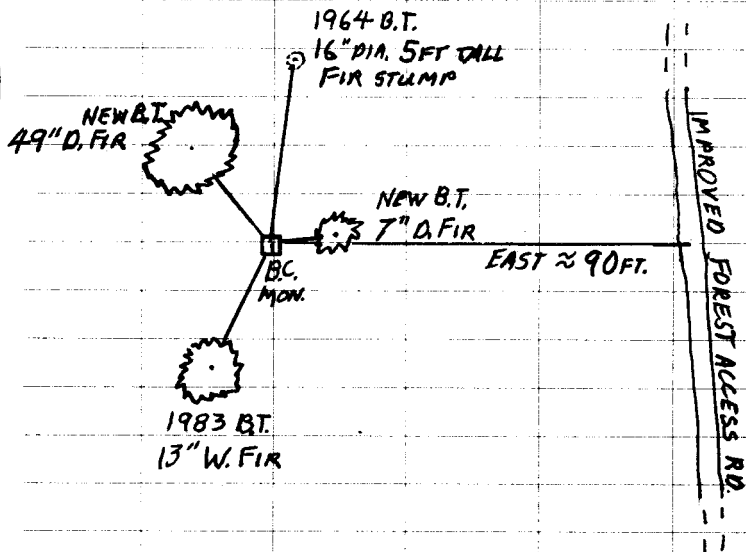

DECLINATION: $14\frac{3}{4}^{\circ} E$

CS 67/AA-13 (3)

2/21/19

TOWNSHIP 25 RANGE 08 POINT IDENTIFIER # 600540

PRIMARY CORNER DESCRIPTION 1/4 Cor. Secs. 11 & 12

Alias _____	Description _____
Alias _____	Description _____
Alias _____	Description _____
Alias _____	Description _____

GLO Survey by - A.R. & S.C. Flint, Under Contract #392, dated May 26, 1881 (DCSO records Vol. 9 Page(s) 3940)

Set 1/4 sec. cor. post 3 ft. long & 3" sq. from which
 A fir, 16" dia., bears N.10°E., 27 lks.
 A fir, 14" dia., bears N.55°W., 35 lks.

BLM dependent resurvey by Donald R. Beck & John M. Jelley, Cadastral Surveyor, under group #'s 350 & 563 surveyed Sept. 1964/July 1965 - (DCSO records 33 Page(s) 13769)

The 1/4 sec. cor. of secs. 11 & 12 determined at record bearing & dist. from the orig. NE BT & rec. dist. from the NW BT:
 A fir, 40" dia., bears N.10°E., 27 lks., with fragmentary scribe marks visible on a bark blaze. Remarked BT alongside orig. blaze, with a knife or axe.
 A Fir 26" dia., bears N.52 3/4°W., 35 lks., with no marks remaining. (Rec. N.55°W.)

At the corner point
 Set an iron post, 28" long, 2 1/2" dia., 21" in the ground, with brass cap marked: *PROV 5"* T25S R8W *US. DEPT. OF THE INTERIOR*
 S 11 S 12
 1964 *✓ BUR. OF LAND MANAGEMENT*

from which new BTs
5 1/2 A fir, 7" dia., bears N.4 1/2°E., *37.0* lks., mkd: 1/4 S12 BT. *FLSH*
DOWN ROTTEN AWAY A fir, 7" dia., bears N.75 1/2°W., 61 lks., mkd: 1/4 S11 BT. *FLSH*

16" X 5" SAWN STUMP

Howard Johnstone - For: Roseburg Lumber Co. - Aug. 10, 1983 - M94-63

Found - 1964 cadastral brass cap & iron pipe.
 14" Fir, N.7°E., (rec. N.4 1/2°E.) 37.0 ft. healed
 7" Fir, N.75 1/2°W., 40.3 ft., down.
 New BT - 9" Fir, S.15°W., 27.7 ft. scribed. *FLSH*
13" W. FIR 11"

NEW BTs

7" D. FIR "X" BT HIGH-LOW BIZ N 88° E, 96

49" D. FIR "1/4 S11" CSBT N 43 1/2° W, 250 FT

OLD GROWTH TO WEST, YOUNG REFRAG TO EAST

90' WEST FROM IMPROVED FOREST RR

6

56
6
336
336

CS 62/49-13
(4)

1