

①

MARCH 27, 2017

T305, R4W, 037060

FILED

NOV 10 2021

MONUMENT FOUND:

FROM MARKHAM'S 1953

RENEWAL A 1 INCH I. D. IRON PIPE

PROTRUDING 6 IN. S ABOVE GROUND

AND LEANING  $0^{\circ}5'$  FT. NW OFF OF

PLUMB. MARKHAM DESCRIBED MON:

AS A 1" X 20" IRON PIPE WE FIND

IT TO MEASURE 16 IN. S LONG.

BEARING TREES FOUND:

POSSIBLE EVIDENCE OF O.B.T.:

THE 9" B. OAK NOW A DISTINCT

LARGE ROOT HOLE THE DEEPER PART

OF WHICH BEARS  $N 50^{\circ} W, 18^{\circ} 5'$  FT.

DIST. (AS PER RECORD).

EVIDENCE OF MARKHAM'S 1953

C.S. FILE 67/49-19

(2)

T305, R4W, 037060 CONT'D

RENEWAL BEARING TREES.

A 12" LAUREL, NOW THE ROTTEN  
AND BURNED REMAINS OF A MADRONE  
ROOT CROWN WITH 5 SPROUTED LIVING  
MADRONE TRUNKS ON IT'S EASTERLY  
EDGE. THE CENTER OF FOUND ROOT  
CROWN BEARS WEST  $36^{\circ}$  FT. DIST.  
(AS PER RECORD).

AN 18" B. OAK, NOW A LARGE  
BUT INDISTINCT ROOT HOLE IS  
FOUND NEAR RECORD B. AND D.

BYRON'S 1963 RENEWAL B.T.S.,  
SE B.T. GONE; OLD SKID-ROAD  
THROUGH LOCATION.

A 12" LAUREL NOW A 26 INCH  
DIAM. MADRONE STUMP WITH A

CS 67/49-19

(3)

T30S, R4W, 037060 CONT'D

F.H.D.B.; BEARS S24°W, 48<sup>B</sup> FT. DIST.

(RECORD S25°W, 52° FT. A REASONABLE  
SLOPE DISTANCE).

NEW MONUMENT SET:

PLUMB POSITION OF FOUND 1 INCH  
IRON PIPE IS ACCEPTED. POSITION IS  
REFERENCED OUT AND IRON PIPE  
IS REMOVED. AT THE REFERENCED  
POSITION IS SET A 2<sup>3/8</sup> INCH DIAM.

BRASS CAP, MARKED AS FOLLOWS,

" DOUGLAS COUNTY SURVEYOR "

T30S

SE

DLC37

R4W

2017

ON A 1 INCH I.D. X 32 INCH IRON PIPE

25 62/49-19

DIETZGEN NO. 385-5

(4)

T305, R4W, 037060 CONT'D

PROTRUDING 7 INS. ABOVE GROUND.

THE FOUND 1x16 INCH IRON PIPE  
IS SET ON SOUTH EDGE OF B.C./I.P.  
MONUMENT AND PROTRUDES 4 INS.  
ABOVE GROUND.

NEW B.T.S.:

A 10 INCH DIAM. D. FIR SCRIBED  
"SE DLC 37CS" "BT" ON A DOUBLE  
BLZ. ; BEARS N31°E, 18<sup>9</sup> FT. DIST..

AN 8 INCH DIAM. D. FIR SCRIBED  
"SE DLC 37" "CSBT" ON A DOUBLE BLZ.  
; BEARS S72°E, 14<sup>7</sup> FT. DIST..

A 14 INCH DIAM. MADRONE (MOST  
SOUTHERLY OF 5 MADRONE ROOT  
CROWN SPROUTS PREVIOUSLY  
NOTED IN FOUND 1953 B.T.'S)

CS 62149-19

(5)

T30S, R4W, 037060 CONT'D

SCRIBED "SE DLC 37" "CSBT" ON A  
DOUBLE BLZ. THE CENTER OF THE  
ROOT CROWN OF THE SCRIBED TRUNKS  
PARENT TREE BEARS, WEST  $36^{\circ}$  FT.  
DIST. (AS PREVIOUSLY NOTED).

THE CENTER OF THE BASE OF THE  
SCRIBED TRUNK ITSELF BEARS  
 $S86^{\circ}14' W, 34^{\frac{3}{4}}$  FT. DIST.

A 6 INCH DIAM. DOUGLAS FIR  
SCRIBED "X" "CSBT" ON A  
HIGH-LOW BLZ. BEARS  $N76^{\circ}14' W,$   
 $48^{\frac{1}{2}}$  FT. DIST.

THE SW CORNER OF DLC 40 (A DC50  
BRASS CAP MONUMENT) BEARS



$N01^{\circ}22' W, 657^{\frac{07}{10}}$  FT. (ORIGINAL AND  
1892 GLO RESURVEY, NORTH 660 FT; MARKHAM  
1953 RENEWAL OF SW DLC 40, NORTH 669 FT.)

CS 67149-19

5

(6)

T30S, R4W, 037060 CONT'D

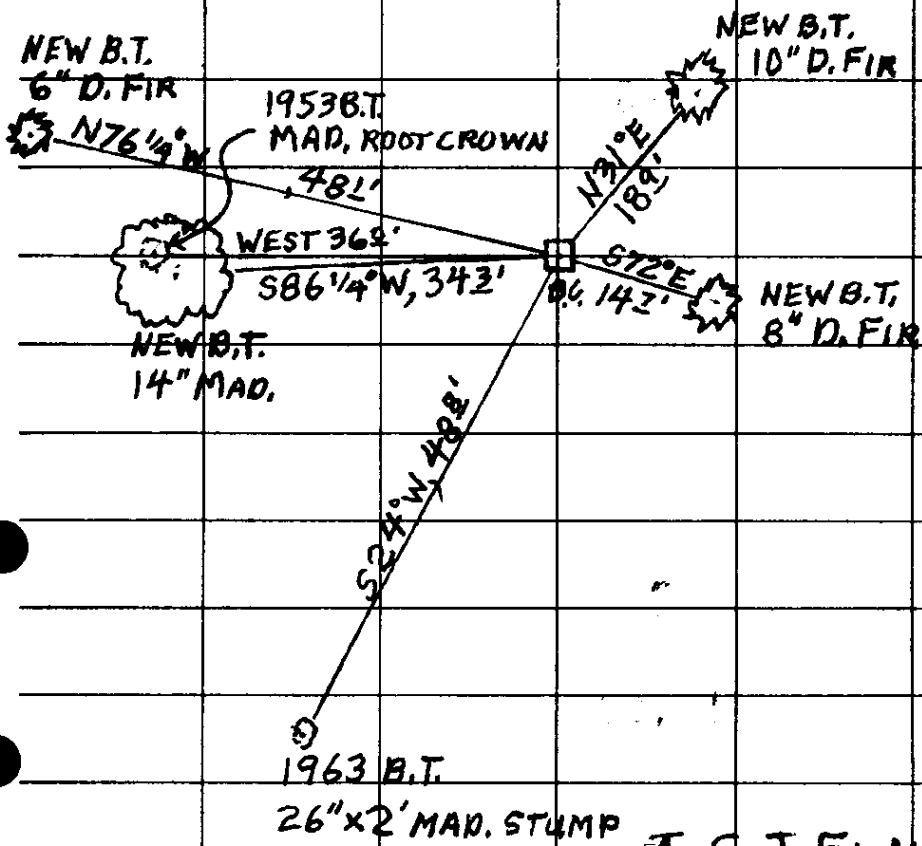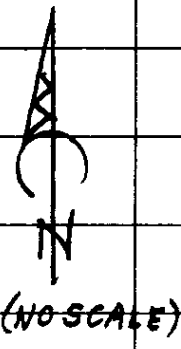

π S. J. FLAUSE

φ M. S. KOCH

☐ Stephen John Flause

CS 62/ 42-19

6