

GOVERNMENT CORNER RESTORATION FORM
DOUGLAS COUNTY SURVEYOR

TOWNSHIP 29S RANGE 03W SECTION 10 & 11

PLSS/GCDB No. 29-03-500540

CORNER DESIGNATION: 1/4 Corner of 10 & 11

FILED
Date: 11-10-2021
By: SC
Corner Form: CS67/49-24
Field Notes: 4 pgs total
DOUGLAS COUNTY SURVEYOR

CORNER HISTORY, PREVIOUS RENEWALS OR SURVEYS:

- See DCSO Survey & Corner records for PLSS 29-03-500540 The 1/4 Corner was restored by A Bert Skeesick for BLM in 2007 per DCSO record Vol. 57 page 22568.


DATE: October, 24, 2018

Condition Report Only
 Not Found
 Renewed
 Unrecorded
 Surveyed In
 Referenced Out

MONUMENT FOUND (CONDITION AND SOURCE):

- A 2 1/2" Diam. Iron Pipe with 3 1/4" brass cap firmly set and projecting 3" marked as follows:

MONUMENT DETAIL

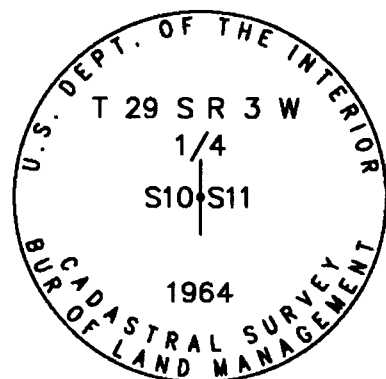

ACCESSORIES FOUND (CONDITION, SOURCE & RECORD):

Bearing Trees by Donald Beck for BLM in 1965:

- A 22" D. Fir bears N 52 1/4° E 23.1 ft. (record N 67° E)

Bearing Trees by Vernon Tracy for DCSO in 1967:

- A 28" D. Fir bears S 19 3/4° W, 92.7 ft.

NEW ACCESSORIES (PROCEDURES AND DESCRIPTION):

All new BT's measured to side center root crown marked with a 2 1/2" PK nail and double blazed:

- A 20" D. Fir bears S 23° E, 20.0 ft. scribed "1/4S11CS", "BT"
- A 17" D. Fir bears N 7 1/2° W, 7.3 ft. scribed "1/4S10", "CSBT"

LOCATION & COMMENTS:

All bearing trees have BT tags attached. All new bearing trees have double blazed faces with bearings measured to the center of the tree at the root crown and distances measured to the side and center of the root crown to a magnetic PK nail. Monument is located 45 ft. East of the center of roadway.

GEODETIC COORDINATES

LATITUDE:

LONGITUDE:

ELLIPSOID HEIGHT:

DATUM: NAD 83

SOURCE:

COMPASS DECLINATION: 15° E.

AGENCY: DCSO

PARTY CHIEF: S. J. FLAUSE

WITNESSES: J. LORSUNG

NOTES: ATTACHED

C.S. FILE 67/49-24

T295 R3W S10+11

10-24-18

MONUMENT:

3^L/₄ BLM BC FIRMLY SET PROT 3"
MARKED PER RECORD

FOUND:

BECK

22" FIR, N 52¹/₄° E, 23' (REC. N 67° E)

V. TRACY

28" FIR, S 19³/₄° W, 92'

ROAD LIES 45 FT WEST TO CENTER

NEW:

20" D. FIR, S 23° E, 20⁰/₄ SICS, "BT"

17" D. FIR, N 7¹/₂° W, 7³/₄ SLD, "CSBT"

CS 67/49-24

TOWNSHIP 29 RANGE 03 POINT IDENTIFIER # 500540

PRIMARY CORNER DESCRIPTION 1/4 Cor. for Secs. 10 and 11

Alias _____	Description _____
Alias _____	Description _____
Alias _____	Description _____
Alias _____	Description _____

GLO survey by W. H. Byars, Deputy Surveyor, under Contract #376, dated Jan. 22, 1881 - (DCSO records Vol. 15 Page(s) 6337)

Set Fir post for the 1/4 sec. cor., from which
A Fir 8" dia., bears N.80°W., 3 lks. dist.
A Fir 8" dia., bears East, 8 lks. dist.

BLM resurvey by Donald Beck, Cadastral Surveyor, under Group #554 - Surveyed July 1964/April 1965 - (DCSO records Vol. 33 Page(s) 13802-03)

The 1/4 sec. cor., monumented with rotted portions of the original corner post, below the surface of the ground, from which the remains of an original bearing tree:

A rotted Fir root crown, size indeterminate, bears East, 8 lks. dist.

At the corner point ^{3 1/4"} U.S. CADASTRAL SURVEY
Set an iron post, 28" long, ^{B.C.} 2 1/2" dia., 24" in the ground, with brass cap mkd: T 29 S R 3 W

^{1/4} S 10 | S 11
1964
PROT 3"

from which new bearing trees: BUREAU OF LAND MANAGEMENT

²² A Fir 12" dia., bears N. ^{87°E.} 35 lks. dist., mkd. 1/4 S11 BT.

A Fir 7" dia., bears N. ^{52 1/4°} 84 1/2° W., 123 lks. dist. mkd. 1/4 S10 BT.

Corner falls in old rail fence which bears N. and S.

Douglas Co. Surveyors Office - Vernon "Ray" Tracy, and crew - June 28, 1967 - C.S. File 52/126

Found - 1964 Cadastral brass cap, firmly set and properly marked.

²² 12" now 13" Fir N. ^{52 1/4°} 53° E., 23.1 ft., alive, scribe marks visible on partially healed blaze. (Rec. N.67°E.)

7" now 8" Fir N.84 1/2° W., 81.2 ft., alive, scribe marks visible on partially healed blaze. (This tree to be removed for cultivation of field.)

New BT ^{28"} 28" D.Fir S. ^{20°} 20° W., 92.7 ft. mkd. 1/4 S10 CS BT. FHDB
This corner lies ⁴⁵ 40 ft. East of roadway, course N & S.

Fd. OK by D. Edwards, Oct. 1998 - M130-67

continued next page ⁵ 193/4 W
AGREES WITH BLM REC

CS 67/49-24

KEN CANNON

521
738
734
818

TOWNSHIP 29 RANGE 03 POINT IDENTIFIER # 500540

PRIMARY CORNER DESCRIPTION 1/4 Cor. for Secs. 10 and 11

Alias _____ Description _____
Alias _____ Description _____
Alias _____ Description _____
Alias _____ Description _____

BLM Dependent Resurvey by A Bert Skeesick, Cadastral Surveyor and Robert H Browning, Survey Tech, Under Group No. 2154, Surveyed April/May 2007 - DCSO records Vol. 57 Page(s) 22568

The 1/4 sec. cor. of secs. 10 and 11, monumented with an iron post, 2 1/2" dia., firmly set, projecting 5" above the ground, with brass cap (properly) mkd.

from which the remaining bearing tree mkd. by Beck in 1964-65

A fir, 22" dia., bears N.52 1/4° E., 23.1 ft., with a healed blaze. (Record, N.67° E.)

and a bearing tree mkd. by Tracy, in 1967

A fir, 24" dia., bears S.19 1/4° W., 93.3 ft., with a healed double blaze.

Corner is located 12.0 ft. East of a woven wire fence, with fences extending N. and S.

New BTs

20" D. FIR "1/4 S11CS" "BT" S 23° E, 20'

17" D. FIR "1/4 S10" "CSBT" N 07 1/2° W, 73'