

GOVERNMENT CORNER RESTORATION FORM
DOUGLAS COUNTY SURVEYOR

TOWNSHIP 29 RANGE 9 SECTION 1 PLSS/GCDB No.700700

CORNER DESIGNATION: NE Corner of Section 1 (NE Township Corner)

CORNER HISTORY, PREVIOUS RENEWALS OR SURVEYS:

- SEE DCSO SURVEY & CORNER RECORDS FOR PLSS 700700

MONUMENT (CONDITION AND SOURCE):


- Found a 2 1/2" o.d. iron pipe, firmly set, projecting 6" above the ground with a 3 1/4" diam. brass cap marked as noted:

FILED
Date: 11-17-2021
By: SC
Corner Form: CS67/50-6
Field Notes: 6 pgs
DOUGLAS COUNTY SURVEYOR

DATE: November, 15, 2018

Condition Report Only
 Not Found
 Renewed
 Unrecorded
 Surveyed In
 Referenced Out

MONUMENT DETAIL

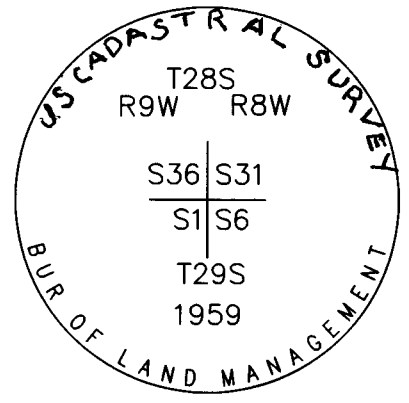

ACCESSORIES (CONDITION, SOURCE & RECORD):

Bearing Trees by Byron for DCSO in 1957:

- A very rotted 14" x 1.5' tall cedar stump bears N. 1° E., 86.9 feet. (No blaze evidence)
- A 34" diam. d. fir bears N. 74 1/2° E., 21 feet with a fully healed blaze.
- A 40" diam. d. fir bears S. 6 1/2° W., 22.8 feet with a fully healed blaze.

Bearing Trees by Jelley for BLM in 1964:

- A 24" x 3' tall sawn grand fir stump bears N. 73° W., 163.7 ft. (tipped out - Measurement was to center root hole)

New Bearing Trees:

- A 6" diam. grand fir bears S. 81° W., 17.4 feet scribed "X", "BT" on a double blaze.
- A 3" diam. maple bears N. 7 1/2° W., 13.15 feet scribed "X", "BT" on a double blaze.

LOCATION & COMMENTS:

The corner falls on flat ground in mixed fir and maple forest. The monument lies 1.5 ft. North of a fence corner with fences running South and East.

All bearing trees have BT Tags attached. All new bearing trees have double blazed faces with bearing measured to the center of the tress at the root crown and distances measured to a 4" mag nail in the side and center of the root crown.

GEODETIC COORDINATES
 LATITUDE: + 430500.437765080
 LONGITUDE: - 1234207.696406340
 DATUM: NAD 83
 SOURCE: GeoXT6000
 OREGON SOUTH-ZONE3602:
 FILE PATH: I:\SurData\GPS\LAT&LONG

COMPASS DECLINATION: 15° E.
 AGENCY:DCSO
 PARTY CHIEF: S. J. Flause
 WITNESSES: J. Lorsung
 NOTES: ATTACHED

CS 67/50-6

T29S R09W S01

PLSS: 700700

DATE: Nov. 15, 2018

CREW:

PARTY CHIEF: S. J. FLAUSE

TECH: JEFF LORSUNG

MONUMENT: 3/4" L.P. NOTED IN 1957 NOT SEEN.

FROM THE 1959 BLM RESURVEY, A 3 1/4" DIA BRASS COP
ON A 2" I.D.P. "U.S. CADASTRAL SURVEY"

MARKED AS
AT RIGHT

T28S
R9W R8W
S36, S31

PROV. 6" PLUMB

S1 S6
T29S
1959

BUREAU OF LAND MANAGEMENT

FOUND: NO EVIDENCE OF O.B.T.'S

FROM 1957 DCSSO RENEWAL (ALLEGED COOS HEAD TIMBER
CO. B.T.'S) A VERY ROTTED 14" BY 1 1/2 FT. TALL CEDAR STUMP
WITH NO BLAZE OR SCRIB. EVIDENCE; BEARS N01°E, 86 1/2 FT. DIST.
A 34" D. FIR WITH A FULLY HEALED SINGLE BLZ.; BEARS N74 1/2°E,
21 1/2 FT. DIST. A 40" D. FIR WITH A FULLY HEALED SINGLE BLZ.,
BEARS S6 1/2°W, 22 1/2 FT. DISTANT. (FOUND CONT'D OVER)

NEW:

A 6" GRAND FIR SCRIBED "X" "BT" ON A HIGH-
LOW BLAZE; BEARS S81°W, 17 1/4 FT. DIST.

A 3" MAPLE SCRIBED "X" "BT" ON A HIGH-
LOW BLAZE; BEARS N7 1/2°W, 13 1/5 FT. DIST.

B.C. MON IS 15 NORTH FROM FENCE CORNER WITH
FENCES RUNNING SOUTH AND EAST.

MONUMENT IS ON FLAT GROUND IN A MIXED FIR
AND MAPLE WOODS,

CS 67/50-6

211

FOUND: CONTO


BLM 1959 NEW B.T.'S: NO EVIDENCE FOUND.

BLM 1964 NEW B.T.: A 24" DIA. 3 FT. TALL
SAWN GRAND FIR STUMP (NOW TIPPED OVER)
THE DISTINCT ROOT HOLE OF WHICH BEARS N73°W,
163 ± FT. DISTANT.

CS 67/50-6
3/6

SKETCH

(SHOWS LIVE B.T.'S ONLY)

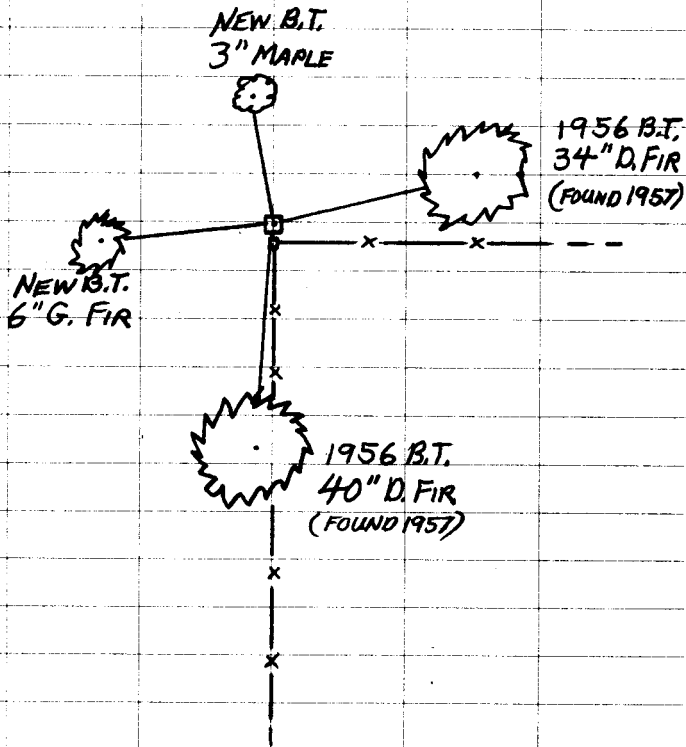

DECLINATION: 15° E

CS 67/50-6
416

11/15/18

TOWNSHIP 29 RANGE 09 POINT IDENTIFIER # 700700

PRIMARY CORNER DESCRIPTION NE Cor Sec 1 (NE Tsp Cor)

Alias _____	Description _____
Alias _____	Description _____
Alias _____	Description _____
Alias _____	Description _____

ON THE COUNTY LINE - CHECK WITH COOS COUNTY FOR POSSIBLY MORE INFORMATION

GLO survey by Dennis Hathorn, Deputy Surveyor under Contract #57, dated April 12, 1855 - (DCSO records Vol. 14 Page(s) 5788)

Set post cor. Tps. 28 and 29 and South R's 8 and 9 West, from which

- A Fir 12" dia., bears N.74°E., 27 lks. dist.
- A Fir 15" dia., bears S.60°E., 21 lks. dist.
- No Evid.* A Fir 15" dia., bears N.86½°W., 36 lks. dist.
- An Alder 15" dia., bears S.30°W., 69 lks. dist.

Douglas Co. Surveyors Office - James Byron, Deputy - Milo Godfrey; crew - Sept. 10, 1957 - C.S. File 49/12

Found - 3/4" Iron pipe at corner.
Orig. BT, 15" now 24" rotted stump, N.86½°W., 23.8 ft. Good scribing on chip of old face.

This corner renewed by Coos Head Timber Co., Aug. 1956 per notes on yellow tag. Original BT checks bearing and distance to 3/4" I.P.

I find these BTs scribed in 1956:

56 1/2 W BLM *N 74 1/2 E TO C.R.C. NOW*

40" 7" R. Fir S. 8° W. 22V8 ft. scribed BT S1 T29S R9W FHSB ✓

34" 6" R. Fir N.76½°E., 21V0 ft. scribed BT S31 T28S R8W. FHSB ✓

VERY ROTTED STUMP 24" Cedar N. 3° E., 86.9 ft. scribed BT S31 T28S R8W.

14" X 1 1/2" TALL *N 1° E CLOSE TO BLM BEAR.* *NO EVID.*

BLM resurvey by William W. Glenn, Cadastral Surveyor, under Group's #350 and 420, Surveyed April/June 1959 - (DCSO records Vol. 30 Page(s) 12846-47)

At the Tps. Corner, recorded by Byron in 1957, previously perpetuated with an iron pipe, 3/4" dia., firmly set, 14" above ground, from which the remaining original bearing trees:

- A sawed and rotted Fir stump 24" dia., bears N.86½°W., 36 lks. dist., with scribe marks S 8 W visible on chop of old face.
- and locally established bearing trees:
- A Cedar 24" dia., bears N.1 3/4°E., 131½ lks. dist. mkd. BT S31 R8W T28S.
- A Fir 6" dia., bears N.76°E., 32 lks. dist. mkd. BT S31 R8W.
- A Fir 7" dia., bears S.6½°W., 34½ lks. dist. mkd. BT S1 T29S R9W.

(Cont. Next Page)

CS 67/50-6
576

TOWNSHIP 29 RANGE 09 POINT IDENTIFIER # 700700

PRIMARY CORNER DESCRIPTION NE Cor. Sec. 1 (NE Tsp. Cor.)

Alias _____	Description _____
Alias _____	Description _____
Alias _____	Description _____
Alias _____	Description _____

At the corner point
 Set an iron post, 28" long, 2 1/2" dia., 26" in the ground, with
 brass cap mkd: T 28 S ← U.S. CADASTRAL SURVEY
 R 9 W R 8 W
 S 36 S 31
 S 1 S 6
 T 29 S
 1959
 COR IS 15 FT NORTH
 FROM FENCES RUNNING SOUTH AND EAST

PROJ. 6" BC
 3 1/4" x 2" IP
 BUREAU OF LAND MANAGEMENT

from which
 NO EVID. A Fir 7" dia., bears S. 43 1/2° E., 56 lks. dist., mkd. T29S
 R8W S6 BT.
 NO EVID. A Maple 5" dia., bears N. 52 1/2° W., 65 lks. dist. mkd. T28S
 R9W S36 BT.
 Deposit iron pipe alongside iron post.

BLM resurvey by John Jelley, Cadastral Surveyor, Group # 552, surveyed July 1964 - (DCSO records Vol. 32 Page(s) 13569-70)

The Tps. corner, monumented with an iron post, 2 1/2" dia., 2" above ground, firmly set, with brass cap mkd. in 1959, from which local bearing trees:

- A sawed Cedar stump 24" dia., bears N. 1 3/4° E., 131 1/2 lks. dist., no marks remain.
- A Fir 7" dia., bears N. 76° E., 32 lks. dist. with frag-^{21 1/2}mentary scribe marks visible on partially healed blaze.
- A Fir 8" dia., bears S. 6 1/2° W., 34 1/2 lks. dist., with frag-^{22 1/2}mentary scribe marks visible on partially healed blaze.
- and a bearing tree mkd. by Glenn, in 1959 ^{36%}
- A Fir 8" dia., bears S. 43 1/2° E., 56 lks. dist., with frag-mentary scribe marks visible on partially healed blaze.

from which a new bearing tree:
 A White Fir 12" dia., bears N. 73° W., 24 lks. dist. mkd. T28S R9W S36 BT.
 SAWN 24" x 3" FT TALL
 G. FIR STAMP. TIPPED OVER FHSB
 ROOT HOLE 163 68
 GOOD

NEW BT'S
 6" GRAND FIR "X" "BT" ON HIGH-LOW BLZ. S 81° W, 17 40
 3" MAPLE "X" "BT" " " " N 7 1/2° W 13 15 FT
 CORNER IS ON FLAT GROUND MIXED FIR & MAPLE WOODS

CS 67/50-6 2
616