

T30 R 2 S 28/35

PLSS: 340200
DATE: 1-8-19

Filed 11/17/2021

CREW:

PARTY CHIEF: S. J. FLAUSE
TECH: JEFF LORSUNG

MONUMENT:
AS PER REC.

PROJ: FLUSH

FOUND:

- SHANER 1967 24" MADRONE STUMP
NOW 10" MADRONE GROWING FROM
STUMP.
- 16" NOW 35" CEDAR AS PER RECORD
- REMNANTS OF HATHORN 1957 NE
FIR ORIGINAL BT

NEW:


5/8" IR PROJECTING 5" S 45° E, 10°
 " " " " " N 45° W, 10°

CS 67150-13

1/6

LIES ON STEEP SOUTHERLY
SLOPE IN MADRONE + THICK
BRUSH, APPROX 120 FT N
OF SKID ROAD.

CS 67/50-13
214

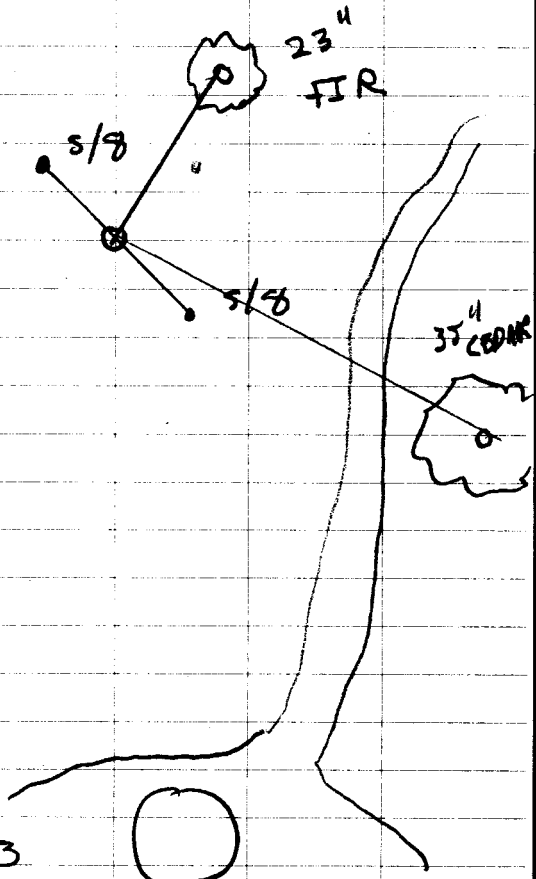

CS 67/50-13
3/6

water
TANK

TOWNSHIP 30 RANGE 02 POINT IDENTIFIER # 340200

PRIMARY CORNER DESCRIPTION 1/4 Cor for Secs. 28 and 33

Alias _____ Description _____
Alias _____ Description _____
Alias _____ Description _____
Alias _____ Description _____

Found - 2½" Iron pipe with nipple. No cap.
Stone marked "¼", 6" South of pipe.
24" Fir stump, burned face, S.76°32'W., 101.0 ft.
18" Fir stump, burned "S33 BT" visible, S.79°6'W.,
108.5 ft.
24" Madrone, faint bark scribing visible,
N.45°40'E., 156.6 ft.
24" Cedar "T30S R2W S33 ¼ BT" visible, S.57°08'E.,
153.9 ft.
Set 2" x 30" galv. Iron pipe with 2½" brass cap. Buried 2½"
I.P. and stone with 2" x 30" Iron pipe in mound of stone.

Douglas Co. Surveyors Office - Gregory Quiebell, Deputy -
Terrie Plouff, Teresa Buley, crew - Sept. 30, 1981 - C.S.
File 61/27

Found Brass cap on I.P., lying on ground near its correct
location. I establish temp. position based on the following:
24" Fir stump with burned face, bears S.76°W., 101.0 ft.
18" Fir stump, burned, with S33 BT visible, bears S.79°W.,
108.5 ft.
24" Madrone bears N.45°E., 157.3 ft. (Rec. 156.6 ft.) with
scribed "T30S R" visible in bark.
24" now 25" Cedar, bears S.57°E., 153.9 ft. with "T30S R2W
S33 ¼ S BT" visible in unhealed blaze.
I reference my temporary position the RESET found brass cap
at that location. Cap now is in a steep fire trail
protruding 4" out of ground. I ADD marks "RESET 1981".

Douglas Co. Surveyors Office - Randall Smith and Stephen
Flause, crew - Sept. 26, 1987 - C.S. File 62/45

Found - 2½" dia. brass cap mkd. "T30S R2W ¼ S28 S33 PLS 866
1979, Reset 1981", on a 2¼" outside dia. iron
pipe 30" long. Monument is set in a fire trail
and was apparently disturbed by a tractor;
monument leans approx. 14" SW. from its plumb
position, flush with the ground.

Original Post not found.
Stone first noted in 1933 not found.
3" Pipe per 1947 visit, not found.

Bearings and distances taken to plumb position of brass cap.
48" Fir now a stump hole with remnants near original
record bearing and distance (Orig. record
N.36°E., 29.7 ft.) Orig. BT.
Orig. SW. BT gone.

*1 FT TALL
ROOT REMNANT*

(Cont. Next Page)

TOWNSHIP 30 RANGE 02 POINT IDENTIFIER # 340200

PRIMARY CORNER DESCRIPTION 1/4 Cor. for Secs. 28 and 33

Alias _____	Description _____
Alias _____	Description _____
Alias _____	Description _____
Alias _____	Description _____

24" now a 2 ft. high broken and burnt D.Fir stump, no blaze or scribing found, bears S.76°W., 101.0 ft. (Rec. S.77 3/4°W., 99.5 ft. per 1933; S.78°W., 99.5 ft. per 1967; S.76 1/2°W., 101.0 ft. per 1979; and S.76°W., 101.0 ft. per 1981) 1933 BT.

NW. bearing tree per 1933 gone.

A 24" now a 14" dia., 20" high broken and burnt D.Fir stump with blaze and scribing visible "S33 BT" bears S.79°W., 108.5 ft. (Rec. S.80°W., 108.0 ft. per 1967; S.79 1/4°W., 108.5 ft. per 1979; and S.79°W., 108.5 ft. per 1981)

- 16" now 28" dia. I.Cedar with a fully healed single blaze, bears S.57°W., 153.9 ft. (Rec. S.56 1/2°E., 153.0 ft. per 1967; S.57°E., 153.9 ft. per 1979 and S.57°E., 153.9 ft. per 1981) 1968 BT.

24" now 24" dia. 4 ft. high Madrone stump with illegible bark scribing, bears N.45°E., 156.6 ft. (Rec. N.47 1/2°E., 157.7 ft. per 1967; N.45 3/4°E., 156.6 ft. per 1979 and N.45°E., 157.3 ft. per 1981) 1968 BT.

Brass cap with iron pipe from 1979 was returned to plumb position, now protrudes 6" above ground.

New BT - A 9" D.Fir double blazed and scribed "1/4 S28 CS BT"

23" bears N.45°E., ~~22.6~~ 31.9 ft. FHDB
Corner lies in fire trail on steep southerly slope.

USFS PNT#1 S89°42'E, 40000

PNT#1 - E 1/16 ²⁸/₃₃ S89°42'E, 91834

NEW B.D.:

5/8" IR, PROJ. 5" ABV. GRND S45°E, 100'

" " " N45°W, 100'

CS 62150-13

TOWNSHIP 30 RANGE 02 POINT IDENTIFIER # 340200

PRIMARY CORNER DESCRIPTION 1/4 Cor. for Secs. 28 and 33

Alias _____ Description _____
Alias _____ Description _____
Alias _____ Description _____
Alias _____ Description _____

GLO survey by Dennis Hathorn, Deputy Surveyor under Contract #73, dated June 8, 1857 - (DCSO records Vol. 16 Page(s) 6767)

Set 1/4 sec. post, from which
A Fir 26" dia., bears S.88°W., 52 lks.
A Fir 48" dia., bears N.36°E., 45 lks.

Ben B. Irving, Deputy Co. Surveyor - Wit: N.E. Richardson;
J.D. Loffer; Parker - Jan. 18, 1933 - C.S. File 37/85

Corner location identified by a stone 6"x8"x14" and two BTs. BTs down and burned out, no numbers or scribed marks visible. Mr. Parker claims to have seen numbers on one of the trees before fire of last year.

Marked X on top an 1/4 on South face., from which
A 16" Pine N.65°30'E., 78.8 ft., blazed and scribed T30S R2W 1/4 S28 CS BT.
A 24" Fir S.77°45'W., 99.5 ft. blazed and scribed T30S R2W 1/4 S33 CS BT.

Charles S. Collins - Aug. 1947 - C.S. File 40/28

Corner and accessories are as renewed:
A 16" Pine bears N.65°30'E., 78.8 ft., scribes legible.
A 24" Fir bears S.77°45'W., 99.5 ft., bark scribe legible
Corner stone easily displacable, Set 3" Pipe, 6" North.

Survey by Bruce Shaner - For: Umpqua National Forest - Oct. 1967 - C.S. File 55/51 and RM 1-62

Found - 3" Iron pipe, 6" N. of 10x10x6" rock with old and new "1/4" mark, from which rock a:
24" D.Fir stump, badly burnt but in right location for Collin's BT, bears S.78°W., 99.5 ft.
16" Pine snag, possible BT, with an old face badly burnt, but no scribes visible now, bears N.37 1/2°E., 117.5 ft. (Rec. N.65 1/2°E., 78.8 ft.)
Scribed- 24" D.Fir stump BT, "1/4S S33 BT", bears S.80°W., 108.0 ft.
16" Cedar BT, "T30S R2W S33 BT", bears S.56 1/2°E., 153.0 ft.
24" Madrone BT, "T30S R2W S28 BT" bears N.47 1/2°E., 157.7 ft.

Survey by William Ruppert, LS #866 - For: U.S. Forest Service April 1979 - M 70-61

(Cont. Next Page)

CS 67/50-13

1

614