

T30 R 2 S 33

PLSS: 34060
DATE: 1-15-19

Filed 11/17/2024

CREW:

PARTY CHIEF: S. J. FLAUSE

TECH: JEFF LORSUNG

MONUMENT:

2 1/2" BC SET IN CONCRETE 4.4 FT

BELOW SURFACE, SET 2 1/2" BC AN
IP ABOVE SURFACE IN STONE COLLAR

PROJ: 1"

FOUND:

- 43" x 2 1/2 FT. TALL SAWN D. FIR STUMP, N 24° E, 118 1/4

- 36" D FIR, N 59 1/2° W, 84 1/2 FT

NEW:

- 12" x 4" TALL CONCRETE CYLINDER 3 1/4
B.C. →

BEARS, N 72° 19' 30" E, 127 5/8

- 6" x 2" TALL " 2 1/2
B.C. →

BEARS, N 18° 45' 58" W, 102 3/4

(BASIS OF BEARINGS)

CS 67150-14

3 1/2 -

U.S. COAST & GEODETIC SURVEY

3

5500
+
1949



BENCH MARK

2 1/2 - U.S.O.A. A.S. BOUNDARY

4

1967
ORE. 4906

CS 67150-14

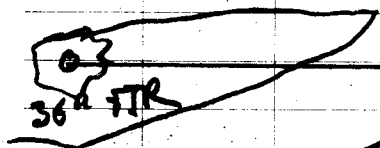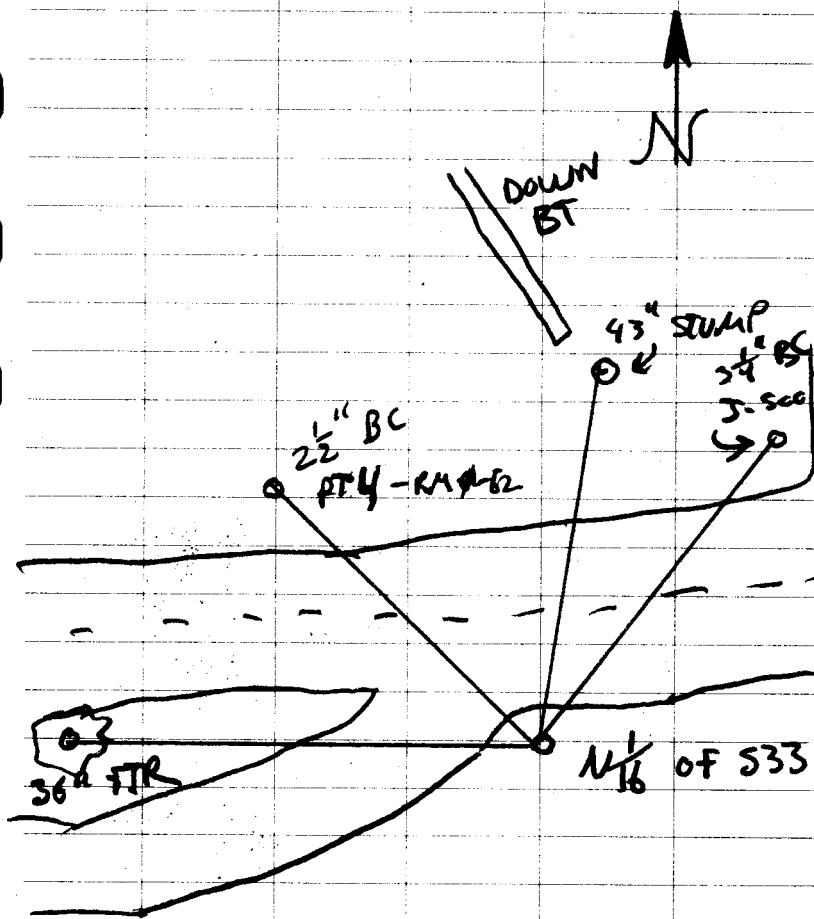

S. UMPQUA RIVER

DEC. 14/40 E

CS 67/50-14

TOWNSHIP 30 RANGE 02 POINT IDENTIFIER # 340160

PRIMARY CORNER DESCRIPTION Center N. 1/16, Sec. 33

Alias _____	Description _____
Alias _____	Description _____
Alias _____	Description _____
Alias _____	Description _____

Survey by Bruce A. Shaner - For: Umpqua National Forest -
Oct. 1967 - C.S. File 55/51 and RM 1-62

Set monument from which a

~~36"~~ 26" D.Fir, I scribed "CN 1/16 S33 BT", bears N. 61 1/2° W., 59 1/2°

~~83.8~~ ft. 84 1/2 TO NAIL

43" x 2 1/2" 32" D.Fir, I scribed "CN 1/16 S33 BT", bears N. 22° E., 24°

SAWN STAMP 118.0 ft.
118 1/4

Fd. OK, April 8, 1982 - L. Herzstein - C.S. File 61/32-10

Fd. OK, June 1986 by M Armstrong - M 101-9

C
N 1/16 | S33
C

CS 67/50-14