

PLSS: 100700

T24S R07W SEC 6

DATE: 3-19-19

CC
S1|S6

Filed 11/18/2021

CREW:

PARTY CHIEF - S. J. FLAUSE

TECH - J. A. LORSUNG

MONUMENT:

FROM THE 1979 ROBERTS SURVEY A 3 1/4"

DIA. BRASS CAP " PLS 1039 "

(MARKED AS AT RIGHT) T23S R0W
S36

ON A 2" I.D. IRON PIPE S1|S6

PROJ.:

R0W R7W 8' ABOVE
1979 GROUND

FOUND:

POSSIBLE EVIDENCE OF TWO 1893

O.B.T.S. A VERY ROTTEN FIR STAMP

WITH NO REMAINING BLAZE EVIDENCE; BEARS

S59°E, 53 ± FT. DIST (AS PER COMPUTED

2005 BLM REC.)

AN APPROX. 50" DIA. SAWN AND ROTTEN D.

FIR STUMP WITH NO MARKS VISIBLE;

CS 67150-18

OVER →

DIETZEN NO. 385-5

(2)

FOUND CONTD:

BEARS $S09\frac{1}{2}^{\circ}W$, 75⁰ FT. DIST. (AS PER
COMPUTED 2005 BLM REC.)

FROM THE 1960 DCSD RENEWAL
A BRASS CAP MONUMENT MARKING THE
1893 CORNER POSITION. A 2¹/₂" DIA.

BRASS CAP (MARKED "COUNTY SURVEYORS OFFICE"
AS AT RIGHT) ON A

AM $\frac{CC\ T235}{51\ 56\ T245}$

1" I.D. IRON PIPE;
BEARS $N0^{\circ}18'10"E$, 2¹/₂ FT. DIST.
(AS PER 2005 BLM REC.)

ABW ATW
1960

TWO 1966 BEARING

PROJ: 13 INCHES
ABOVE GROUND

TREES THAT FORMERLY

REFERENCED THE FOUND 1960 BRASS CAP MON.

A 28" DIA. GRAND FIR WITH A FHSB;

BEARS $N85\frac{3}{4}^{\circ}E$, 33⁰ FT. DIST.

AN 18" DIA. D. FIR WITH A FHSB; BEARS

$S54^{\circ}W$, 72⁵ FT. DIST.

TWO 1979 ROBERTS BEARING

TREES: A 14" DIA. D. FIR WITH A FHSB;

CS 67/50-18

NEXT PG.
→

(3)

T24S R07W SEC 6 PLSS 100700 CONT'D

BEARS S57°E 11³ FT DIST (AS PER 2005

BLM REC.)

A 21" DIA. D. FIR WITH A FHSB; BEARS

S61¹/₂°W, 64⁶ FT. DIST (REC DIST 64¹/₂ FT.)

NEW REFS:

1960 B.C. MONUMENT

AN ITS 1966 B.T.'S ARE NOW TIED

DIRECTLY TO THE 1979 B.C. MONU-

MENTED COR. POSITION ACCEPTED

BY BLM IN 2005.


DIETZEN NO. 385-5

CS 67/50-18

SKETCH


T24S R07W S6 PLSS 100700

(SKETCH ONLY SHOWS LIVE TREES)

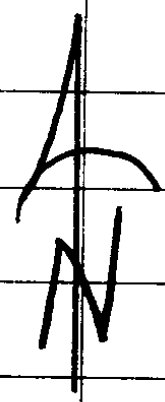

NO SCALE

DIETZGEN NO. 385-5

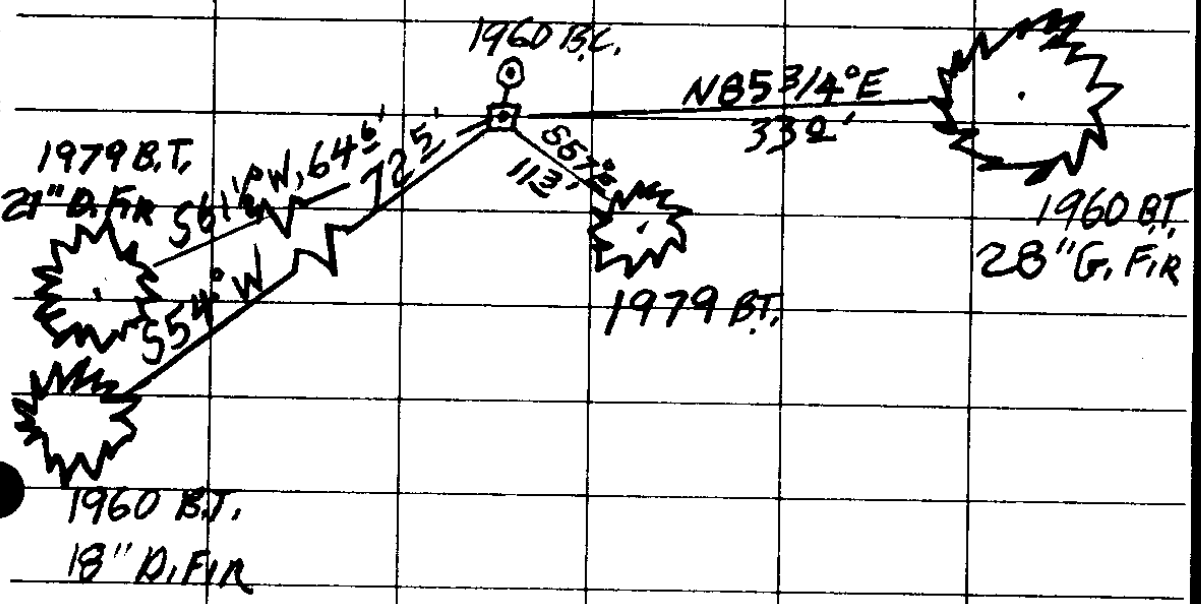

BLM SURVEY

IS BASIS OF BRG.'S

CS 67/50-18

TOWNSHIP 24 RANGE 08 POINT IDENTIFIER # 700700

3/19/19

PRIMARY CORNER DESCRIPTION NE Cor. Sec. 1 (NE Tsp. Cor)

GPS T2 45R7W PLS5

100700

Alias _____	Description _____
Alias _____	Description _____
Alias _____	Description _____
Alias _____	Description _____

GLO Survey by Henry L. Chandler, U.S. Deputy Surveyor, under Contract #619, dated June 5, 1893 - (DCSO records Vol. 8 Page(s) 3225)

At point of intersection, I set a post 4½ ft. long, 4" sq., 24" in the ground for closing cor. to T24S Rs. 7 and 8, marked CC T24S on S.; R7W S6 on E.; and R8W S1 on W. faces, with 6 notches on S., E., and W. faces, from which

A Fir 36" dia., bears S.57°E., 83 lks. dist. mkd. T24S R7W S1 BT.

SEE LAST PAGE

A Fir 48" dia., bears S.57°E., 120 lks. dist. mkd. T24S R8W S1 BT.

A Fir 36" dia., bears N.38°W., 85 lks. dist. mkd. T24S Rs. 7 & 8 BT.

5428 7920 FROM ROBERTS S 59°E 537

5640

Douglas Co. Surveyors Office - James Byron, Deputy - Milo Godfrey; Clete Putnam, crew - Sept. 1960 - C.S. File 49/41

Found - Orig. 36" now 48" Fir, N.38°W., 56.1 ft., old face destroyed by fire.

Orig. 36" now 42" Fir, S.57°E., 54.8 ft., old face destroyed by fire.

Orig. 48" now 65" Fir S.10°W., (Rec. S.57°E.) 79.2 ft., now stump shows rotted face.

S 9 1/2° W, 75' FROM 1979 BC.

Set Brass cap at cor. mkd: County Surveyors Office

	C	C	T23S
Am	S	1 S 6	T24S
	R8W	R7W	
	1960		

New BTs- 3" R.Fir bears S.13°W., 15.4 ft. scribed S1 CS BT. Rescribe, now 42" R.Fir S.57°E., 54.8 ft. CC S6 T24S R7W CS BT.

Douglas County Surveyors Office - Vernon "Ray" Tracy and crew Wit: B. Bright and T. Watts, BLM - April 18, 1966 - C.S. File 49/41

Found - DCSO brass cap, properly mkd. as recorded. All BTs down and dead or gone completely.

New BTs- 8" W.Fir, East 32.8 ft, mkd. CC T24S R7W S6 CS BT.

6" D.Fir S.53°W., 74.2 ft. mkd. CC S1 CS BT.

Corner lies 30 ft. South of old logging road.

Survey by Les Roberts - For: International Paper Co. - 1979 -M 80-47

Set 1½" I.Pipe and brass cap at true intersection, from which (Cont. Next Page)

3 1/4 ins BC on 2" ID IP

PLS 1039
T23S R8W ¹
536
51 56
R8W R7W
1979

CS 67/50-18

TOWNSHIP 24 RANGE 08 POINT IDENTIFIER # 700700

PRIMARY CORNER DESCRIPTION NE Cor. Sec. 1 (NE Tsp. Corner)

Alias _____ Description _____
Alias _____ Description _____
Alias _____ Description _____
Alias _____ Description _____

12" Fir bears S.62°W., 64.1 ft.
8" Fir bears S.55°E., 11.2 ft.
Corner lies 2.28 ft. South of corner set by the County.

Douglas Co. Surveyors Office - Larry E. Monrean, Deputy -
Randall Smith and Stephen Flause, crew - March 5, 1984 - C.S.
File 62/16-7

Found - I.P. with properly mkd. brass cap protruding 12".
I.P. with properly mkd. brass cap protruding 8".
8" now 17" W. Fir with well healed double blaze bears
East. 32.8 ft. (DCSO 1966)
6" now 11" D. Fir with well healed single blaze bears
S.53°W., 74.2 ft. (DCSO 1966)
12" Fir with partially healed double blaze with
visible scribing "T24", bears S.62°W., 64.1 ft.
(1979)
8" Fir with partially healed double blaze, with
visible scribing "BT", bears S.55°E., 11.2 ft.
(1979) *57°(AM)*
The letters "AM" were added to the DCSO closing corner cap.
(Sketch in C.S. File)

BLM Dependent resurvey by A. Bert Skeesick, Cadastral
Surveyor and Robert H. Browning, Survey Tech, under special
instructions and Group No. 2104, surveyed July 2005/Jan. 2006
(DCSO records Vol. 57 Page(s) 22401-2)

The true point for the closing cor. of secs. 1 and 6, at the
intersection with the township line, established by Roberts,
in 1979, and is accepted as the cor., monumented with an iron
post, 2" dia., firmly set, projecting 9 ins. above ground,
with brass cap (properly) mkd. .
from which bearing trees mkd. by Roberts
14AD fir, 14" dia., bears S.57°E., 11.3 ft., with a healed
21" double blaze.
A fir, 23" dia., bears S.61½°W., *64.6* ft., with a healed
D double blaze.
From this point, the orig. closing cor. of secs. 1 and 6,
T24S Rs 7 & 8W., established by Chandler in 1893,
remonumented by the Douglas County Surveyors Office in 1960,
and perpetuated by the Douglas County Surveyors Office in
1966 and 1984, bears N.0°08'01"E., 2.17 ft., monumented with
an iron post, 1½" dia., firmly set, projecting 14" above
ground, with brass cap (properly) mkd.
from which the remains of the orig. bearing trees
✓ A decayed fir stump, size indeterminate, bears S.57°E.,
✓ 4.8 ft., with no marks visible continued next page
S 59°E, 53Z

CS 67/50-18

TOWNSHIP 24 RANGE 08 POINT IDENTIFIER # 700700

PRIMARY CORNER DESCRIPTION NE Cor. Sec. 1 (NE Tsp. Cor.)

Alias _____	Description _____
Alias _____	Description _____
Alias _____	Description _____
Alias _____	Description _____

59 1/2° W, 75° FROM 1979 B.C.

✓ A sawed fir stump, 50" dia., ^{3 FT TALL} bears S.9 1/4° W., 77.2 ft., with no marks visible. (Record, S.12° W., 79.2 ft.) and bearing trees mkd. by the Douglas County Surveyors Office in 1966

✓ A fir, 28" dia., bears N.88 3/4° E., 32.6 ft., with a healed blaze.

✓ A fir, 20" dia., bears S.52 1/4° W., 73.0 ft., with a healed blaze.

N85°E, 32' Z
S53 1/2° W, 71' Z

NEW B.T.S FOR ROBERTS CAP

28" G. FIR FHSB N85 3/4° E, 33'

18" D. FIR FHSB S54° W, 72'

CS 67/50-18