

T 25 R 8 S 14+15 DATE: 4-8-2019

CREW: S. J. FLAUSE  
J. LORSUNG

MONUMENT:

3/4" BC MARKED AS PER RECORD.

AREA HISTORICALLY BURNED OR SHOVEL LOGGED. NO LARGE STUMPS IN THE AREA.

PROJ: 6"

FOUND:

- NO ORIGINAL 1881 EVIDENCE.

1964 BLM:

- 8' TALL X 16" D. FIR STUMP BEARS

4" MAG N 78 1/2° E, 16<sup>E</sup>. (REC SE WRONG)

- 6' x 21" D. FIR STUMP BEARS

N 54 1/4° W, 5<sup>E</sup> (REC. 56<sup>E</sup> WAS CHAIN)

NEW:

- 1 FT TALL X 20" D. FIR STUMP BEARS

S 41° E, 6' FT.

- 6 inch TALL X 14" D. FIR STUMP BEARS

S 32° W, 15°.

TOP CENTER 4" MAG NAIL



CS 67/50-23

J.L. DARLING CORP. TACOMA, WA 98424-1017  
www.RiteintheRain.com

Rite in the Rain  
ALL-WEATHER WRITING PAPER

# SKETCH

T25SR08W/S14 PLSS500440

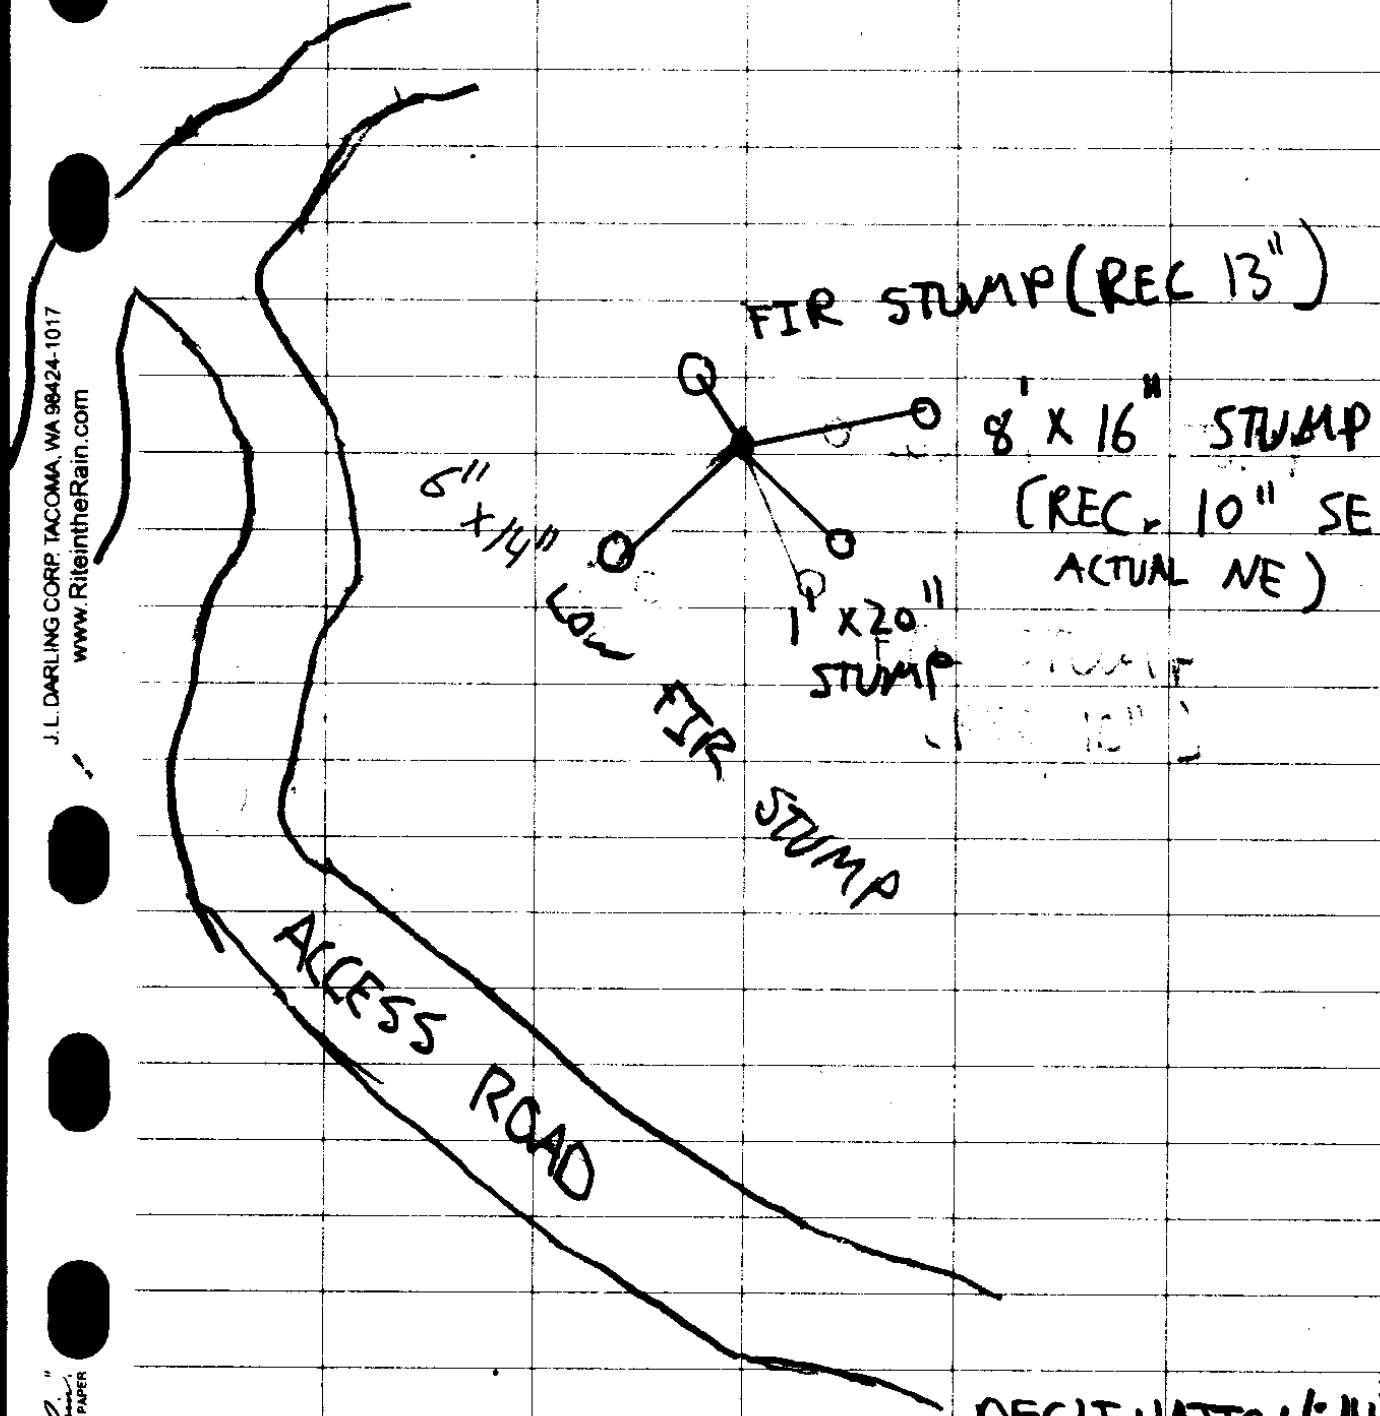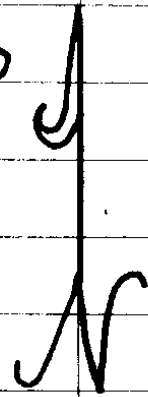

FIR STUMP (REC 13")

8' x 16" STUMP  
(REC. 10" SE  
ACTUAL NE)

6" x 14" LOW FIR STUMP  
1' x 20" STUMP

STUMP  
(REC. 10")

ACCESS ROAD

DECLINATION: 14<sup>3</sup>/<sub>4</sub>

CS 67/50-23