

Filed 11/18/2021

PLSS: 300500

T30SR1WSB

DATE: APRIL 17, 2019

58 | 59

517 | 516

CREW:

PARTY CHIEF - S. J. FLAUSE

TECH - J. A. LORSONG

MONUMENT:

FROM THE 1968 ALSO RENEWAL A
2 1/2" DIA. BRASS CAP ON A 1" I.D. IRON PIPE
BRASS CAP MARKED

AS AT RIGHT. "COUNTY SURVEYORS OFFICE"

T30S R1W

PROJ: 8" ABOVE A

58 | 59

ROUGH 2 FT. DIAMETER

517 | 516

MOUND OF STONE

1968

FOUND:

EVIDENCE OF ONE DBT FROM 1857
A TREE (PINE OR FIR) ROTTED TO GROUND;
BEARS S82°W, 9 ± FT. DIST. (AS PER MENSCH
1904)

EVIDENCE OF TWO 1904 MENSCH B.T.'s
REMAINS OF ROTTED TO GROUND OAK; BEARS
S60°E, 44 ± FT. DIST (AS PER REC.)

A 30" DIA. 1 FT. TALL ROTTEN PINE STUMP
WITH BLAZE SCARS NO LONGER VIS; BEARS
N54°W, 102 ± FT. DIST. (AS PER REC.)

CS 67150-26

FOUND CONTD
OVER →

FOUND CONT'D:

FOUR B.T.'S ESTB IN 1968

DCSO RENEWAL.

A 15" DIA. D. FIR WITH A FHD13; BEARS N35°E, 19¹/₂ FT. DIST. (AS PER REC.)

A 14" DIA. D. FIR WITH A FHD13; BEARS S38°E, 12²/₂ FT. DIST (REC. S38°E, 13⁴/₂ FT.)

A 19" DIA., 14 FT. TALL DEAD D. FIR SNAG WITH A FHD13; BEARS S11°W, 29²/₂ FT. DIST. (REC. S14°W, 29²/₂ FT.). DISTANCE MEASURED TO 4" MAGNAIL SET IN LEFT SIDE-CNTR NEAR BASE OF BT.

A 20" DIA. D. FIR WITH A FHD13; BEARS N40¹/₂°W, 29²/₂ FT. DIST (AS PER RECORD).

NEW REFS:

TWO POSSIBLE U.S.F.S. B.T.'S (NO RECORD) THESE TREES HAVE SHIELD SHAPED U.S.F.S. LOCATION TAGS AND SHOW SOME BARK SCARRING (FROM SCRIBG?)

AN 8" DIA. MADRONE BEARS N23°E, 2⁵/₂ FT. DISTANT.

A 14" DIA. MADRONE BEARS N88°E, 4⁰/₂ FT. DISTANT.

MONUMENT IS 95 FT. SOUTH FROM FOREST RD. AREAS SE QUAM. IS OLD REPROD P. PINE REST OF FOREST IS OLD SECOND GROWTH.

CS67150-24


ALL INFORMATION CONTAINED HEREIN IS UNCLASSIFIED

J.L. DARLING CORP. TACOMA, WA 98424-1017
www.RiteInTheRain.com

T305KIWP LSS 300500 CONT'D

SKETCH:

SHOWS LIVE TREES AND ONE INTACT SNAG.

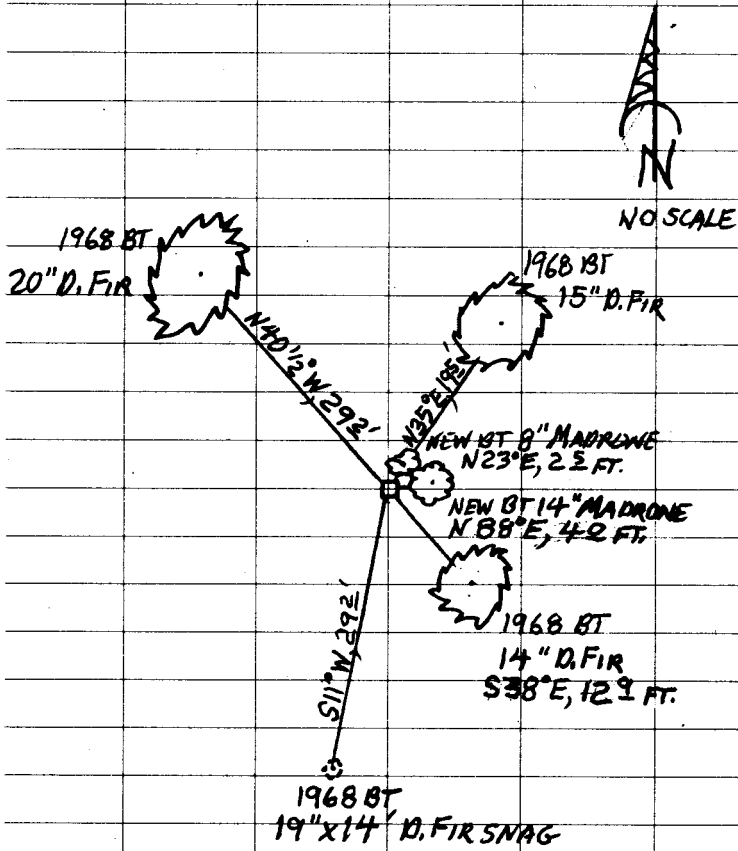

CS 67150-26

4/17/19

TOWNSHIP 30 RANGE 01 POINT IDENTIFIER # 300500

PRIMARY CORNER DESCRIPTION Cor. Secs. 8, 9, 16 & 17

Alias _____ Description _____
 Alias _____ Description _____
 Alias _____ Description _____
 Alias _____ Description _____

GLO survey by Dennis Hathorn, US Deputy Surveyor, contract 73 dated June 8, 1857 - (DCSO Records Vol. 16 Pg 6663)

Set post corner secs. 8, 9, 16, & 17 from which
 SEE BELOW A pine, 18" dia., bears S.85°W., 14 lks. 924
 A pine, 12" dia., bears S.60°E., 8 lks. 528
 GONE ← An oak, 24" dia., bears N.25°W., 60 lks. 3960
 An oak, 10" dia., bears N.45°E., 134 lks. 8844

GLO corrective survey by Fred Mensch, Dep. Surveyor, Contract #757 dated Sept. 14, 1904 - (DCSO records Vol. 16 Pgs 6692-3)

The old corner which was a post has disappeared, and three of the BTs are dead thought still standing. I obliterate the old marks & re-establish the corner in its orig. position as follows:

Set a basalt stone 15x10x8", 10" in the ground for cor. of secs. 8, 9, 16, & 17 mkd with 4 notches on S & E edges, from which

NO OB.T. A B.Oak, 12" dia., bears N.45°E., 131 lks., mkd: T30S R1W 86 46
 EVID S9 BT.
 SEE BELOW A B.Oak, 10" dia., bears S.60°E., 68 lks., mkd: T30S R1W 44 88
 S16 BT.
 SEE BELOW OB.T. A Y.Pine, 24" dia., bears S.82°W., 14 lks., mkd: T30S R1W 924
 S17 BT.
 SEE BELOW A Y.Pine, 24" dia., bears N.54°W., 155 lks., mkd: T30S R1W 102 30
 S8 BT.

Douglas Co. Surveyors Office - John M. Powell - Frank Jones & W. Penley - June 1968 - C.S. File 54/59

Found - Broken Stone at Corner with 4 grooves. — NOT LOOKED FOR

STUMP ROTTEN 24" Pine, now snag, S.82°W. 92 ft., burnt face, TO GROUND faint "4" visible. TO ROOT

30" X 1 FT TALL 24", now 31" Pine, N.54°W. 102.3 ft., shows good scar.

REMAINS OF OAK ABOUT S.60°E. 44.9 ft.

Set - Brass Cap at Cor. mkd: County Surveyors T30 R1W
 Office S 8 | S 9
 (1968) S 17 | S 16

New BTs - 12" D.Fir N.40 1/2°W. 29.2 ft. mkd: T30S R1W S8 CS BT. PHOB

15" 9" D.Fir N.38°E. 19.5 ft. mkd: T30S R1W S9 CS BT. PHOB

14" 8" D.Fir S.38°E. 13.4 ft. mkd: T30S R1W S16 CS BT. PHOB

19" X 14" TALL 13" D.Fir S.11°W. 29.2 ft. mkd: T30S R1W S17 CS BT. PHOB

LEFT SIDE CENTER SPIKE

NEW BT'S USFS ORIGIN?

14" MADRONE POSSIBLE BARK BLAZING N88°E, 40 FT

8" " " "

N23°E, 25 FT

ORDER REPRO. PINE
 IN SE QUAD
 REST IS OLD AND GROWN

CS 6/15/80-24

129

95 FT SOUTH FROM FOREST RD.