

FILED 11/18/2021

PLSS: 600600

T30SR1WS1

DATE: APRIL 18, 2019

52 | S1

CREW:

S11 | S12

PARTY CHIEF - S.J. FLAUSE

TECH - J.A. LORSUNG

MONUMENT:

FROM THE 1968 SHRUM SURVEY A 2 1/2" DIA  
ALUMINUM CAP MARKED " U.S.P.C. PROP. COR. "  
ON A 1" I.D. IRON PIPE T30S RIW

PROJ:

12" ABOVE GROUND.

1967 2 | 1  
11 | 12

RE. 4287

FOUND:

EVIDENCE OF ONE OBT. A VERY  
DISTINCT AND LARGE ROOTHOLE NEAR  
REC. B & D FOR SE BEARING TREE.

THREE 1968 SHRUM B.T.'S:

AN 11" DIA. 1 1/2 FT. TALL ROTTEN FIR STUMP  
SHOWING EVID. OF HEALED BLAZE; BEARS  
N 44 1/2° E, 22 ± FT. DIST (PER REC.)

A 15" DIA. 11 FT. TALL D. FIR SNAG WITH A FULLY  
HEALED DOUBLE BLAZE; BEARS S 04° E, 23 ±  
FT. DISTANT (RECORD BEARING <sup>S 17° E</sup> IS TO BLAZE FACE)

A 12" DIA. CEDAR WITH A FHDB; BEARS

CS67150-27

FOUND CONTD  
OVER →

(2)

FOUND CONT'D

N02°W, 11<sup>8</sup> FT DIST. (AS PER RECORD)

NEW REF.'S:

A 12" DIA. D. FIR SCRIBED "T30SRIWS1"  
"CS BT" ON A DOUBLE BLAZE; BEARS  
N32<sup>3</sup>/<sub>4</sub>°E, 19<sup>8</sup> FT. DISTANT.

A 10" DIA. D. FIR SCRIBED "T30SRIWS12CS"  
"BT" ON A DOUBLE BLAZE; BEARS S51°E,  
28<sup>2</sup> FT. DIST.

A 4" DIA. MADRONE TRUNK IN A MULTI  
TRUNKED SHRUBBY TREE SCRIBED "X" "BT"  
ON A HIGH-LOW BLAZE; BEARS N68°W,  
10<sup>0</sup> FT. (B&D ARE TO CNTR OF BASE OF  
SCRIBED TRUNK).

MON. IS IN NW COR. OF LOGGED LAND.  
SE QUADRANT IS OLD FIR REPROD. OTHER  
QUADS ARE OLD GROWTH FOREST.

MON. IS APPROX 300 FT. EAST FROM  
FOREST ROAD.

CS 67/90-27

ALUMINUM RAIN GAGE

J.L. DARLING CORP TACOMA WA 98424-1017  
www.RiteInTheRain.com


NO. 312

(3)

T305 RIW PLSS 600600

SKETCH:

SHOWS LIVE BT'S ONLY

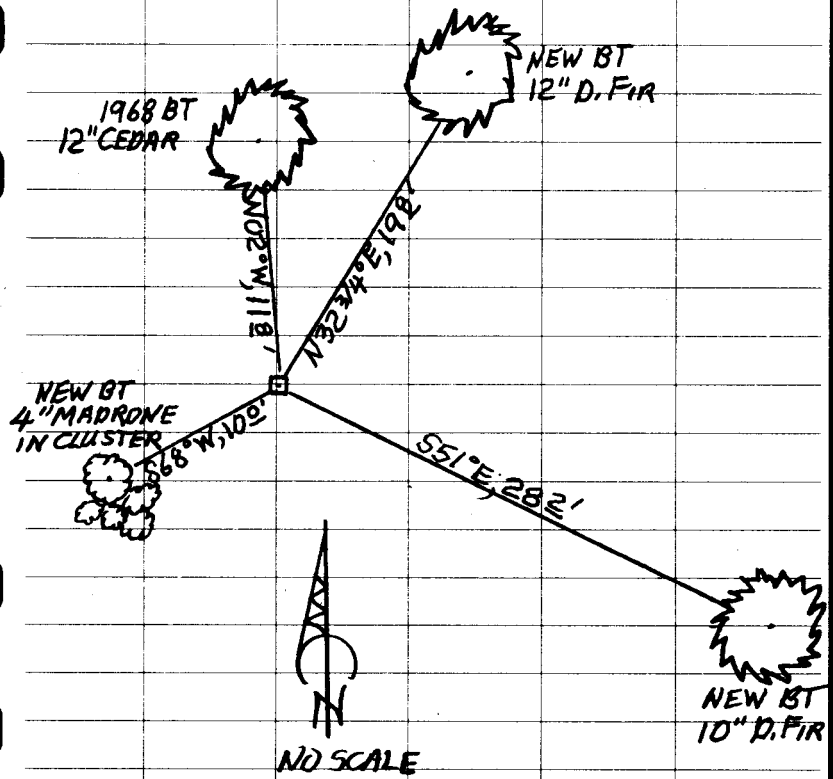

CS 67 / 50-27

April 18, 2019

TOWNSHIP 30 RANGE 01 POINT IDENTIFIER # 600600

PRIMARY CORNER DESCRIPTION Cor. Secs. 1, 2, 11, & 12

Alias _____	Description _____
Alias _____	Description _____
Alias _____	Description _____
Alias _____	Description _____

GLO survey by Dennis Hatho, US Deputy Surveyor under contract 73 dated June 8, 1857 - (DCSO Records Vol. 16 Page(s) 6678

A cedar 9" dia., corner secs. 1, 2, 11, & 12, from which

A fir, 12" dia., bears S.30°W. 41 lks. 27.06

A fir, 12" dia., bears N.50°E. 21 lks. 13.86

VERY LRG ROOTHOLE - A fir, 36" dia., bears S.32°E. 32 lks. 21.12 - RH NEAR BED

A fir, 6" dia., bears N.46°W. 56 lks. 36.96

Thomas E. Shrum, Jr. - For: US Plywood - Champion Papers, Inc - June 1967, Filed July 1968 - C.S. File 55/106 & M36-14

Found - 36" Fir S.32°E., 21.10 ft.

Set 2 1/2" alum. cap

NOTED 11" X 1 1/2" FT - 7" Fir N.44°30'E., 22.15 ft. (1986 AGREES) EVIN HEALEN BLZ, STAMP

12" 6" Cedar N.2°W., 11.75 ft. (1986=N03°E) FHDB

NO EVID. - 6" Cedar S.33°30'W., 22.70 ft. (1986=S36°W)

SNAG 15" X 11 FT. 12" Fir S.05°30'E., 23.85 ft. (1986=S01°E) FHDB

Fd. 7/16/1986 - R. Geisler, C.S. 63/34

PROT 12" CAP

NEW BT 1

"U.S.P.C. PROP. COR.

T30S R1W

12" D. FIR "T30SR1W51" "CSBT" N32 3/4 E, 198

2 1/2  
1967 11/12

10" D. FIR "T30SR1W512CS" "BT" S 51° E, 282

RE. 4287

4" MADRONE "X" "BT ON H-1-L" S 68° W 100 TO NAIL IN BASE SCRIPD TRNK IN MULTI TRNK SHRUBBY TREE

COR OF REPROD SE QUAD.  
OTHER QUADS OLD GROWTH

~ 300 FT EAST FROM FORESTRD.

CS 67/50-27