

FILED 11/18/2021

RSS: 500300

T2SS R07W SEC 22

DATE: MAY 16, 2019

CREW:

S22 S23

S27 S26

PARTY CHIEF - S. J. FLAUSE

TECH - J. A. LORSUNG

MONUMENT:

FROM 1968 DCSO RENEWAL A
2 1/2" DIA. BRASS CAP (MARKED AS
PREVIOUSLY NOTED) ON A 1" I.D. I.P
BURIED APPROX 6" BELOW GROUND

BURIED: 6"

FOUND REF'S:

NO ORIG. EVID. NO 1922 RENEWAL EVID.
ONE 1968 RENEWAL B.T. A 36" DIA
MAPLE WITH A FH SB; BEARS N21°E, 185 ±
FT. DIST (AS PER RECORD).

ONE 2000 DCSO RENEWAL B.T. A FALLEN
30" DIA. B. OAK WITH A FH DB; THE ROOT-
HOLE OF THIS TREE BEARS N59°4'W, 284 ±
FT. DISTANT (AS PER REC.)

NEW REF'S:

1/2" COUNTY SURVEYOR YELLOW PLASTIC CAP ON
A 5/8" x 30" IRON ROD SET NEAR SOUTH EDGE
OF SMALL APPLE TREE'S ROOT CROWN

CS 67/50-31

OVER

(2)

FOUND REFS. CONTD:

BEARS $N 48 \frac{1}{2}^{\circ} E$, 7 ⁸⁹ FT. DISTANT
A PLASTIC CARBON ROD (AS PREVI-
OUSLY DESCRIBED) SET NEAR WEST EDGE
OF SMALL APPLE TREE'S ROOT CROWN; BEARS
 $S 27 \frac{3}{4}^{\circ} W$, 16 ¹³ FT. DISTANT.

BEARINGS ARE LOCAL COMPASS BEARINGS
DECLINATION = $14 \frac{3}{4}^{\circ} E$

B.G. MONUMENT IS APPROX. 180 FT
SOUTH FROM UMPQUA RIVER'S HIGH
LEFT BANK AND APPROX 20 FT EAST
FROM $\frac{1}{2}$ OF ACCESS LANE BETWEEN
TWO ORCHARD PLOTS.

CS 67/50-31

ALL WEATHER WORKING PAPER

J. L. DARLING CORP. TACOMA, WA 98424-1017
www.RiteInTheRain.com

No. 312

T25S, R7W, 500300

S-16-19

36" MAPLE N21°E, 1853

N33W MYRTLE WASHED AWAY

30" B. OAK DOWN ^{FIBER} ROOT-HOLE N59¹/₄W

NEW BO'S

BOTH 5/8" x 30" IR. ^{1 1/2"} / PIST CO SURVEYOR CAP

ONE NEAR SOUTHWEST RC OF SMALL MAPLE

N48¹/₂°E, 7.89

ONE NEAR WEST EDGE RC OF SMALL MAPLE


S27³/₄°W, 16.13

20' EAST OF LANE BETWEEN TWO
ORCHARD PLOTS

CS 67/50-31

RIVER HIGH BANK

36" MAPLE

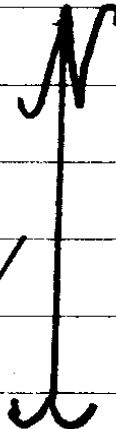

5/8 IR

5/8 IR

ORCHARD RD.

ORCHARD

CS / 67/50-31