

T235, R10W, S2

CC

S3|S2

PLSS 50000

DATE 7/18/19

Filed 11/18/2021

CREW:

PARTY CHIEF - S. J. FLAUSE

TECHNICIAN - J. A. LORSUNG

MONUMENT:

FROM 1958 OREGON STATE BOARD
OF FORESTRY SURVEY A 3" DIAM.
BRONZE CAP ON A 1 1/2" I.D. IRON PIPE.
CAP IS MARKED AS DESCRIBED.

PROT: CAP

IS NOW 5"

BELOW GROUND

FOUND REF.'S

FROM 1958 OSBF SURVEY ONE
BT FOUND: A FIR STUMP AS DESCRIBED
IN 1996 RENEWAL; FOUND AT REC BEARING
AND DISTANCE.

FROM 1970 BLM RESURVEY ONE
B.T.: AN 18" DIA. ALDER WITH NOW ILLEG-
IBLE SCRIBE MARKS; FOUND AT RECORD
BEARING AND DIST.

FROM 1996 OREGON DEPT. OF FORESTRY
RENEWAL TWO CARSONITE MARKERS:
SW MARKER FOUND A RECORD Brg AND DIST.

CS 67/50-34

OVER →

T235, R10W, PLSS 500700 CONT'D

OTHER MARKER BEARS S 30° E, 245 FT. DISTANT (REC. S 35° E, 245 FT.).

NEW REFERENCES:


A 25" DIA. GRAND FIR, SCRIBED "T235 R10W S 2 CC" "CS BT" ON A DOUBLE BLAZE; BEARS S 23 1/2° E, 108 2 FT. DISTANT.

DECLINATION 15° E

COMMENTS:

MONUMENT ON RELATIVELY FLAT RIDGEBACK IN OLD REPROD FIR, HEMLOCK AND ALDER.

SKETCH:

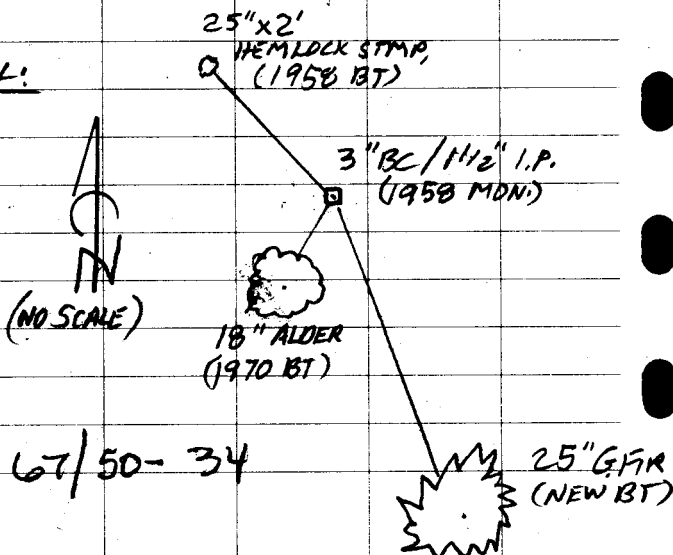

CS 67/50-34

RENEWED 7/18/19
SEE PG 2&3
MOST WSTLY

TOWNSHIP 23 RANGE 10 POINT IDENTIFIER # 500700

PRIMARY CORNER DESCRIPTION C C for Secs. 2 & 3 only, (North)

| | |
|-------------|-------------------|
| Alias _____ | Description _____ |
| Alias _____ | Description _____ |
| Alias _____ | Description _____ |
| Alias _____ | Description _____ |

GLO survey by - William H. Byars, Deputy Surveyor, Under Contract No. 292, dated Aug. 7, 1878 - (DCSO records Vol. 4 Page(s) 1741)

Set a Fir post, 5 ft. long, 5" dia., 20" in the ground for the cor. to secs. 2 & 3, from which,
 A Fir 36" dia., bears S.40°E., 36 lks. dist.
 A Fir 60" dia., bears S.50°W., 25 lks. dist.

GLO survey by Aurelius Todd, Deputy Surveyor, under Contract #629, dated April 24, 1894 - (DCSO records Vol. 4 Page(s) 1757)

A Post 5" dia., firmly set 2 ft. above ground for cor. to secs. 2 & 3, mkd. S2 on E.; T23S R10W on S.; S3 on W. with 2 notches on E. and 4 notches on W. faces, from which
 A Fir 36" dia., bears S.40°E., 36 lks. dist. mkd. T23S R10W S2 BT.
 A Fir 60" dia., bears S.50°W., 25 lks. dist. mkd. T23S R10W S3 BT.

GLO survey by Levi C. Walker, Deputy Surveyor, under Contract #763, dated June 20, 1905 - (DCSO records Vol. 7 Page(s) 2740)

At point of intersection, Set a Fir post, 3 ft. long, 4" sq., 24" in the ground for C C of secs. 2 and 3, marked CC T23S R10W on S.; S2 on E.; and S3 on W. face, with 2 grooves on E. and 4 grooves on W. face, from which ^{42 24}
 A Hemlock 20" dia., bears S.58°E., 64 lks. dist. mkd. T23S R10W S2 BT.
 An Alder 24" dia., bears S.86°W., 23 lks. dist. mkd. T23S R10W S3 BT.

I make diligent search, but find no trace of cor. set by W.H. Byars for cor. to secs. 2 and 3, which is described as being a fir post with bearing trees.

Survey by Arnold Gibson and Elbert Driver - For: Oregon State Board of Forestry - April 4, 1958 - C.S. File 42/353 and M 10-19

Original post now missing, from which
 20" Hemlock bears S.58°E., 64 lks., now missing, pieces of broken up stump with back cast of scribe "2" visible, found nearby.
 24" Alder bears S.86°W., 23 lks., now missing, possible orig. log nearby, no markings found.
 (Cont. Next Page)

CS 67150-34

TOWNSHIP 23 RANGE 10 POINT IDENTIFIER # 500700

PRIMARY CORNER DESCRIPTION C C for Secs. 2 & 3 only, (North)

| | |
|-------------|-------------------|
| Alias _____ | Description _____ |
| Alias _____ | Description _____ |
| Alias _____ | Description _____ |
| Alias _____ | Description _____ |

7/12/19

Set 1½" x 36" galv. I.P. with 3" bronze cap mkd. "Ore. St.Bd. of Forestry T22S R10W S35 T23S R10W S2 S3 CC 1958 RS 359", 33" in ground, in mound of stone, and from which:
 24" Hemlock stump bears S.45°W., 92.5 ft. scribed T23S R10W S3 BT.
 18" Hemlock bears N.38½°W., 58.5 ft. scribed RS 359.
 Set 4x4x72" white painted cedar post 1.0 ft. SE of pipe.
 OSBF metal location poster on 18" Hemlock BT.
 Center of road bears S.39°E., 79.0 ft.
 (South 1/4 cor. to sec. 35 bears N.88°50'E., 88.3 ft. (prop. dist.))

BLM resurvey by James E. Jelley, Cadastral Surveyor - under Group #718, surveyed June/Aug 1970 - (DCSO records Vol. 36 Page(s) 14840)

 The closing cor., reestablished and recorded by the OSBF in 1958, monumented with an iron post, 2" dia., firmly set, projecting 2" above ground and in a mound of stone 3 ft. base, to top, with brass cap mkd:

| |
|---------------|
| T 22 S R 10 W |
| S 35 |
| S 3 S 2 |
| T 23 S R 10 W |
| CC |
| 1958 |

NOW
5" BELOW GROUND

from which new bearing trees:
 A Wild Cherry 5" dia., bears S.10 3/4°E., 14½ lks. dist. mkd. T23S R10W S2 CC BT.
 An Alder 7" dia., bears S.33°W., 45 lks. dist. mkd. T23S R10W S3 CC BT on bark blaze.

Fd. OK, Jan. 1982 by R. Hintz - M 91-1

Oregon Dept. of Forestry - Lloyd D. Smith, L.S. 1101 - Tim Van Vleet - Sept. 1996 - C.S. File 65/8-11

 Found - Oregon State Board of Forestry pipe & cap.
~~GONE~~ 24" Hemlock stump bears S.47°W., 92.5'; **now** 13"x13" high rotten stump in place, face rotted away. (1958)
FOUND 18" Hemlock bears N.38½°W., 58.5'; **now** 25"x2' high rotten stump in place, face missing. (1958)
~~GONE~~ 4"x4"x72" white painted cedar post bears Southeast 1.0'; **now** rotted and fallen over. (1958)
~~GONE~~ 5" Cherry bears S.10 3/4°E., 14½ lks; **now** down and rotten, bearing tree tag on top of log. (1970)

CS 67/50-34

(Cont. Next Page)

TOWNSHIP 23 RANGE 10 POINT IDENTIFIER # 500700

PRIMARY CORNER DESCRIPTION C.C. for Secs. 2 & 3 only, (North)

Alias _____ Description _____

Alias _____ Description _____

Alias _____ Description _____

Alias _____ Description _____

18" 7" alder S.33°W., 45 lks.; ²⁹²now 16" in place, bark scribes visible. (1970) *BARK SCRIBES NOW ILLEG.*

New Accessories -

Orange carsonite marker CBM-250 labeled witness post bears S.43°W., 2.0' to base.

Orange carsonite marker CBM-250 labeled witness post bears S.35°E., 2.45' to base.

Note - Magnetic Variation 20½° East.

30°

NEW BT

25" T23SR10WS2CC "CSBT" S23½°E, 1087

588°E, 87° to S 1/4 35

CS 67/50-34