

GOVERNMENT CORNER RESTORATION FORM

FILED

TOWNSHIP 26S RANGE 2W SEC. S29 PLSS # 240200

Date: 11-22-2021 By: [Signature]  
This survey consists of:

DOUGLAS COUNTY OREGON

DATE 5/19/21

Map: \_\_\_\_\_

Narrative: \_\_\_\_\_

Corner Rpt: 67/51-7

Corner Designation

1/4 COR      S29  
                  S32

DOUGLAS COUNTY  
SURVEYOR

Previous Renewals EDWARDS 2010 M 160-76  
Monument(s) Found:      (Condition and Source)

- \_\_\_\_\_ Condition Report
- \_\_\_\_\_ Not Found
- Renewed
- \_\_\_\_\_ Unrecorded
- \_\_\_\_\_ Surveyed In

MONUMENT DETAIL

5/8" Iron Rod with 2 1/2" Alum.  
CAP Projecting 6"

\_\_\_\_\_

\_\_\_\_\_

T26S R2W  
S29  
S32  
LS 2339  
2010

Accessories Found

2010 BEARING Trees

24" W Fir N 10° E 15.45 FT (REC N 7° E) Visible Scribes  
Now FIRE Killed

14" D. Fir N 36° E 22.35 FT (REC N 41° E) Visible Scribes  
ON PARTIALLY HEALED SINGLE BLAZE

4" ± 3 FT BURST STUB S 81° E 20.90 FT (REC S 76° E)

4' Steel Post 2.0 FT EAST

LAT: 43°16'17.87" N      LONG: 122°57'39.06 W

C.S. File 67/51-7

RENEWAL

Monument Set (Procedure and Description)

MONUMENT DETAIL

New Accessories

21" X 1 FOOT D. FIR STUMP S49°E 19° FT TO 4"  
MAG NAIL IN TOP CENTER

24" X 1 FOOT D. FIR STUMP S61°W 14° FT TO A  
4" MAG NAIL IN TOP CENTER

Sketch of Monument, Accessories, and General Area

Location & Comments

CORNER IS ON NORTH  
EDGE OF LARGE CLEAR  
CUT OLDER REPROD TO  
NORTH MOSTLY BURNT

CORNER IS 110 FT WEST  
OF ACCESS RD.

Comp. Decline. 14 1/2° E


Agency DCSO

Party Chief J. F. HOUSE

Note keeper

Witnesses J. LORSUNG

REGISTERED  
PROFESSIONAL  
LAND SURVEYOR

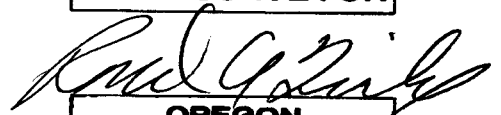

OREGON  
JULY 14, 1978  
RONALD A. GUMBLY  
1654

Expires: 12/31/2022

CS 67/51-7

BURN REVISIT 5/19/21 BURNED?

8/31/20

TOWNSHIP 26 RANGE 02 POINT IDENTIFIER # 240200

PRIMARY CORNER DESCRIPTION 1/4 Cor. Secs. 29 & 32

Alias	Description
Alias	Description
Alias	Description
Alias	Description

GLO survey by Wm. N Gibb, Deputy Surveyor, under contract No. 783, dated Dec. 3, 1908 - (DCSO records Vol. 10 Page(s) 4243)

Set cedar post, 3 ft. long, 5 sq., 24" in the ground for 1/4 sec. cor. mkd 1/4 S29 on N & 32 on S face, from which  
 A chinquapin, 8" dia., bears N.5°W., 14 lks. mkd: 1/4 S29 BT  
 A chinquapin, 8" dia. bears S.20°W., 20 lks. mkd: 1/4 S32 BT

Douglas Co. Surveyors Office - Vernon "Ray" Tracy - June 30, 1967 - C.S. File 54/40-10

Reported as not found.  
 Apparently destroyed by logging.

David Edwards - For: Seneca Jones Timber - 5/2010 - M 160-76

Set - 5/8"x30" steel rebar with 2 1/2" dia., alum. cap mkd: "LS 2339" and "2010 and as per the 1973 BLM manual set at proportionate position. 01"

An 18" dia. W. Fir bears N 36° E., 15.65 ft. " T265 R2W S29 BT " FACES BURNED BUT LEGIBLE  
 An 11" dia. D. Fir bears N 36° E., 22.35 ft. " " " " " PHSB ALL SCARB VIS  
 A 7" dia., Fir bears S. 76° E., 20.90 ft.  
 A 6 ft. steel post is set 012' East. T265 R2W S32 BT " UNBURNED BUT BLAZE BURNED OFF

NOW FIRE KILLED 24"  
 NEAR DEAD 4"

NEW BO'S 2 1/2" ALUM CAP ON 3/8" IR MAOL. 6"  
 " T265 R2W " S29  
 S32  
 LS 2339  
 2010

4" NAIL 21" X 1 FT. D. FIR STAMP S 49° E, 199  
 ~ 2/3 BURNED AWAY  
 INTO TOP CONTR.

4" NAIL 24" X 1 FT D. FIR STAMP S 61° W, 1/4 9  
 ~ 2/3 BURNED AWAY  
 INTO TOP CONTR.

MON IS 110' WEST FROM FOREST ACCESS RD

NORTH EDGE LRG. CLEAR CUT, OLDER SECOND GROWTH TO NORTH  
 NOW MOSTLY BURNED WITH SOME LIVE TREES

5/19/21  
 MM GPS 9:10 AM H.I. = 0.981 M

CS 62/51-7