

GOVERNMENT CORNER RESTORATION FORM

FILED

TOWNSHIP 26S RANGE 03W SEC. 13 PLSS # 640400

Date: 11-22-2021 By: sc  
This survey consists of:

DOUGLAS COUNTY OREGON

DATE 5/25/21

Map: \_\_\_\_\_

Corner Designation

Narrative: \_\_\_\_\_  
Corner Rpt: CS67 | 51-8

DOUGLAS COUNTY  
SURVEYOR

$\frac{1}{4} \frac{513}{524}$

- Condition Report
- Not Found
- Renewed
- Unrecorded
- Surveyed In

Previous Renewals 1960(53?), 1966, 2011, BLM RESURVEY, PENDING  
Monument(s) Found: (Condition and Source)

MONUMENT DETAIL

A 3 1/4" DIA. BLM BRASS CAP ON A 2" I.D. IRON PIPE FOUND PROJECTING 1 INCH ABOVE GROUND.

T26S R3W  
 $\frac{1}{4} \frac{513}{524}$   
2019

MONUMENT FROM PENDING BLM RESURVEY, NOT YET RECORDED AT DC SO.

Accessories Found

FROM THE 2011 DC SO RENEWAL THE FOUR NEW B.T.'S ARE ALL NOW FIRE KILLED AND PARTIALLY BURNED:

AN 8" DIA. DEAD D. FIR WITH A FULLY HEALED DOUBLE BLAZE BLOCKED BY FALLEN MATERIAL WE DO NOT CHECK B & D.

A 19" DIA. DEAD HEMLOCK WITH A BURNED PARTIALLY HEALED DOUBLE BLAZE SHOWING SOME ILLEGIBLE SCRIBING:  
BEARS S46°E, 5<sup>±</sup> FT. (TO RIGHT SIDE CENTER NAIL, RECORD DIST. 4<sup>±</sup> FT.).

A 9" DIA. DEAD D. FIR WITH A FULLY HEALED DOUBLE BLAZE:  
BEARS S59°W, 13<sup>B</sup> FT. (RECORD S55°W, 13<sup>±</sup> FT.) NEW DIST. TO RIGHT SIDE-CENTER NAIL.

A 20" DIA. DEAD D. FIR WITH A FULLY HEALED DOUBLE BLAZE:  
BEARS N13°W, 18<sup>±</sup> FT. (TO RIGHT SIDE CENTER NAIL, RECORD DIST. 18<sup>±</sup> FT.).

RENEWAL

Monument Set (Procedure and Description)

MONUMENT DETAIL

N/A

New Accessories

A FIRE KILLED 9" DIA. N. FIR, NOT BLAZED OR SCRIBED BUT A 4 INCH SPIKE NAIL IS DRIVEN IN TREE'S RIGHT SIDE CENTER. THIS TREE BEARS N49°E, 199 DISTANT.

Sketch of Monument, Accessories, and General Area

Location & Comments

LAT 43°18' 01.14" N  
LONG 123°00' 01.63" W

CORNER IS APPROX. 75 FT. NORTH OF GRAVELLEN FOREST ROAD.

AREA BADLY BURNED SEPT. 2020.

Comp. Decline. 14 1/2° E

Agency DCSO

Party Chief S.J. FLAUSE

Note keeper "

Witnesses J.A. LORSUNG

REGISTERED PROFESSIONAL LAND SURVEYOR

*Ronald A. Quimby*


OREGON JULY 14, 1978 RONALD A. QUIMBY 1854

Expires: 12/31/2022


CS 67/51-8

T26S, R03W, PLSS 640400

5/25/21

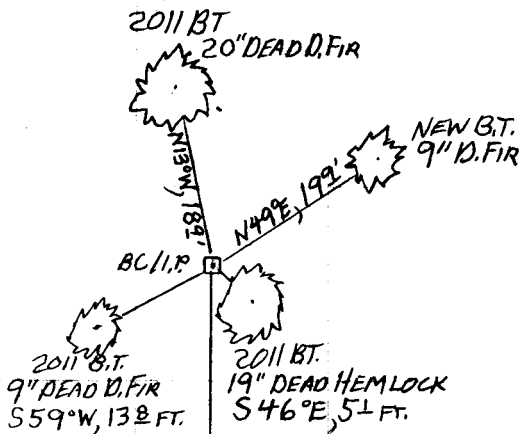

75 FT.

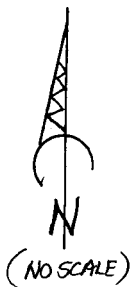

GRAVELLED FOREST RD.

CS 67/51-8

5/25/21

TOWNSHIP 26 RANGE 03 POINT IDENTIFIER # 640400 ~~FEDERAL~~

PRIMARY CORNER DESCRIPTION 1/4 Cor. for Secs. 13 and 24

Alias _____	Description _____
Alias _____	Description _____
Alias _____	Description _____
Alias _____	Description _____

A 30" fir now a 36" dia., 2 ft. tall backless and rotted fir stump with no "W" nail in possible face; bears N.34°W., 27.2 ft. to CRC (Rec. N.34°W., 25.4 ft (this dist is to face of stump))

New - ~~NOT CHKA~~ A 5" DBH D.Fir scribed "1/4 S13 CS" "BT" on a double blaze; bears N.48°E., 13.8 ft.

DEAD 19" A 17" DBH hemlock (intergrown at the NE edge of its base with a 12" DBH D.Fir) scribed "1/4 S24 CS" "BT" on a double blaze. The CRC of the combined two trees bears S.46°E., ~~4.3 ft.~~ 5' TO NAIL RSC

DEAD 9" A 6" DBH D.Fir scribed "1/4 S24 CS" "BT" on a double blaze; bears S.59°W., ~~13.3 ft.~~ 13.8 TO NAIL RSC 659°W FHD B

DEAD 20" A 17" DBH D.Fir scribed "1/4 S13 CS" "BT" on a double blaze; bears N.13°W., ~~18.4 ft.~~ 18.9 TO NAIL RSC FHD B

Note - Monument is on very gentle north slope in older mixed fir and hemlock reprod forest; approx 75 ft north from a graveled forest road.  
15 1/2°E decl.

BURNT PAB  
ILLEG SCRB

Fd as per 2011 DCS rehab. by D. Edwards, 10/2012 - M164-32

NEW BT NAIL IN BASE RSC DEAD 9" FIR N49°E, 19.9' NO FACE OR SCRB DONE

NEW BLM 3 1/4" "T265 R3W"  
ON 2" 10 IP PROC 1 INCH.

114 5 13  
524  
2019

5/25 MM GPS TIME 12:30 HI. = .9565 M

5/27 MM GPS TIME 9:15 HI. = 1.1825 M

CS 67/51-8

TOWNSHIP 26 RANGE 03 POINT IDENTIFIER # 640400

PRIMARY CORNER DESCRIPTION 1/4 Cor for Secs 13 and 24

Alias_____	Description_____
Alias_____	Description_____
Alias_____	Description_____
Alias_____	Description_____

Original - Samuel C. Flint, Under Contract #454, dated June 19, 1882 (DCSO records, Vol. 10 Page 4390)

-----  
Set fir post, 3 ft. long, 3" sq., firmly in the ground for 1/4 sec. cor. marked 1/4 S on N and S faces, from which  
A Fir 22" dia., bears N.74°E., 6 lks. dist.  
A Chinquapin, 12" dia., bears N.52°W., 88 lks. dist.

Weyerhaeuser Timber Company & Youngs Bay Lumber, by Lester E. Calder; Glen McChesney; Tom Shrum; Don Wright  
April 1960 C.S. File 51/87-2 (1953? c.s. 53/115-10)

-----  
The joint survey of 1950-51 found no evidence of the original corner. The area has been covered by an old burn.  
1950-51 survey set 3" sq. Yew post for corner by single proportion method. Referenced by Curtis Price (Plates & "W" nails only).  
32" Fir N.22°W., 29.9 ft.  
48" I.Cedar N.80°E., 36.1 ft.

Harley E. Case and John Wilson, for Weyerhaeuser Company  
May 1966, C.S. File 55/19-1

-----  
Found - No trace of GLO 1882 survey corner.  
22" Fir N.74°E., 6 lks. - No trace  
12" chinquapin N.52°W., 88 lks. - No trace.  
Set 1" Monel Pipe for corner by single proportionate method.  
Referenced by Glenn McChesney (Plates & "W" nails only)  
30" Fir, N.34°W., 25.4'  
44" I.Cedar, N.84°E., 33.7'

NOTE: This supercedes the 1/4 corner set by Curtis Price for Weyerhaeuser Co. in 1950-51 survey of section 24, using staff compass and chain.

Douglas Co. Surveyors Office - Stephen J. Flause - Mike Koch - Garrett McGraw - April 1, 2011 - C.S. File 67/33-25

-----  
Found - 1" ID monel pipe is firmly set and protrudes 4" above ground. 1965  
We do not find the 1960 monument.  
Remains of 2 BTs orig. mkd in 1960 & re-described in 1965  
A 48" I.Cedar now 44" dia., 3 1/2 ft. tall, backless and rotted I.Cedar stump with a "W" nail on its face (no other markings fd) bears N.84°E., 35.7 ft. to center of root crown (CRC) (rec. N.84°E., 33.2 ft. (This distance is to "W" nail)) 1965 continued next page

CS 67/51-8