

GOVERNMENT CORNER RESTORATION FORM

FILED

TOWNSHIP 24S RANGE 8W SEC. 2 PLSS # 500700

Date: 11/23/2021 By: X

This survey consists of:

DOUGLAS COUNTY OREGON

DATE 8-4-21

Map: \_\_\_\_\_

Narrative: \_\_\_\_\_

Corner Rpt: 67/51-15

DOUGLAS COUNTY SURVEYOR

Corner Designation

	<u>T235</u>	
<u>R</u>	<u>53</u>	<u>52</u>
<u>W</u>	<u>T245</u>	

Previous Renewals DCSO BRASS CAP  
Monument(s) Found: (Condition and Source)

2 1/2" DCSO BRASS CAP ON  
1" ID IRON PIPE PROJ 6" FROM ROAD FILL

DCSO 1967 CS 54/12-17  
ROD QUIMBY FOR ROSEBURG  
RESOURCES CO. 2018. M 174-23  
ROD QUIMBY FOR ROSEBURG  
RESOURCES CO. 2019 CS 65/102-49

- Condition Report
- Not Found
- Renewed
- Unrecorded
- Surveyed In

MONUMENT DETAIL

Accessories Found

1967 DCSO  
30" D. FIR 53L°E 11 1/2 FT (Rec 539°E) Fully Healed BLZ  
17" D. FIR (519W 82°E FT Rec) FALLEN ON FACE  
2018 QUIMBY SURVEY  
A 4" D. FIR STUMP 5' TALL 578°E 42° FT VIS. SCRIBES  
A 6" D. FIR 576°W 32° FT VIS SCRIBES  
6' ALUM POST WITH LOCATION TAG E 11 1/2 FT

RENEWAL

Monument Set (Procedure and Description)

MONUMENT DETAIL

---



---



New Accessories

17" X 9 FT TALL SAWN D. FIR STUMP  
 N 66° E 3.9 FT NOT BLAZED OR SCRIBED

Sketch of Monument, Accessories, and General Area

Location & Comments

see pg 4/5

MONUMENT IN ROAD  
 KILL ON STEEP S.W  
 Slope Recent CLEAR  
 CUT TO NORTH LARGE  
 Reprod To South.

Comp. Decline, 1A<sup>34</sup>° E  
 Agency DCSO  
 Party Chief S. FIAUSE  
 Note keeper \_\_\_\_\_  
 Witnesses J LOISUNG

**REGISTERED  
 PROFESSIONAL  
 LAND SURVEYOR**

*Ronald A. Quimby*

**OREGON  
 JULY 14, 1978  
 RONALD A. QUIMBY  
 1854**

Expires: 12/31/2022

# CORNER RENEWAL

DATE Aug. 4, 2021

RENEWAL STATUS RENEWED ~~RENEWED~~

~~525700~~ T24S R30W  
A77100

FROM 1967

DCSO RENEWAL: A 2 1/2" BRASS CAP  
ON A 1" I.D. IRON PIPE

CAP MARKED  
AS AT RIGHT:

COUNTY SURVEYOR'S OFFICE

MONUMENT FOUND: PLUMBS AND PROJECTING  
6" FROM RD. FILL BANK

T 23 S  
S 3 | S 2  
T 24 S  
1967

R  
8  
W

### NEW BEARING OBJECTS

17" x 9 FT. TALL

SAWN D. FIR STUMP

N 66° E, 39 FT NOT BLZED OR SCRIBED.

### HISTORICAL OBJECTS

FROM 1967 DCSO

A 30" D. FIR

S 36° E, 11 1/2 FT (REC. BRG. S 39° E) FULLY HEALED BLZ.

FROM 1967 DCSO

THE SW 7" D. FIR

NOW A FALLEN 17" D. FIR, FALLEN ON FACE

FROM 2018 QUIMBY

THE SE 4" D. FIR


NOW 4" x 5 FT TALL SAWN TREE, (FND AT RECORD B & D.)

ALL OTHER 2018 ACCESSORIES FOUND AS DESCRIBED

LOCATION AND COMMENTS

MONUMENT IN ROAD FILL ON A STEEP SW SLOPE, RECENT CLEARCUT TO NORTH, LARGE REPROD TO SOUTH.

SKETCH

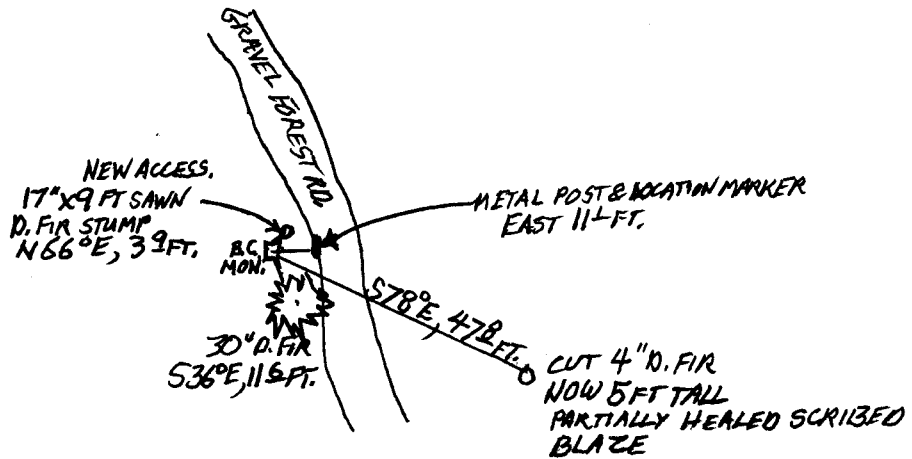

DECLINATION:  $14\frac{3}{4}^{\circ} E$

CREW: PARTY CHIEF - S. J. FLAUSE    TECHNICIAN J. A. LORSUNG

COORDINATES:

TOWNSHIP 23 RANGE 08 POINT IDENTIFIER # 477100

PRIMARY CORNER DESCRIPTION Sec Cor. for 2 & 3, T24-8

Alias \_\_\_\_\_ Description \_\_\_\_\_  
Alias \_\_\_\_\_ Description \_\_\_\_\_  
Alias \_\_\_\_\_ Description \_\_\_\_\_  
Alias \_\_\_\_\_ Description \_\_\_\_\_

GLO Survey by Henry L. Chandler, U.S. Deputy Surveyor, under Contract #619, dated June 5, 1893 - (DCSO records Vol. 6 Page(s) 2541)

-----

Set a post 4½ ft. long, 4" sq., 24" in the ground for cor. to secs. 2 and 3 marked, T24S S2 on SE.; and R8W S3 on SW.; faces with 4 notches on W. and 2 notches on E. edges, from which

- A Fir 18" dia., bears S.80°E., 55 lks. dist. mkd. T24S R8W S2 BT.
- A Fir 14" dia., bears S.17°W., 132 lks. dist. mkd. T24S R8W S3 BT.
- A Fir 18" dia., bears N.7°W., 51 lks. dist. mkd. T24S R8W BT.

Douglas County Surveyors Office - Vernon "Ray" Tracy and crew Feb. 1967 - C.S. File 54/12-12

-----

Found - Orig. 14" now 30" W. Fir S.17°W., 87.1 ft., open and find fragmentary scribe on mostly rotted face. Tree now snag.  
Orig. 18" now 42" Fir N.7°W., 33.7 ft., alive, shows good scars. We do not open.  
No trace of SE. BT.

Set brass cap at cor. mkd: County Surveyors Office

T 23 S  
S 3 | S 2 T 24 S R 8 W  
1967

New BTs- 5" W. Fir S.19°W., 8.2 ft. mkd. S3 CS BT.  
OK 7" D. Fir S.39°E., 11.6 ft. mkd. T24S R8W S2 CS BT.  
Corner lies on steep, West slope, approx. 116 ft. W. of top of spur, course S. and approx. 182 ft. W. of Sec. Cor. of 34 & 35, T23-8

Ron Quimby - For: Roseburg Resources Co. - 4/2018 - M174-23

-----

Found - brass cap  
42"x5' tall stump bears N.7°W., 33.7' healed face  
Fir bears S.39°E., 11.6' - healed face  
17" fir bears S.19°W., 8.2' - healed face

New BTs- 4" fir bears S.78°E., 47.8'  
6" Fir bears S.76°W., 32.8'  
Both scribed "T24S R8W S2 BT"

New BO - 6' aluminum post w/location tag bears East 11.1'