

GOVERNMENT CORNER RESTORATION FORM

FILED

TOWNSHIP 26S RANGE 24W SEC. 22 PLSS # 500309

Date: 11/23/2021 By: X

DOUGLAS COUNTY OREGON

DATE 11-2-21

This survey consists of:

Map: _____

Narrative: _____

Corner Rpt: CS 67/51-23

Corner Designation _____

DOUGLAS COUNTY SURVEYOR

Previous Renewals 2" Alum Cap
Monument(s) Found: _____ (Condition and Source)

- ____ Condition Report
- ____ Not Found
- Renewed
- ____ Unrecorded
- ____ Surveyed In

MONUMENT DETAIL

2" Alum. Cap on 1/8" Iron pipe
Geisler 1983 M 94-80 Proj. 3"
GLO Survey by Gibb 1908
Vol 10 Pg 4234
GLO resurvey 1916-1918
Vol 10 pg 4327
Edwards 2004 M 143-66

T26S R2W

522		CC
529		

LS 1988
1983

Accessories Found

Bearing Trees by Geisler.
18" X 2' R. Cedar Stump bears N79°W 36.4 FT
14" D. Fir S29°W 22.3 FT Fully Healed double
BLAZE

5/8" Iron Rod Not Found

RENEWAL

Monument Set (Procedure and Description)

MONUMENT DETAIL

New Accessories

14" X 1 1/2' Red Cedar ^{BURNT} STAMP WITH 4" NINE NAIL
 Top Center bears 547°W 14.6 FT

20" X 1 FT Tall burnt STAMP WITH 8" GALVANIZED
 SPIKE Top & Center bears 570 1/2°E 27.1 FT

Sketch of Monument, Accessories, and General Area

Location & Comments

LAT. 43°17'05.02" N
 LONG 122°54'48.79" W

CORNER IS APPROX
 30' SOUTH OF GRAVEL
 ROAD

AREA BURNT 9-2020

Comp. Decline. 14 1/2° E
 Agency DCSO
 Party Chief S. F. HAUSE
 Note keeper
 Witnesses J. LORSUNG

REGISTERED
 PROFESSIONAL
 LAND SURVEYOR

Ronald A. Qumby


OREGON
 JULY 14, 1978
 RONALD A. QUMBY
 1854

CS 67/51-23

Expires: 12/31/2022



GRAVELLED FOREST ACCESS RD.

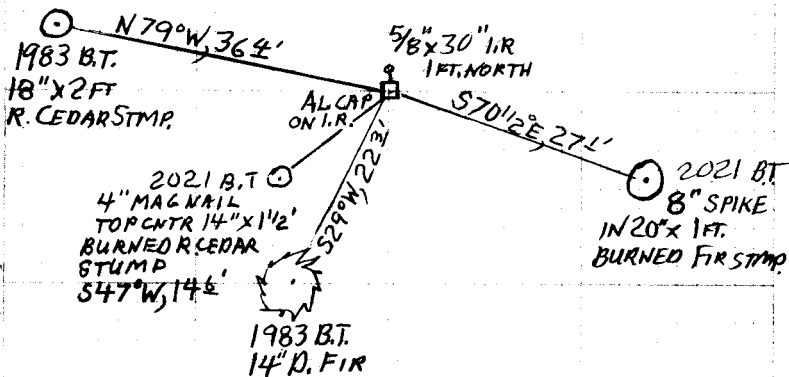

CS 67/51-23

TOWNSHIP 26 RANGE 02 POINT IDENTIFIER # 500309

PRIMARY CORNER DESCRIPTION East Sec cor Secs. 22 & 27 only

Alias _____ Description _____
Alias _____ Description _____
Alias _____ Description _____
Alias _____ Description _____

GLO survey by John A. McQuinn, Deputy Surveyor, under contract No. 466, dated April 5, 1883 - (DCSO records Vol. 10 Page(s) 4198-9)

Set a post, 4 ft. long, 4" sq. 24" in the ground, for cor. to secs. 22, 23, 26, & 27, marked T26S S23 on NE, R2W S26 on SE, S27 on SW, S22 on NW faces, with 2 notches on top & edges; from which

- A fir, 12" dia. bears N.45°E. 11 lks. mkd: T26S R2W S23 BT
- A hemlock, 18" dia., bears S.60°E., 55 lks., mkd: T26S R2W S26 BT.
- A cedar, 18" dia., bears S.30°W., 43 lks., mkd: T26S R2W S27 BT.
- A fir, 10" dia. bears N.20°W. 10 lks. mkd: T26S R2W S22 BT

GLO survey by Wm. N. Gibb, Deputy Surveyor, under contract No. 783, dated Dec. 3, 1908 - (DCSO records Vol. 10 Pg 4234)

Intersect N & S line, 15.41 chs N.54'E., of cor. secs. 22, 23, 26 & 27.

Set granite stone, 8x10x20", 15" in the ground for closing cor. secs. 22 & 27 marked CC on W face, with 2 grooves on S & 4 grooves on N face, from which

- A maple, 14" dia., bears S.30°W., 35 lks., mkd: T26S R2W S27 BT.
 - A fir, 40" dia. bears N.20°W. 48 lks. mkd: T26S R2W S22 BT
- destroy markings on old cor. referring to secs. 22.

Resurvey by Fred Mensch, U.S. Geodetical Engineer, under instructions dated May 25, 1916 & April 16, 1918, - (DCSO records Vol. 10 Page(s) 4327)

Intersect W bdy. of sec. 23, 8.99 chs. N.1°12'E. of cor. sec. 22, 23, 26 & 27, which I change to refer to secs 23 & 26 only
At the point of intersection

Set an iron post, 3 ft. long, 2" dia., 24" in th ground, for closing cor, of secs. 22 & 27, with brass cap marked

T26S
CC — S22 | S 23
 S27
 1918

from which -

- A hemlock, 12" dia., bears S.49°W., 54 lks. mkd C C T 26
S 2 R 2 W S 27 B T
- A fir, 40" dia., bears N.20°W., 16 lks. mkd: C C T 26 S R
2 W S 22 BT

continued next page

CS 67/56-23

11/2/21

TOWNSHIP 26 RANGE 02 POINT IDENTIFIER # 500309

PRIMARY CORNER DESCRIPTION East Sec. cor. Secs. 22 & 27 only

Alias _____	Description _____
Alias _____	Description _____
Alias _____	Description _____
Alias _____	Description _____

FD & used on BLM dependent resurvey by G. Steven Popken, Cadastral Surveyor, Group No. 871, surveyed June/Sept. 1975 - (DCSO Vol. 46 Page(s) 15723)

Ronald G. Geisler, L.S. 1988 - For: Champion International Corp. - June thru Aug. 1983 - M94-80.

Set ^{PROT. 3"} 2 1/2" alum. cap set on 7/8" x 36" I.P. properly marked and stamped "PLS 1988"

NOW 18" x 2 FT STUMP

New BTs - 6" R. cedar bears N. 79° W., 36.4 ft. scribed "T26S R2W S22 CC BT"

ALIVE 14 6" D. fir, bears S. 29° W., 22.3 ft. scribed "T26S R2W S27 CC BT"

FILED HEADED DOUBLE BLZ

Found ^{gone} A 5/8" iron rod that bears S. 89° 39' 44" W., 2.40 ft. ^{BURNED TO GROUND} Orig. 44" fir stump, bears N. 30° 15' W., 11.2 ft. closed face.

^{NO EVID.} Orig., 14" rotten hemlock stump bears S. 50° W., 37.2 ft. Scribed "26S R2W S27 CC BT."

Fd. Ok by D. Edwards, Feb. 2004 - M143-66

NEW REFS

4" MAGNAIL TOP OF 14" x 1 1/2 FT RED CEDAR BURNED STUMP BEAR S 47° W, 14 1/2 FT

8" GALVAN. SPIKE TOP OF 20" x 1 FT TALL BURNED STUMP BEARS S 70 1/2° E, 27 1/2 FT

CS 67/51-23