

GOVERNMENT CORNER RESTORATION FORM

TOWNSHIP 26S RANGE 21W SEC. 22 PLSS # 431300

DOUGLAS COUNTY OREGON

DATE 11-2-21

FILED

Date: 11/23/2024 By: JK

This survey consists of:

Map: _____

Narrative: _____

Corner Rpt: 0567/51-24

DOUGLAS COUNTY
SURVEYOR

Corner Designation

1/4 COR S22 only south

Previous Renewals GLO BEASS CAP
Monument(s) Found: _____ (Condition and Source)

- Condition Report
- Not Found
- Renewed
- Unrecorded
- Surveyed In

MONUMENT DETAIL

GLO RESURVEY 1916-1918
VOL 10 PG. 4328
DCSO 1967 CS 54/40-53
D. EDWARDS 2004 M 143-66

1/4 S22
1918

Accessories Found

GLO BEARING TREE
Root Hole N31W 15.8 FT
DCSO BEARING TREES 1967
16" X 2' SAWN Hemlock Stump N29°W 24.7 FT
39" X 2' R. CEDAR SAWN Stump N87°E 44.9 FT
Healed BLAZE

C.S. File 67/51-24

RENEWAL

Monument Set (Procedure and Description)

MONUMENT DETAIL

New Accessories

16" X 2' SAWN Hemlock Stump N29°W 21.7 FT
 4" MAG NAIL Top Center
 39" X 2' Red Cedar SAWN Stump N87°W 44.9 FT
 8" MAG Nail Top Center
 9" X 7 FT R. Cedar SNAG S11°E 26.1 FT Scribed
 1/4 S 22 CS BT on Double BLAZE BURNT
 28" X 4' SAWN FIR Stump N86°W 15.0 FT 4" MAG
 NAIL Top Center
 Steel Marker Post 2.0 NORTH & 1.5 FT South

Sketch of Monument, Accessories, and General Area


Location & Comments

LAT 43°17'05.38" N
 LONG 122°55'23.62" W
 see attached sheet

CORNER IS APPROX
 125 WEST OF OLD
 LOG ROAD
 AREA BURNT IN
 ARCHIE CREEK FIRE
 9-2020

Comp. Decline. 15°E
 Agency DCSO
 Party Chief S FIAUSE
 Note keeper
 Witnesses J. LORSUNG

REGISTERED
 PROFESSIONAL
 LAND SURVEYOR

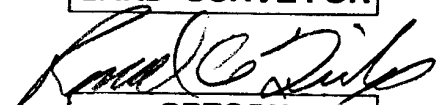

OREGON
 JULY 14, 1978
 RONALD A. QUMBY
 1854

CS 67/51-24

Expires: 12/31/2022

LINE XING
TAG ON TALL
CUT STUMP

GRAVELLED FOREST ACCESS RD.



1967 B.T.
16" x 2 FT. SAWN HEMLOCK STUMP
N29°W, 21¹/₂ FT.

UNKNOWN
ORIG. B.T.
28" x 4 FT
SAWN BURNED
FIR STUMP
N86°W, 15° FT.

B.C. N87°E, 44⁹/₁₆' 1967 BT
39" x 2 FT CEDAR STUMP

2021 BT
9" x 7 FT SAW AND BURNED
CEDAR SNAG

CS 67/51 - 24

11/2/25

TOWNSHIP 26 RANGE 02 POINT IDENTIFIER # 431300

PRIMARY CORNER DESCRIPTION 1/4 Cor. Sec. 22 only, South

Alias _____	Description _____
Alias _____	Description _____
Alias _____	Description _____
Alias _____	Description _____

GLO survey by Wm. N Gibb, Deputy Surveyor, under contract No. 783, dated Dec. 3, 1908 - (DCSO records Vol. 10 Page 4235)

Set cedar stake, 3 ft. long, 4" sq. 24" in the ground for 1/4 sec. cor., mkd. 1/4 S 22 on N face & dig pits, 18x18x12", E & W of cor. & raise mound of earth, 3 1/2 ft. base, 1 1/2 ft. high, N of cor., from which

A chinquapin, 7" dia. bears N.22°E., 12 lks. mkd: 1/4 S22 BT

GLO resurvey by Fred Mensch, U.S. Cadastral Engineer; under Instructions dated May 25, 1916 & April 16, 1918, - (DCSO records Vol. 10 Page(s) 4328)

Set an iron post, 3 ft. long, 1" dia., 26" in the ground, for 1/4 cor. of sec. 22 only, with brass cap mkd: 1/4 S22 1918

from which

A cedar, 36" dia., bears N.15°E., 40 lks., mkd: 1/4 S22 BT.

A fir, 8" dia., bears N.31°W., 24 lks., mkd: 1/4 S22 BT.

Cor. established by Gibb as 1/4 cor. on N bdy. of sec. 27, bears N.0°51'E., 6.04 chs. & cor. established as 1/4 cor. on S bdy. of sec. 22 bears N.58°02'E., 11.41 chs.

Douglas Co. Surveyors Office - Vernon "Ray" Tracy - Jack Heritage - E. West - Aug. 1967 - C.S. File 54/40-53

2 1/2" BC ON 3/4" 1.10 1.15 PROT. 15"

Found - 1918 GLO brass cap, firmly set, & properly marked.

ROOT HOLE Orig. 8" now 14" Fir, turned out, N.31°W., 15.8 ft., prev. opened & shows scribe.

No trace of NE BT

New BTs - 9" hemlock, N.29°W., 21.7 ft. mkd. 1/4 S22 CS BT.

15" R cedar N.87°W., 44.9 ft. mkd. 1/4 S22 CS BT.

Note - This corner lies on NE slope approx. 125 ft. W of AT old log access Rd.

Fd. Ok Feb. 2004, D. Edwards, M143-66

NEW REF.

BURNED 9' x 7' FT R. CEDAR SNAG SCRIBED "1/4 S22" "CS BT" ON BLZ.

BEARS S11°E, 26' FT, RSC 4" NAIL

ORIGIN UNKNOWN

28' x 4' FT FIR N 86°W, 15° RSC 4" NAIL

STEEL MARKER POSTS NORTH 20' AND SOUTH 15'

CS 67/51-24

16" x 2 FT. SAWN BTMP

SAWN 39" x 2 FT. STMP.

SET 4" MAG NAIL TOP CNTR OF STMP. NO BLZ EVID.

BLZ HEAL EVID.

SET 8" MAG NAIL TOP CNTR/STMP