

TOWNSHIP T26S RANGE 2W SEC. 34 PLSS # 500100

Date: 4/1/2022 By: X

This survey consists of:

DOUGLAS COUNTY OREGON

DATE 11-29-21

Map: _____

Narrative: _____

Corner Rpt: CS67/SL-35

Corner Designation

See Cor 34/35
3/2

DOUGLAS COUNTY
SURVEYOR

Monument(s) Found: (Condition and Source)

___ Condition report

3 1/4" BRASS CAP ON 2 1/2" IRON
PIPE PROJECTING 5" ORIGINAL
STONE NOW CRUMBLING ON SOUTH EDGE

___ Not Found

Renewed

___ Unrecorded

Previous Renewals

___ Surveyed In

GLO Survey 1882 Vol 10 pg 4184
GLO Survey 1908 Vol 10 pg 4224
GLO Survey 1913 Vol 10 pg 4262-63
GLO Survey 1916 Vol 10 pg 4289-90
BLM Resurvey 1957 Vol 29 pg 12204
DOSO 1967 CS 54/40-26
Geisler 1984 m 90-55
SHANER 2000 CS 65/36-2K m132-70
Accessories Found

MONUMENT DETAIL

T26S R2W
534/535
53/52
T27S
1957

1882 BEARING trees

24" X 3 1/2' SAWN BURNT FIR STUMP S73W

37.6 FT (Rec S75°W) SCRIBES BURNT OFF

36" X 25' TIPPOUT & BURNT FIR N68°W 36.3 FT

FULLY HEALED BLAZE

31" X 1 1/2' SAWN FIR STUMP N25 1/2° E 25.7 FT

28" D. FIR S27°W 56.5 FT (Rec S29 1/4° W 57.4 FT) 4" MAG

25" D. FIR N77 1/2° W 73.9 FT (Rec N76°W) 4" MAG NAIL

RT. Side Center

23" X 1 1/2' SAWN BROKEN MADROVE STUMP S85°E

55.4 FT (Rec S82°E)

32" X 1 1/2 FT BURNT-SAWN FIR STUMP S75°E

20.2 FT TO 4" MAG NAIL TOP CENTER

ALUM POST N-E-W

Monument Set (Procedure and Description)

MONUMENT DETAIL

New Accessories

Sketch of Monument, Accessories, and General Area

Location & Comments

see ATTACHED Sheet

LAT 43°15'26.46"N

LONG 122°54'42.78"W

AREA BURNED
9-2020

Comp. Decline. 14 1/2° E
 Agency DCSO
 Party Chief S. Flouse
 Note keeper _____
 Witnesses J. LORSUNG

**REGISTERED
PROFESSIONAL
LAND SURVEYOR**

Ronald A. Qumby



**OREGON
JULY 14, 1978
RONALD A. QUMBY
1654**

Expires: 12/31/2022

CS 67/51-35

T26S, R02W, 500100

11/29/21

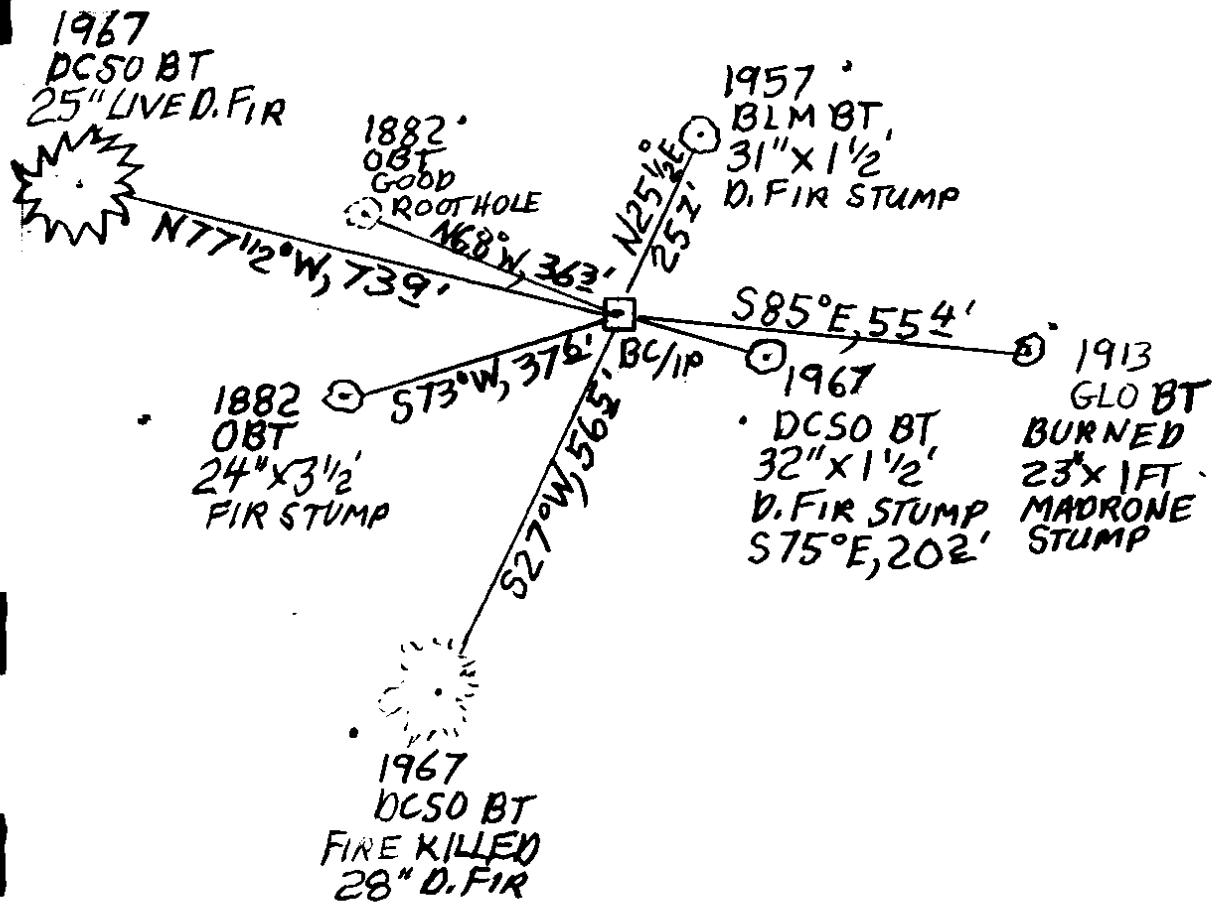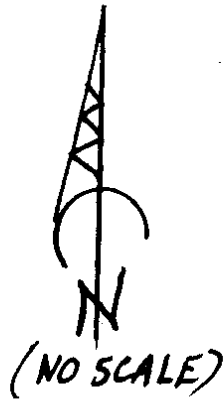

DECLINATION 14 1/2° E

CS 67/51-35
3/6

PRIMARY CORNER DESCRIPTION Sec. Cor. for 34 & 35; 2 & 3, T27-2

Alias _____	Description _____
Alias _____	Description _____
Alias _____	Description _____
Alias _____	Description _____

GLO survey by S.C. Flint, Contract #459, dated August 3, 1882 - (DCSO records Vol. 10 Page(s) 4184)

Set Laurel post 4 ft. long, 4" sq., 24" in the ground for cor. to secs. 2, 3, 34 and 35 marked T26S S35 on NE.; R2W S2 on SE.; T27S S3 on SW.; S34 on NW. faces with 2 notches on the E. and 4 on the W. edges, from which

A Fir 20" dia., bears N.55°E., 76 lks. dist. mkd. T26S R2W S35 BT.

A Fir 14" dia., bears S.20°E., 100 lks. dist. mkd. T27S R2W S2 BT.

A Fir 30" dia., bears S.75°W., 57 lks. dist. mkd. T27S R2W S3 BT.

A Fir 24" dia., bears N.68°W., 55 lks. dist. mkd. T26S R2W S34 BT.

NOW BURNED
24x3 1/2' SAWN STUMP
36" x 25' FOOT TIP OUT NOW BURNED

S 73° W ✓ 37 1/2
✓ 36 30

SEE FROM 1913

11/21
SCRUBBING NOW BURNED OFF
RESURFACE

FULLY HEALED 1913 REBLAZE GOOD B&P TO ROOTHOLE

GLO survey by William N. Gibb, Deputy Surveyor, under Contract #783, dated Dec. 3, 1908 - (DCSO records Vol. 10 Page(s) 4224)

At cor. secs. 34, 35, 2 and 3, which is a stake greatly decayed, marked and witnessed as described by the surveyor general. Set granite stone 8x10x14 ins., 10" in the ground for cor. secs. 34, 35, 2 and 3, marked with 4 notches on W. and 2 notches on E. edge.

GLO survey by C.M. Collier, Deputy Surveyor, under Instructions dated May/Sept. 1913 - (DCSO records Vol. 10 Page(s) 4262-63)

The Sec. cor. which is a post, nearly decayed, witnessed by the two westerly bearing trees and stumps of the other trees described by the surveyor general. I destroy this cor. and re-establish it in the same place, as follows:

Set a basalt stone 13x8x8 ins., 8" in the ground, for cor., marked with 2 notches on E. and 4 notches on W. edge; from which

A Laurel 7" dia., bears N.57°E., 71 lks. dist. mkd. T26S R2W S35 BT.

A Laurel 7" dia., bears S.82°E., 84 lks. dist. mkd. T27S R2W S2 BT.

A Fir 32" dia., bears S.75°W., 57 lks. dist. mkd. T27S R2W S3 BT. (orig. BT)

A Fir 30" dia., bears N.68°W., 55 lks. dist. mkd. T26S R2W S34 BT. (orig. BT)

CS 67/51-35
416

PRIMARY CORNER DESCRIPTION Sec. Cor. for 34 & 35; 2 & 3, T27-2

Alias _____	Description _____
Alias _____	Description _____
Alias _____	Description _____
Alias _____	Description _____

Fd. and used in GLO Survey by Fred Mensch, U.S. Surveyor Under Special Instructions dated May 25, 1916 - (DCSO records Vol. 10 Page(s) 4289-90)

BLM Resurvey by Harold D. Corbin, Cadastral Surveyor, under Special Instructions dated June 21, 1957 - (DCSO records Vol. 29 Page(s) 12204)

The Sec. cor., monumented with a basalt stone 13x8x8 ins., 8" above ground, firmly set, mkd. with 2 grooves on the E. and 4 grooves on the W. face, from which the remains of the original bearing trees, as follows:

- A madrone 7" dia., bears N.57°E., 71 lks. dist. with scribe marks BT visible on opened blaze.
- A Madrone 9" dia., bears S.82°E., 84 lks. dist. with healed blaze facing the cor.
- A Fir stump 36" dia., bears S.75°W., 57 lks. dist. with healed blaze facing cor.
- A Fir 36" dia., bears N.68°W., 55 lks. dist. with healed blaze facing the cor.

At the corner point

Set an iron post, 28" long, 2 1/2" dia., 26" in the ground, with brass cap mkd:

T26S	R2W
S 34	S 35
S 3	S 2
T27S	
1957	

from which

- A Fir 13" dia., bears N.25½°E., 39 lks. dist. mkd. T26S R2W S35 BT.
- A Fir 13" dia., bears S.43°E., 75 lks. dist. mkd. T27S R2W S2 BT.
- A Fir 13" dia., bears S.29¼°W., 87 lks. dist. mkd. T27S R2W S3 BT.
- A White Fir 10" dia., bears N.76°W., 112 lks. dist. mkd. T26S R2W S34 BT.

Deposit original cor. stone alongside iron post.

Douglas County Surveyors Office - Vernon "Ray" Tracy and crew July 1967 - C.S. File 54/40-26

Found - 1957 Cad. brass cap and original corner stone.
 13" now 15" Fir N.25½°E., 25.7 ft., alive, healed blaze.
 13" now 13" Fir, down, S.43°E., 49.5 ft., scribe visible on unhealed blaze.

(Cont. Next Page)

CS 62/51-35
5/6

TOWNSHIP 26 RANGE 02 POINT IDENTIFIER # 500100

FM OK
9/3/20

PRIMARY CORNER DESCRIPTION Sec. Cor. for 34 & 35; 2 & 3, T27-2

Alias _____	Description _____
Alias _____	Description _____
Alias _____	Description _____
Alias _____	Description _____

REVIST + GPS
11/29/21

13" now 16" Fir S.29 $\frac{1}{4}$ °W., 57.4 ft., alive, healed blaze.
 10" now 14" D.Fir (not W.Fir) N.76°W., 73.9 ft., alive, healed blaze.
 29" now 15" Laurel S.82°E., 55.4 ft. alive, healed blaze.

Do not open healed blazes. Only orig. SE. BT standing.
 New BT - 15" D.Fir S.75°E., 20.2 ft. mkd. T27S R2W S2 CS BT.
 Corner lies on top of spur, ridge sloping South at old cutting corner. Secs. 35, 2 and 3 cut off.

Fd. OK, April 1984 by R. Geisler - M 90-55

Bruce Shaner - 11/2000 - C. S. File 65/36-2K & M132-70

NOW 31" x 1 1/2' SAWN STMP BURNED
FIRE KILL - 28" 24" D.Fir, face o/grown, bears N.25 1/2° E., 25.7 ft. (ON STH EDGE RC)
NOW 23" x 1' SAWN BROKEN STMP BURNED
ALIVE - 25" 24" D.Fir, face o/grown, bears N.76° W 77 1/2° 73.9 ft. RSC 4" NAIL
32" x 1 1/2' SAWN STMP BURNED

Found - *PROT. 5"* 3 1/4" brass cap w/ 2 1/2" IP, properly mkd. *ORIG. STONE NOW CRUMBLED*
 30" D.Fir, face o/grown, bears N.25 $\frac{1}{2}$ °E., 25.7 ft. *(ON STH EDGE RC)*
 28" 24" D.Fir, face o/grown, bears S.29 $\frac{1}{4}$ °W 27 5/8° 57.4 ft. *TOP CNTR 8" NAIL*
 25" 24" D.Fir, face o/grown, bears N.76° W 77 1/2° 73.9 ft. *56 1/2' RSC 4" NAIL*
 22" Madrone, face o/grown, bears S.82°E 85° 55' 4 ft. *RSC 4" NAIL*
 28" D.Fir, face o/grown, (rec 15") bears S.75°E. 20.2 ft. *TOP CNTR 4" NAIL*

New - 6 ft. alum. post, bears West, 1.0 ft.
 6 ft. alum. post, bears North, 1.0 ft.

Note - Corner lies on top of major ridge, runs NW-SE.
 Compass declination 20°E *DECL 14 1/2° E*

ALSO OBTS SEE PG. 1 ★

METAL LATHS N, E, W

PARTIALLY BURNED REGROWTH TO WEST, BURNED OFF CLEAR-CUT EAST

AM GPS
TIME - 9:25
Hi - 2.00 M

CS 67/51-35
666 3

77 1/2