

GOVERNMENT CORNER RESTORATION FORM

FILED

TOWNSHIP 26S RANGE 3W SEC. 25 PLSS # 600200

Date: 4/7/2022 By: JC
This survey consists of:

DOUGLAS COUNTY OREGON

DATE 12-1-21

Map: _____

Narrative: _____

Corner Rpt: CS 67/51-36

Corner Designation

DOUGLAS COUNTY
SURVEYOR

Monument(s) Found: (Condition and Source)

___ Condition report

D.C. 56 BRASS CAP
WITH STEEL LATH 1 FT EAST

___ Not Found

Renewed

___ Unrecorded

Previous Renewals

___ Surveyed In

SHRUM 1962 C.S. 51/254-1

DC 20 1966 CS 54/7-17

BLM 1972-1975 Vol 37 PG. 15392

BLM 1981 Vol 45 Pg 17435-36

Smalley 2003 CS 65/48-16

DC 50 2007 CS 67/24-49

BLM 2009 Vol 57 P 22695

MONUMENT DETAIL

County Surveyors
OFFICE
T26S R3W
S26/S25
S35/S36
1964

Accessories Found

SHRUMS 62 now removed by Logging Not Fd.

SINGED 38" FIR S32°W 12.9 FT (REC 13.2 FT) HEALED BLAZE

BURNED 24" X 3 FT SAWED FIR STUMP N30W 21.1 FT

HEALED BLAZE NAIL LEFT SIDE CENTER

10" YEW N57°E 27.8 FT HEALED DOUBLE BLAZE

16" MAPLE S71°E 46.2 FT HEALED DOUBLE BLAZE

30" CEDAR N85°W 30.9 FT HEALED DOUBLE BLAZE

BT'S HAVE NAILS RIGHT SIDE CENTER

Monument Set (Procedure and Description)

MONUMENT DETAIL

New Accessories

Sketch of Monument, Accessories, and General Area

Location & Comments

See Attached Sheet.

Lat: 43° 16' 17.57" N
Long: 123° 00' 35.77" W
CS 67/51-27 3/13

Comp. Decline. 74 1/2° E
Agency DCSO
Party Chief S. F. AUSE
Note keeper
Witnesses J. L. OSUNO

REGISTERED
PROFESSIONAL
LAND SURVEYOR

Ronald A. Qumby

OREGON
JULY 14, 1978
RONALD A. QUMBY
1854


Expires: 12/31/2022

CS 67/51-36

See Cor
T 26 S 2 W
25-26-35-36



(NO SCALE)

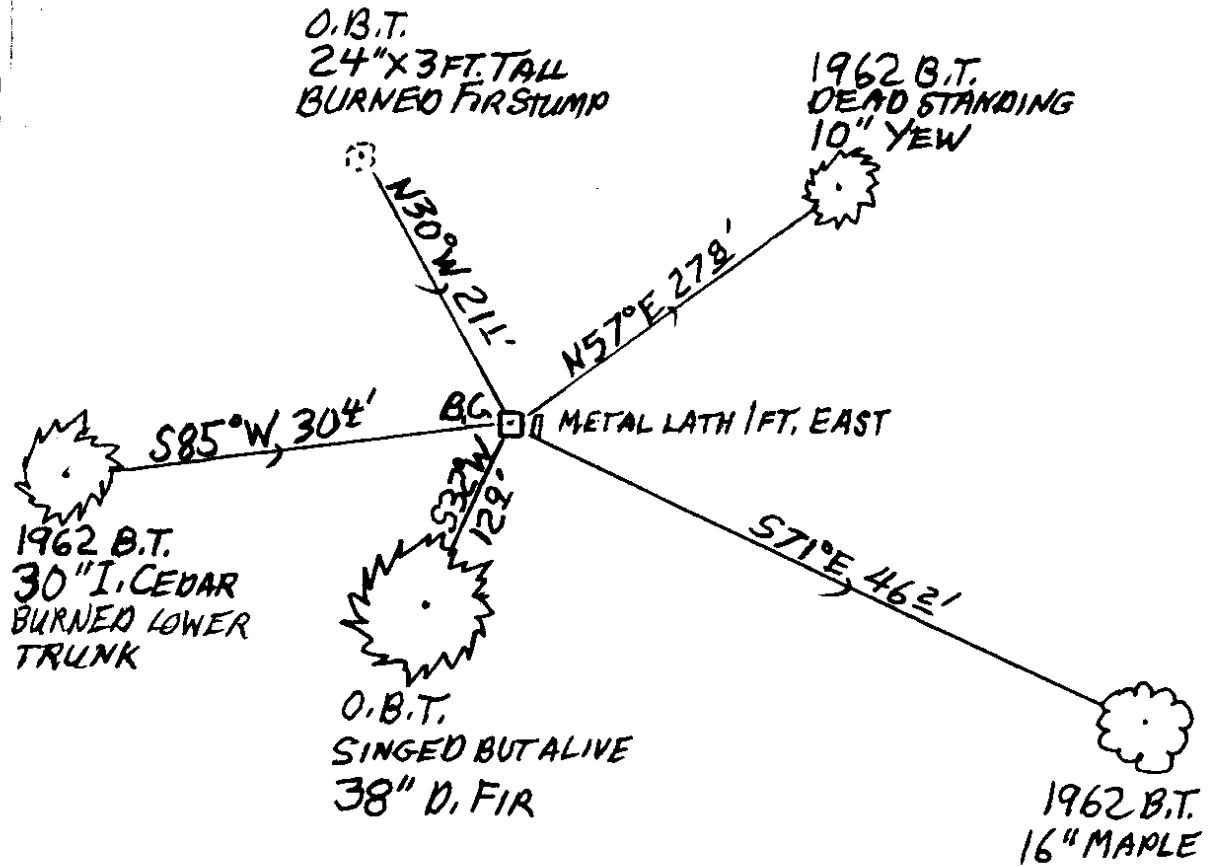

CS 67/51-36
3/4

TOWNSHIP 26 RANGE 03 POINT IDENTIFIER # 600200

12/17/21

PRIMARY CORNER DESCRIPTION Sec Cor for 25, 26, 35 and 36

Alias _____	Description _____
Alias _____	Description _____
Alias _____	Description _____
Alias _____	Description _____

Original - L.L. Williams and A.R. Flint, Under Contract #151 dated May 23, 1871 (DCSO records, Volume 10 Pages 4375-76)

Set post to cor. of secs. 25, 26, 35 and 36 from which,

- A fir 12" dia., bears N.50°E., 6 lks. dist.
- A Fir 12" dia., bears S.30°E., 11 lks. dist.
- A Fir 20" dia., bears S.35°W., 20 lks. dist.
- A Fir 20" dia., bears N.30°W., 32 lks. dist.

GLO survey by Samuel C. Flint, Under Contract #454 dated June 19, 1882 (DCSO records, Volume 10 Pages 4384-85)

Survey commenced July 6, 1882.

Found - Cedar post, 4 ft. long, 4" sq. firmly set in the ground, and marked T26S Sec. 25 on NE., R3W Sec. 36 on SE., S35 on SW and S26 on NW faces, with 1 notch on S & E edges.

- A Fir 12" dia., bears N.50°E., 6 lks. dist., mkd. T26S R3W S25 BT.
- A Fir 20" dia., bears N.30°W., 32 lks. dist. mkd. S 26 BT.
- A Fir 20" dia., bears S.35°W., 20 lks. dist., mkd. S 35 BT.
- A Fir 12" dia., bears S.30°E., 11 lks. dist. mkd. S 36 BT.

Thomas E. Shrum, Jr. For: U.S. Plywood - November 1962 - C.S. File 51/254-1

Found - 25" D.Fir S.46°W., 9.8 ft.
36" D.Fir stump N.23°W., 25.5 ft.

Set - 2½" Aluminum cap.

New BTs - 10" Maple S.74°E., 46.2 ft. mkd. S36 BT.
18" Cedar N.78½°W., 31.0 ft. mkd. S26 BT.
8" Yew N.52°E., 31.2 ft. mkd. S25 BT.

Doug. County Surveyors Office - Vernon Tracy; Mike Stone; Jack Heritage - Jan/Feb. 1966 - C.S. File 54/7-17

Found - Orig. 20" now 25" Fir S.35°W., 13.2 ft. Alive, prev. opened & shows "S" scribe.

(Cont. Next Page)

CS 67/51-38 416

TOWNSHIP 26 RANGE 03 POINT IDENTIFIER # 600200

PRIMARY CORNER DESCRIPTION Sec Cor for 25, 26, 35 and 36

Alias _____	Description _____
Alias _____	Description _____
Alias _____	Description _____
Alias _____	Description _____

Orig. 20" now 36" Fir stump N.30°W., 21.1 ft., find fragmentary bark scribe.
 ¾" I. Pipe & alum. cap, as recorded by Shrum which bears S.10°W., 4.3 ft. from true corner location. Believe Mr. Shrum had wrong notes in the field.

Set - Brass cap at cor. mkd. County Surveyors T26S R3W Office, 1966 S26|S25
S35|S36

New bearings and distances to Shrum's BTs:
 10" Maple S.70½°E., 46.3 ft. mkd. "S36 BT" & alum. tag "RE 4287".
 8" Yew N.57°E., 27.7 ft. mkd. "S25 BT" & alum. tag RE 4287.
 18" Cedar N.85°W., 30.0 ft. mkd. S26 BT" & Alum. tag RE 4287.
 Use orig. BT to SW.

Fd. OK, BLM resurvey by Berry; Popken; & Carlson, under Group #768 June 1972-April 1975 (DCSO records, Vol. 37 Pg. 15392)

Fd. OK, BLM resurvey by Wayne L. Rogers, Under Group #1058 June/Aug. 1981 (DCSO Records, Vol. 45 Pages 17435-36)

Fd. Ok by M. Smalley, Aug. 2003, C.S. File 65/48-16

Douglas Co. Surveyors Office - John Pike - Stephen J. Flause - 12/5/2007 - C.S. File 67/24-49

Found ok, 4 live BTs as per 1966 DCSO renewal. Shrum's ¾" IP/Alum cap not found.

BLM Dependent Resurvey by A Bert Skeesick, Cadastral Surveyor and Robert H Browning, Survey Tech, Under Group No. 2268, Surveyed July/Nov. 2009 - DCSO records Vol. 57 Page(s) 22695

*SHRUM'S 62 MON
REMOVED BY
LOGGING NOT FND.*

The cor. of secs. 25, 26, 35, & 36, monumented with an iron post, 1½" dia., firmly set, projecting 1½" above the ground, with brass cap (properly) mkd. *STEEL LATH 1 FT EAST* from which the remains of the original bearing trees

SINGEN 38" A fir, 35" dia., bears S.32°W., 13.2 ft., with a healed blaze. *NAIL LEFT SIDE CNTR. 129*

BURNED 24" X 3 FT A sawed fir stump, 43" dia., bears N.30°W., 21.1 ft., with a healed blaze.

and BTs mkd. by Shrum, in 1962

continued next page

*ALL OTHER B.T.S HAVE
RIGHT SIDE CENTER DISTANCE MEASUREMENT NAIL*

CS 67/51-36 5/6

TOWNSHIP 26 RANGE 03 POINT IDENTIFIER # 600200

PRIMARY CORNER DESCRIPTION Cor Secs 25, 26, 35, & 36

Alias _____	Description _____
Alias _____	Description _____
Alias _____	Description _____
Alias _____	Description _____

DEAD 10" A yew, 9" dia., bears N. 57° E., ²⁷⁸ 27.1 ft., with scribe marks S25 BT visible on a partially healed double blaze.

ALIVE 16" A maple, 15" dia., bears S. 71° E., 46.2 ft., with a healed double blaze.

ALIVE 30" A cedar, 28" dia., bears N. 85° W., 30.4 ft., with a healed double blaze.

BURNED LOWER TRUNK

The corner of sections 25, 26, 35, and 36:
 Latitude: 43°16'17.52"N. Longitude: 123°00'35.72"W.
 (NAD 1983 (CORS))

MM GPS DECLINATION 14 1/2° E
 TIME - 11:40
 H.I. - 2.00 M