

GOVERNMENT CORNER RESTORATION FORM

FILED

TOWNSHIP 255 RANGE 3W SEC. 7 PLSS # 200500

Date: 4/12/2022 By: X
This survey consists of:

DOUGLAS COUNTY OREGON

DATE 1-2022

Map: _____

Narrative: _____

Corner Rpt: CS 67/52-4

Corner Designation

SEC COR 7/8
18/17

DOUGLAS COUNTY
SURVEYOR

Monument(s) Found: (Condition and Source)

___ Condition report

___ Not Found

Renewed

___ Unrecorded

___ Surveyed In

BLM BRASS CAP projecting
12" ABOVE GROUND

Previous Renewals

BLM RESURVEY 1944 Vol 27 pg 11598

DCSO 1966 CS 54/27-37

DCSO 2006 CS 66/18-10

Hoffine 2011 M 162-21

MONUMENT DETAIL

T255 R3W

57/58

518/517

Accessories Found

1940 BT

41" X 35' BURNED-HOLLOW I. CEDAR N78°E

141.2 FT

1966 BT

14" X 3' SAWN BURNED FIR STUMP S70 1/4 W

29.8 FT (Rec 29.4) HEALED BLAZE

30" X 9' BROKEN BURNED FIR SNAG S43 1/2°E

57.3 FT (Rec 58.4 FT) FACE BURNED OFF.

28" X 6' SINGED SAWN FIR STUMP N78°E

12.3 FT HEALED BLAZE

11" X 4' SINGED WINDROVE STUMP N56°W

26.0 FT (Rec N56 3/4 W 26.8 FT)

C.S. File 67/52-4

Monument Set (Procedure and Description)

MONUMENT DETAIL

Blank lines for monument set procedure and description.

New Accessories

17" X 2 1/2' TALL SAWN D. FIR STUMP N35°W
41.4 FT 4" MAG NAIL TOP CENTER

Sketch of Monument, Accessories, and General Area

Location & Comments

LAT 43°24'26.05" N
LONG 123°05'21.12" W

MONUMENT IS APPROX 125 FT SELY FROM SHARP CORNER IN FOREST ACCESS ROAD

AREA BURNED 9-2020
Comp. Decline. 1 1/2' E
Agency DCSD
Party Chief SF/AUSE
Note keeper
Witnesses J LORSUNG

REGISTERED PROFESSIONAL LAND SURVEYOR

Ronald A. Quimby


OREGON JULY 14, 1978 RONALD A. QUIMBY 1654

Expires: 12/31/2022

CS 67/52-4 2/5

T25S, R03W 200500

1/6/2022

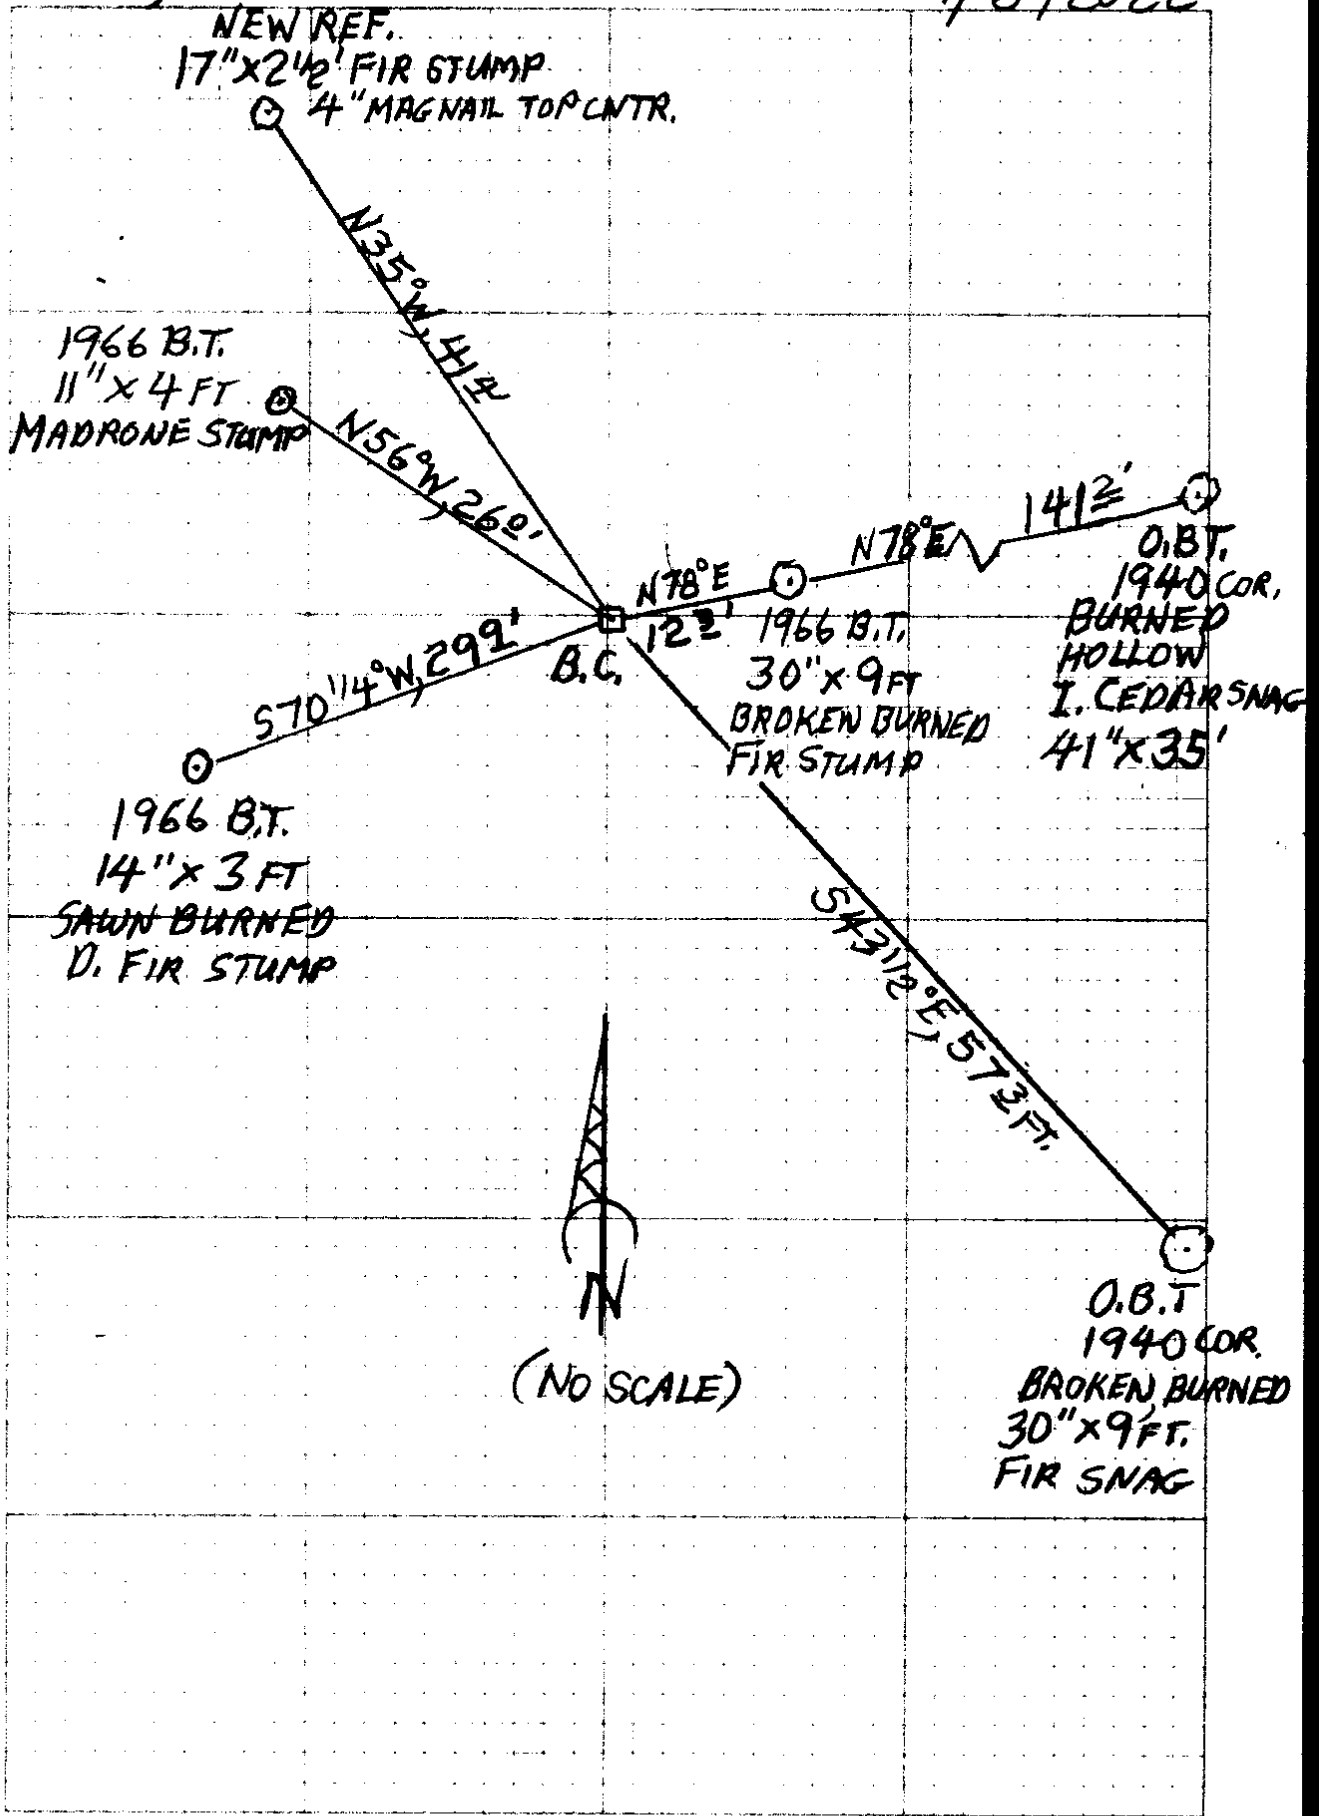

CS 67/52-4

PRIMARY CORNER DESCRIPTION Sec. Cor. for 7, 8, 17 and 18

Alias	Description	RENEWAL DATE
Alias	Description	1/6/22
Alias	Description	
Alias	Description	

30" now 42" Fir S.42°E., 57.4 ft. Alive, blaze pitched over.
 5" Madrone, now stub only, 6 ft. high S.41°W., 2.0'.
 24" now 28" Fir turned out, face down, N.61°W., 17.8 ft., blaze visible
 New BTs - 10" Laurel N.56°W., 26.6 ft. mkd. T25S R3W S7 CS BT.
 4" D.Fir S.71½°W., 29.6 ft. mkd. S18 CS BT.
 20" D.Fir N.78°E., 12.7 ft. mkd. T25S R3W S8 CS BT.
 Corner lies on top of rocky spur, course S.40°E.

Fd. Ok by Douglas Co. Surveyors Office - Randall W. Smith, Deputy - Stephen J. Flause - 11/2000 - C.S. File 66/18-10

Ken Hoffine - For: Lone Rock Timber Co. - 3/2011 - M162-21

★ SEE 1940 BT pg 1
 BURNED SAWN FIR STMP. 14" x 3' TALL
 BROKEN BURNED FIR STMP. 30" x 9' TALL
 SINGED, SAWN FIR STMP. 28" x 6' TALL
 SINGED, SAWN MADR STMP 11" x 4' TALL

Found - 1944 GLO gap MARKED AS BURNED PROT 12"
 13" D.Fir bears S. 70¼°W., 29.9 ft (record S.71½°W., 29.6 ft) healed face and tag. FH513
 41" D.Fir bears S.43¼°E. 57.3-58.4 ft (record S.42°E., 57.4 ft) healed face and tag. FACE BURNED OFF
 28" D.Fir bears N. 78°E., 12.3 ft (record N.78°E., 12.7 ft) healed face and tag. FHDB
 11" Madrone bears N.56°W., 26.8 ft (rec N.56°W., 26.6 ft) healed face and tag. FHDB
 Corner lies on top of rocky ridge top. N56°W, 26°FT

MM GPS 1/5/22
 TIME - 13:16
 H.I. - 2,000 M

NEW REF
 17" x 2½" TALL SAWN D. FIR STMP. 4" MAG NAIL TOP CNTR
 N35°W, 41½ FT

MONUMENT IS DOWNHILL FROM AND APPROX 125 FT. SE'LY FROM SHARP CORNER IN FOREST ACCESS RD.

PRIMARY CORNER DESCRIPTION Sec. Cor. for 7, 8, 17 and 18


Alias _____	Description _____
Alias _____	Description _____
Alias _____	Description _____
Alias _____	Description _____

Original, Laban H. Wheeler, Under Contract #467 dated April 7, 1883 (DCSO Records, Volume 9 Page 3722)

-
- Set Yew post, 4 ft. long, 4" sq., 24" in the ground for cor. to secs. 7, 8, 17 and 18, mkd. T25S S8 on NE., R3W S17 on SE., S18 on SW., and S7 on NW. faces, with 4 notches on S. and 5 notches on E. edges, from which
- A Laurel 4" dia., bears N.13°E., 26 lks. dist., mkd. T25S R3W S8 BT.
 - A Fir 6 dia., bears S.35°E., 30 lks. dist., mkd. T25S R3W S17 BT.
 - A Fir 24" dia., bears S.77°W., 21 lks. dist., mkd. T25S R3W S18 BT.
 - A Laurel 10" dia., bears N.18°W., 49 lks. dist., mkd. T25S R3W S7 BT.

GLO Dependent Resurvey by Norman D. Price, Under Special Instructions dated April, 5, 1940. (DCSO records, Volume 27 Page 11598)

Proportional measurement. Set an iron post, 3 ft. long, 2" dia., 28" in the ground, for cor. of secs. 7, 8, 17 and 18, with brass cap mkd.

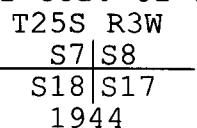

- from which
- An I.Cedar 36" dia., bears N.78°E., 214 lks. dist., mkd. T25S R3W S8 BT.
 - A Fir 30" dia., bears S.42°E., 87 lks. dist., mkd. T25S R3W S17 BT.
 - A Madrona 5" dia., bears S.41°W., 3 lks. dist., mkd. on bark T25S R3W S18 BT.
 - A Fir 24" dia., bears N.61°W., 27 lks. dist., mkd. T25S R3W S7 BT.

This sec. cor. is located on a spur, slopes SE.

Doug. County Surveyors Office - Vernon Tracy; Jack Heritage; Joe Brady - August 1966 - C.S. File 54/27-37



Found - GLO brass cap, 1944.

BURNER HOLLOW BEAR 36" now 50" I.Cedar N.78°E., 141.2 ft., shows scribe on unhealed blaze. N and NE side of tree badly burned. Tree alive.

41" x 35" MAG

(Cont. Next Page)