

GOVERNMENT CORNER RESTORATION FORM

FILED

TOWNSHIP 26S RANGE 3W SEC. 22 PLSS # 500340

Date: 4/12/2022 By: X  
This survey consists of:

DOUGLAS COUNTY OREGON

DATE 1-24-22

Map: \_\_\_\_\_

Narrative: \_\_\_\_\_  
Corner Rpt: CS 67/52-8

Corner Designation

DOUGLAS COUNTY  
SURVEYOR

1/4 COR 22/23

Monument(s) Found: (Condition and Source)

- Condition report
- Not Found
- Renewed
- Unrecorded
- Surveyed In

BLM BRASS CAP ON 2 1/2"

I. Pipe Proj 8"

Previous Renewals

BLM Resurvey 1972 - 1975

Vol 37 pg 15400

BLM Resurvey 2009 Vol

57 pg 22707

MONUMENT DETAIL

T26S R3W  
1/4  
522/523  
2009

Accessories Found

26" X 3 1/2 FT Badly burnt Cedar stump.  
S 38° E 28.4 FT No MARKS 4" MAG NAIL RT.  
Side Center

Broken 20" X 6' FIR SNAG S 88° W 36.3 FT  
Healed BLAZE 4" MAG NAIL RT Side Center

Burnt 8" Fir N 63 1/4° E 42.4 FT PART healed  
single BLAZE Illegible Scribes 4" MAG NAIL  
RT Side Center

C.S. File 67/52-8

1/4

Monument Set (Procedure and Description)

MONUMENT DETAIL

---



---



New Accessories

---



---



Sketch of Monument, Accessories, and General Area

Location & Comments

See sketch in file

Lat: 43° 17' 35.94" N

Long 123° 01' 46.99" W

AREA BURD  
9-2020

Comp. Decline. 14 1/2° E  
 Agency DCSO  
 Party Chief S. Flouse  
 Note keeper \_\_\_\_\_  
 Witnesses J LORSUNG

**REGISTERED  
 PROFESSIONAL  
 LAND SURVEYOR**

*Ronald A. Quimby*

**OREGON  
 JULY 14, 1978  
 RONALD A. QUIMBY  
 1854**


Expires: 12/31/2022

CS 67/52-8

2/4

T.26S, R.03W, 500340

01/24/22

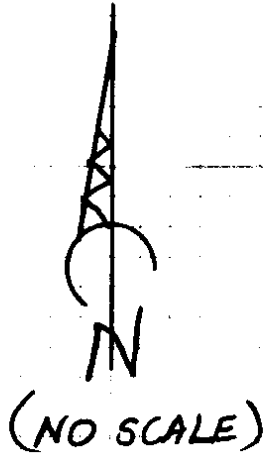

2009  
BLM BT  
8" FIR  
BURNED DEAD

N63 1/4° E, 42 1/4'

S88° W, 36 3/4'

BC MON.

1972-75  
BLM BT  
20" x 6'  
BROKEN AND BURNED  
FIR SNAG

S38° E, 28 1/4'

1972-75  
BLM BT  
26" x 3 1/2'  
SAWN VERY BURNED  
CEDAR STUMP

DECLINATION 14 1/2° E

CS 67/52-8

3/4

ENCLOSURE

