

TOWNSHIP 26S RANGE 34W SEC. 23 PLSS # 600340

Date: 4/13/2022 By: JC

This survey consists of:

DOUGLAS COUNTY OREGON

DATE 1-25-22

Map: _____

Narrative: _____

Corner Rpt: CS 67/52-10

Corner Designation

DOUGLAS COUNTY SURVEYOR

1/4 COR 23/24

Monument(s) Found: (Condition and Source)

___ Condition report

2 1/2" DCSD BRASS CAP

___ Not Found

Projecting 8" Above Ground

Renewed

properly marked

___ Unrecorded

Previous Renewals

___ Surveyed In

Weyerhaeuser Timber Co. 1960

CS 51/87-2

DCSD 1965 CS 54/7-35

BLM Resurvey 1972-1975

Vol 37 pgs 15394-95

DCSD 2007 CS 67/24-48

BLM Resurvey 2009 Vol 37 pg 22698

Edwards 2012 m 164-32

Accessories Found

MONUMENT DETAIL

County Surveyors
OFFICE

T26S R3W

1/4 S23/52A

1965

SAWN 26" X 2' Burnt Cedar Stump N76°E 44.9 FT

A down burnt 20" FIR S47°W 13.9 FT TO
Burned out Crown

23" D. Fir N 6°W 33.2 FT TO P.K. NAIL RT
Side Center (REC 32.7 FT) Partially Hatched
Single blaze

New Accessories

SAWED 16" X 1 FT TALL Hemlock Stump N 69° W
34.9 FT 4" MAG NAIL Top Center

24" D. Fir S 23° W 50.5 FT MAG NAIL RT.
Side Center Not Blazed or Scribed

A burnt 26" Hemlock N 80° W 30.0 FT TO
MAG NAIL RT Side Center No Blaze or
Scribe

Sketch of Monument, Accessories, and General Area

Location & Comments

See Attached Sheet

LAT 43° 17' 35.31" N

LONG 123° 00' 36.07" W

AREA BURNED
9-2020

Comp. Decline. 14 1/2° E
Agency DCSO
Party Chief S. Flouse
Note keeper
Witnesses J. LARSEN


REGISTERED
PROFESSIONAL
LAND SURVEYOR

Ronald A. Quimby

OREGON
JULY 14, 1978
RONALD A. QUIMBY
1854

Expires: 12/31/2022

CS 67152-10

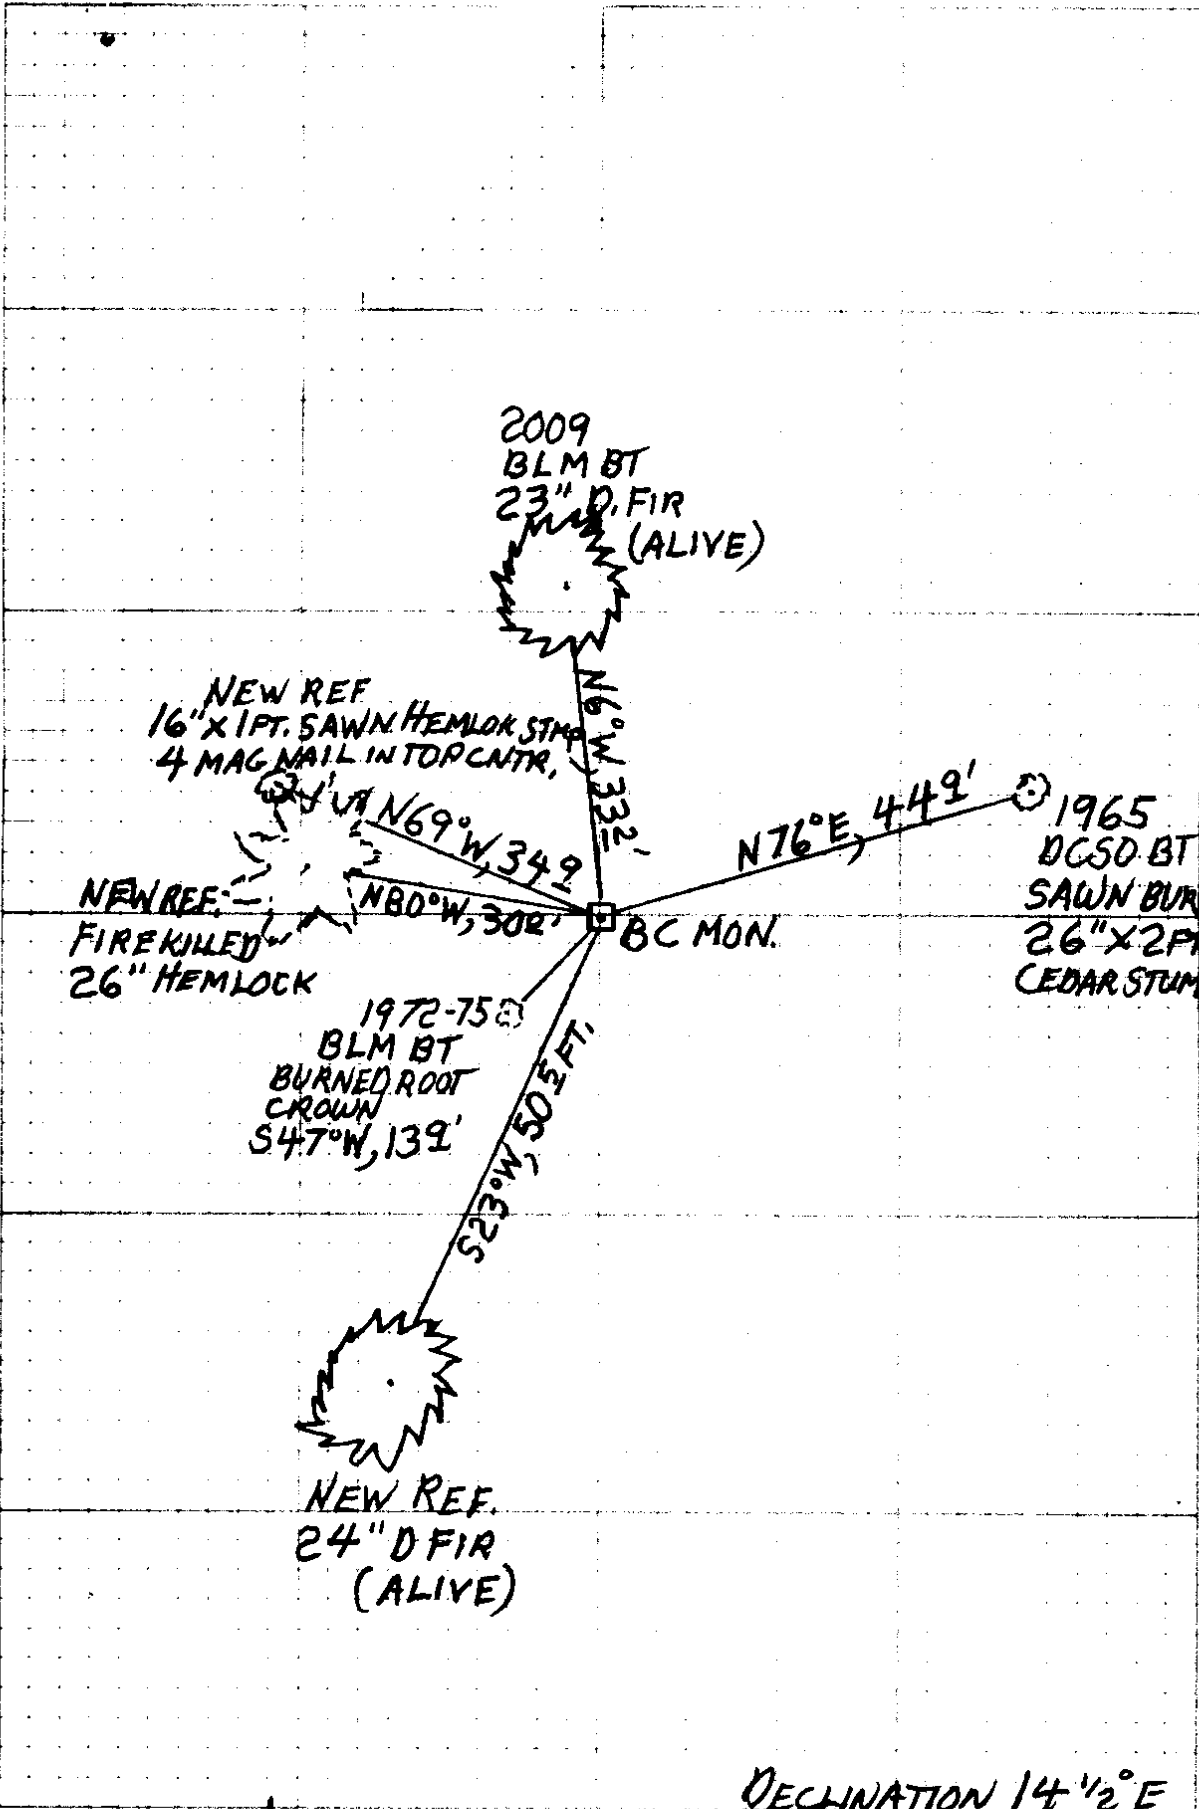

DECLINATION 14°12'E

CS 67/52-10
3/5

ENHORO
DATE: 10/10/10
PAGE: 1/1

1/25/22

TOWNSHIP 26 RANGE 03 POINT IDENTIFIER # 600340

PRIMARY CORNER DESCRIPTION 1/4 Cor Secs 23 and 24

Alias _____	Description _____
Alias _____	Description _____
Alias _____	Description _____
Alias _____	Description _____

2" dia., firmly set, protruding 10" above ground with brass cap properly marked.
 from which the remains of the original bearing tree
 A Cedar stump 35" dia., bears S.85°E., 25 lks. dist.
 with fragmentary scribe marks visible on decayed
 opened blaze.
 and a bearing tree marked by Tracy
 A Cedar 18" dia., bears N.76°E., 68 lks. dist.,
 with scribe marks 1/4 S24 CS BT visible on partially
 healed double blaze.
 and a new bearing tree
 A Fir 6" dia., bears S.47°W., 21 lks. dist. mkd.
 1/4 S23 BT.

Douglas Co. Surveyors Office - John Pike - Stephen J. Flause - 12/4/2007 - C.S. File 67/24-48

Found ok; orig. cedar stump, 1065 I.Cedar renewal tree as per 1972 BLM report.

BLM Dependent Resurvey by A Bert Skeesick, Cadastral Surveyor and Robert M Browning, Survey Tech, Under Group No. 2268, Surveyed July/Nov. 2009 - DCSO records Vol. 57 Page(s) 22698

The 1/4 sec. cor. of secs. 23 and 24, monumented with an iron post, 1 1/4" dia., firmly set, projecting 8" above the ground, with brass cap (properly) mkd. 2 1/2" BC
 from which the remains of an original bearing tree
 GONE A decayed cedar stump, 31" dia., bears S.85°E., 16.5 ft., with axe marks visible.
 and the remains of a BT mkd. by Lester E. Calder, in 1960
 GONE A sawed, decayed fir stump, 48" dia., bears N.81 1/4°W., ft., with no marks visible.
 and a bearing tree mkd. by Tracy, in 1965
 SAWN BURNED A cedar, 29" dia., bears N.76°E., 44 1/2 ft., with a 26" x 2 1/2" healed blaze.
 and the remains of a BT mkd. by Berry Popken, and Carlson
 BURNED A fir snag, 20" dia., bears S. 27°W., 18.9 ft., with a healed blaze. TO BURNED ROOT CROWN
 and a new bearing tree
 ALIVE 23" A fir, 17" dia., bears N.76°W., 32.7 ft., mkd. 1/4 S23 BT. 33 1/2 TO RSC NAIL
 D. FIR PARTIALLY HEALED SINGLE BLZ (PHSB)

MM GPS TIME - 9:20 H.I. - 5,000 FT.

CS 67/52-10 4/5

Fd as per 2009 BLM resurvey by D. Edwards, 10/2012 - M164-32

NEW REFS

SAWN 16" x 1 FT TALL HEMLOCK STMP 4" MAG NAIL TOP CNTR. N69°W, 34 1/2 FT.

ALIVE 24" D. FIR NOT BLZD NOT SCRBD. S23°W, 50 1/2 FT. RSC NAIL

FIRE KILLED 26" HEMLOCK; NO BLZ NO, SCRBD, N80°W 30 1/2 RSC NAIL

DECLINATION 14 1/2°E

TOWNSHIP 26 RANGE 03 POINT IDENTIFIER # 600340

PRIMARY CORNER DESCRIPTION 1/4 Cor. for Secs 23 and 24

Alias _____ Description _____
Alias _____ Description _____
Alias _____ Description _____
Alias _____ Description _____

Original - Samuel C. Flint, Under Contract #454, dated June 19, 1882 (DCSO records, Volume 10 Page 4389)

Set Cedar post, 3 ft. long, 3" sq., firmly in the ground marked on E and W faces $\frac{1}{4}$ S; from which

A Fir 36" dia., bears N.60°W., 32 lks. dist., mkd. $\frac{1}{4}$ S BT.

A Cedar 14" dia., bears S.85°E., 25 lks. dist., mkd. $\frac{1}{4}$ S BT.

Weyerhaeuser Timber Company & Youngs Bay Lumber by: Lester E. Calder, Wit: Glen McChesney; Tom Shrum; Don Wright April 1960 - C.S. File 51/87-2

Found - No trace, 36" Fir N.60°W., 32 lks., 14" Cedar S.85°E., 25 lks., faint scribe marks.

Found stake found by 1950-51 survey. Referenced by G. Mcchesney, (plates and "W" nails only)

42" Fir stump N.83°W., 37.7 ft.

36" I.Cedar S.85°E., 15.4 ft. (Orig.)

Doug. County Surveyors Office - Vernon Tracy; Mike Darby; Terry Connell Wit: Glen McChesney, Weyerhaeuser Co. - June 8, 1965 - C.S. File 54/7-35

Found - 14" now 37" I.Cedar stump S.85°E., 16.5 ft., chopped out, face rotted, very faint scribe visible. Stump 6.0 ft. high.

42" Fir stump N.83°W., 37.7 ft. to "W" nail, no scribe.

Set Brass cap at cor. mkd: County Surveyors Office, 1965
T26S R3W $\frac{1}{4}$ S23|S34

New BT - 14" I.Cedar N.77°E., 45.1 ft. mkd. $\frac{1}{4}$ S24 CS BT.
No other trees available.

This corner lies on top of rounded hill, rolling off to North.

Bureau of Land Management resurvey by Popken; Berry; and Carlson Under Group #768 - Survey June 1972-April 1975 (DCSO records, Vol. 37 Pages 15394-95)

Found the $\frac{1}{4}$ sec. cor. of secs. 23 and 24, perpetuated and recorded by Vernon Tracy in 1965, monumented with and iron post, (Cont. Next Page)

CS 67/52-10
6/5