

GOVERNMENT CORNER RESTORATION FORM

FILED

TOWNSHIP 265 RANGE 2W SEC. 3 PLSS # 400700

Date: 4/14/2022 By: SC
This survey consists of:

DOUGLAS COUNTY OREGON

DATE 2-3-21

Map: _____

Narrative: _____

Corner Rpt: CS 67/52-16

Corner Designation

DOUGLAS COUNTY
SURVEYOR

SEC COR 34
4/3

Monument(s) Found: (Condition and Source)

___ Condition report

___ Not Found

Renewed

___ Unrecorded

___ Surveyed In

1959 BLM BRASS CAP
Proj. 4"

Previous Renewals

GLD Collier 1913 Vol 10 pgs
4270 - 4274

BLM Resurvey 1959 Vol 30 pg
12720

BLM 1972-1975 Vol 36 pgs 15102-03

Geisler 1987 CS 63/60-3

BLM 1995-1998 Vol 53 p 20453

Smalley 2003 CS 65/48-8

Accessories Found

Quimby 10/2020 CS 65/106-61

MONUMENT DETAIL

T25S R2W

534
54/53

T26S R2W

1959

- 24" X 1 FT Burnt Stump S14°W 35.2 FT
- 15" X 10' Broken burnt snag S57 1/2° E 13.0 FT
(Rec S55° E 13.2 FT) PK Nail Right Side Center
- 11" X by 6' burnt FIR snag N12°W 9.6 FT PK
Nail Right Side Center
- 4 5/8" X 30" Iron Rods with yellow Plastic
CAP STAMPED re Engineering N34° E 6.9 FT
S76° E 7.9 FT, S30° W 5.7 FT AND N23° W
5.0 FT All with Post along side
- 15" Burnt & Dead D. FIR S27° W 155.0 FT to
PK Right Side Center No BLAZE No
RECORD HAS BT TAG WITH BEARING TO
CORNER

Monument Set (Procedure and Description)

MONUMENT DETAIL

Blank lines for Monument Set description.

New Accessories

Blank lines for New Accessories description.

Sketch of Monument, Accessories, and General Area

Location & Comments

See sketch on attached sheet

AREA BURNED
9/2020

Lat: 43° 20' 31.62" N

Long: 122° 55' 53.78" W

Comp. Decline. 14 1/2° E
Agency DCSO
Party Chief J. Flaise
Note keeper
Witnesses J. LORSUM

REGISTERED
PROFESSIONAL
LAND SURVEYOR


Ronald A. Qumby
OREGON
JULY 14, 1978
RONALD A. QUMBY
1854

CS 67/52-16 2/6

Expires: 12/31/2022

T26S, R02W, 400700

2/3/22

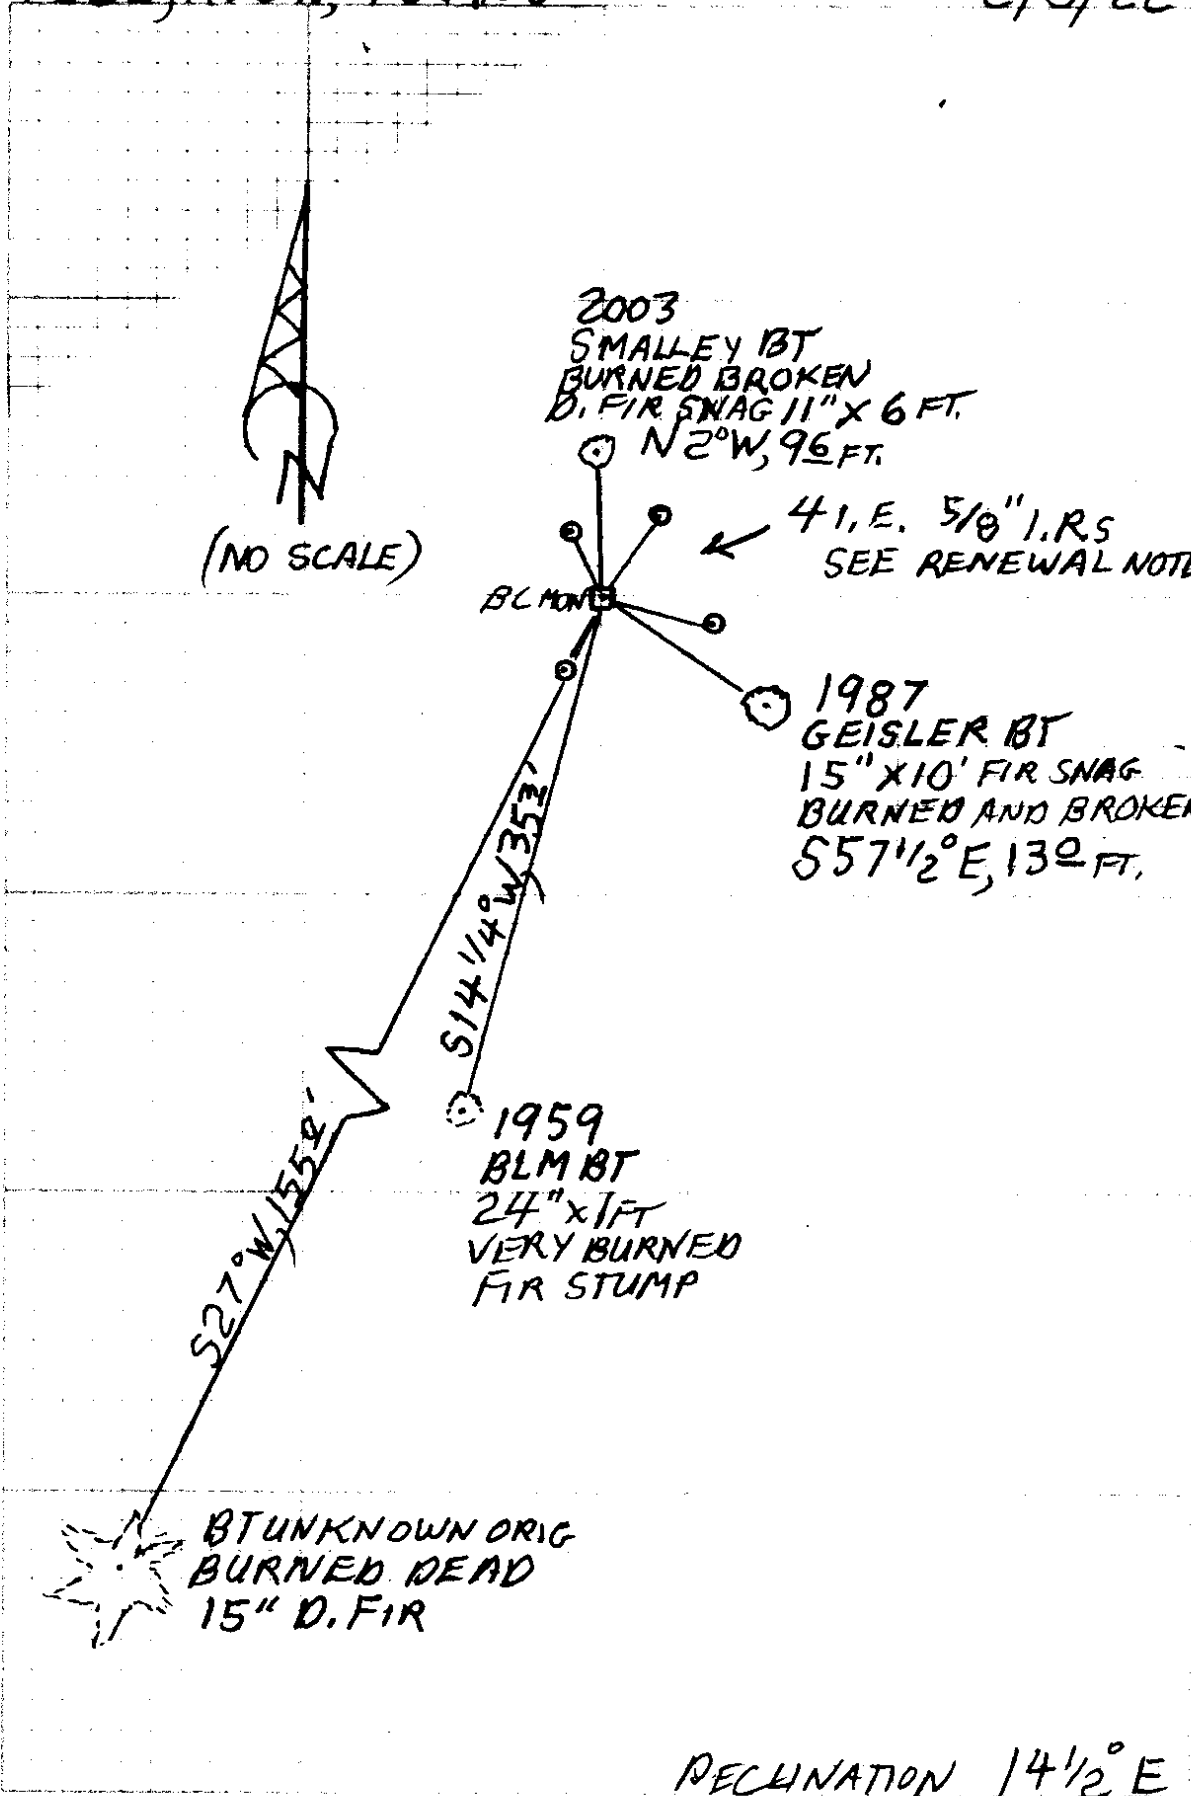

(NO SCALE)

2003
SMALLEY BT
BURNED BROKEN
D. FIR SNAG 11" X 6 FT.
N 2° W, 96 FT.

41, E. 5/8" I.R.S
SEE RENEWAL NOTES

1987
GEISLER BT
15" X 10' FIR SNAG
BURNED AND BROKEN
S 57 1/2° E, 130 FT.

1959
BLM BT
24" X 1 FT
VERY BURNED
FIR STUMP

S 27° W, 155 FT

S 14 1/4° W, 353 FT

BT UNKNOWN ORIG
BURNED DEAD
15" D. FIR

DECLINATION 14 1/2° E

CS 67/52-16 3/6

26 - 2 - 400700

TOWNSHIP 25 RANGE 02 POINT IDENTIFIER # 408100 2/3/22

PRIMARY CORNER DESCRIPTION C C for Secs. 3 & 4 only, T26-2

Alias _____	Description _____
Alias _____	Description _____
Alias _____	Description _____
Alias _____	Description _____

Mark Smalley - For: Roseburg Resources - June 2003 - C.S. File 65/48-8

Found - BLM steel pipe & brass cap (properly mkd) & stone.
 50" Fir S.16 $\frac{3}{4}$ °E. 337.9' chopped out - rotting (Orig)
 20" Fir S.23 $\frac{1}{4}$ °W., 263.3' gone (no stump)
 24" rotten Fir stump S.14 $\frac{1}{4}$ °W., 35.3'
 19" Fir S.55°E., 13.2', scribe visible.

New - 25" Fir S.16°E., 39.7' scribed "S3 BT"
 13" Fir N.2°W., 9.6' scribed "CC BT"

Ron Quimby - Crew: N. Fromdahl, L. Heddens & J. Ogden - 10/2020 - C.S. File 65/106-61

Found - 1959 BLM brass cap ^{PROV. 4"}
 1 FT. x 4" burnt stump S.14 $\frac{1}{4}$ °W., 35.3'
 15" x 10 FT D. Fir 20" burnt snag S.55°E., 13.2' burnt scar 557 $\frac{1}{2}$ °E, 130° RSC PK NAIL
 VERY BRND 25" burnt down fir S.16°E., 39.7' healed scar - NOT MEAS. TOO BURNED
 11" x 6 FT D. Fir 14" burnt snag N.2°W., 9.6' burnt scar. DIST. TO RSC PK NAIL

New - 5/8" x 30" I. Rods with yellow plastic cap stamped "ie ENGINEERING" with post alongside:
 N. 4°E., 6.9' S. 76°E., 7.9'
 S. 30°W., 5.7' N. 20°W., 5.0'

Note - Compass decl. 15 $\frac{1}{2}$ °E.
 Area badly burnt 9/2020

BROKEN BURNED SNAG

FNB - 15" DEAD BURNED D. FIR NO BLZ VIZ, S27°W 1550 TO RSC PK
 NO RECORD BUT HAS BURNED
 BT TAG WITH BEARING TO COR.

MM GPS
 TIME - 12:35
 H.I. - 2.000M

CS 67/52-14 4/6

PRIMARY CORNER DESCRIPTION C C for Secs. 3 & 4 only, T26-2

Alias _____ Description _____
 Alias _____ Description _____
 Alias _____ Description _____
 Alias _____ Description _____

GLO survey by John A. McQuinn, Deputy Surveyor, under Contract #466, dated April 5, 1883 (DCSO records Vol. 9 Page(s) 3581)

 Set Cedar post 4 ft. long, 4" sq., 24" in the ground for cor. to secs. 3, 4, 33 and 34, mkd. T25S S34 on NE.; R2W S3 on SE.; T26S S4 on SW.; and S33 on NW. faces, with 3 notches on E. and W. edges. Raised mound of stone 2 ft. high, 4½ ft. base around post. No live trees near.

GLO survey by C.M. Collier, Deputy Surveyor, under Instructions dated May/Sept. 1913 - (DCSO records Vol. 10 Page(s) 4270 and 4274)

 (Page 4270)
 Search for cor. of secs. 3 and 4, but find no trace of the markings. Set temp. cor. for sec. 3 and 4.

(Page 4274)
 Set a Fir post 3 ft. long, 4" sq., 24" in the ground for cor. of secs. 3 and 4, marked T26S S3 on SE.; and R2W S4 on SW. faces, with 3 notches on E. and W. edges; from which

A Fir 18" dia., bears S.12°E., 5.12 chs. dist. mkd. T26S R2W S3 BT.

A Fir 10" dia., bears S.22°W., 399 lks. dist. mkd. T26S R2W S4 BT.

(Notes of original cor. here are probably in error when the call for mound of stone, as there are no stones on this plateau.

BLM Resurvey by Irving Zirpel & Wm. Glenn Under Group #404, Surveyed May/Oct. 1959 - (DCSO records Vol. 30 Page(s) 12720)

 The cor. of secs. 3 and 4 only, perpetuated with an unmarked basalt stone, 14x10x8 ins., firmly set, at record distance from each of the bearing trees mkd. by Collier in 1913:

A Fir 40" dia., bears S.16 3/4°E., 512 lks. dist. with scribe marks S3 B visible on an opened blaze. (Rec. brg. S.12°E.)

A down and rotted Fir 14" dia., bears S.23¼°W., 399 lks. dist., with scribe marks BT and other illegible marks visible on opened blaze. (Rec. brg. S.22°W.)

At the corner point

Set an iron post, 28" long, 2 1/2" dia., 26" in the ground, with brass cap mkd:

T 25 S R 2 W
 S 34
 S 4 | S 3
 T 26 S R 2 W

(Cont. Next Page)

1959

PRIMARY CORNER DESCRIPTION C C for Secs. 3 & 4 only, T26-2

Alias _____	Description _____
Alias _____	Description _____
Alias _____	Description _____
Alias _____	Description _____

from which
 A Fir 14" dia., bears S.14¼°W., 53½ lks. dist. mkd. T26S
 R2W S4 BT.
 Deposit the basalt stone alongside the iron post.


Fd. and used in BLM Resurvey by Daniel Berry; Harvey Wofford;
 G. Steven Popken, Cadastral Surveyors, under Group #'s 786,
 848 and 854. And Glenn S. Baughman, L.S. #536, under Contract
 #52500-CT5-1116, Surveyed July 1972/Oct. 1975 - (DCSO records
 Vol. 36 Page(s) 15102-03)

Survey by Ronald Geisler - For: Champion International - June
 30, 1987 - C.S. File 63/60-3

 Found - 1959 BLM 3½" brass cap on a 2½" iron pipe, extends
 4" above ground. Also found basalt stone
 alongside monument.
 24" D.Fir stump bears S.14¼°W., 35.3 ft. Face cut
 off. (1959 BT)
 New BT - 15" D.Fir bears S.55°E., 13.2 ft. scribed T26S R2W
 S3 CC BT.

BLM dependent resurvey by Bryan S. Seibold, Cadastral
 Surveyor and Robert H. Browning, Survey Technician, under
 Group #1754, surveyed May 1995 - July 1998 - (DCSO records
 Vol. 53 Page(s) 20453)

 The cor. of secs. 3 and 4 only, T. 26 S., R. 2 W., monumented
 with an iron post, 2½" diam., firmly set, projecting 5" above
 ground, with brass cap mkd. T 25 S R 2 W

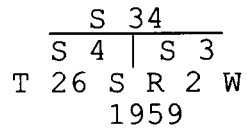

from which the remains of an original bearing tree
 A fir, 49" diam., bears S.16 3/4°E., 512 lks., with no
 mks. visible on opened blaze.
 and the remains of a bearing tree mkd. by Zirpel and Glenn
 A sawed fir stump, 25" diam., bears S.14¼°W., 53½ lks.,
 with no mks. visible.
 and a bearing tree mkd. by Geisler, in 1987
 A fir, 18" diam., bears S.57½°E., 20 lks., with
 fragmentary scribe mks. visible on partially healed
 double blazes.
 and a new bearing tree
 A fir, 3" diam., bears S. 27° W., 235 lks., mkd. X BT

continued next page

275
6
1010

CS 6275244 2
616