

GOVERNMENT CORNER RESTORATION FORM

FILED

TOWNSHIP 255 RANGE ZW SEC. 30 PLSS # 100240

Date: 4/14/2022 By: SC

This survey consists of:

DOUGLAS COUNTY OREGON

DATE 2-17-22

Map: _____

Narrative: _____

Corner Rpt: CS 67/52-19

Corner Designation

W 1/4 S30 only

DOUGLAS COUNTY
SURVEYOR

Monument(s) Found: (Condition and Source)

___ Condition report

___ Not Found

Renewed

___ Unrecorded

___ Surveyed In

2 1/2" GLD BRASS CAP OP 3/4"

ID I.P. Projects 8"

Previous Renewals

GLD RESURVEY 1940 Vol 27

Pg 11511

DCSD 1966 CS 54/27-169

MONUMENT DETAIL

1/4 S30

1943

Accessories Found

BURNT 20" X 7" FIR SQA9 (REC 57") S46°E 101.3 FT
ALL MARKS GONE (REC S43°E 104.9 FT) 1940

BURNT 32" S. PINE S 13 1/2° E 73.3 FT (REC S 12° E
75.5 FT) NO VISIBLE MARKS 1946

C.S. File 67/52-19

New Accessories

12" Burnt ^{Dead} D. Fir N 50° E 9.2 FT 3 1/2" P.K Nail
RT. Side Center

18" Burnt ^{Dead} D. Fir S 48 1/2° E 14.3 FT 3 1/2" P.K Nail
RT Side Center

12" Burnt ^{Dead} D. Fir S 22° E 13.0 FT 3 1/2" P.K Nail
RT Side Center

Trees Not Blazed or Scribed

Sketch of Monument, Accessories, and General Area Location & Comments

See Attached sheet

AREA BURNED
9/2020

Lat: 43° 21' 57.51" N

Long: 122° 59' 23.75" W

Comp. Decline. 14 1/2° E
Agency DCSO
Party Chief S. Flause
Note keeper
Witnesses J. LORSUNG

REGISTERED
PROFESSIONAL
LAND SURVEYOR

Arnell A. Bailey


OREGON
JULY 14, 1978
RONALD A. QUMBY
1854

Expires: 12/31/2022

CS 67/52-19

T255, R02W, 100240

2/17/22

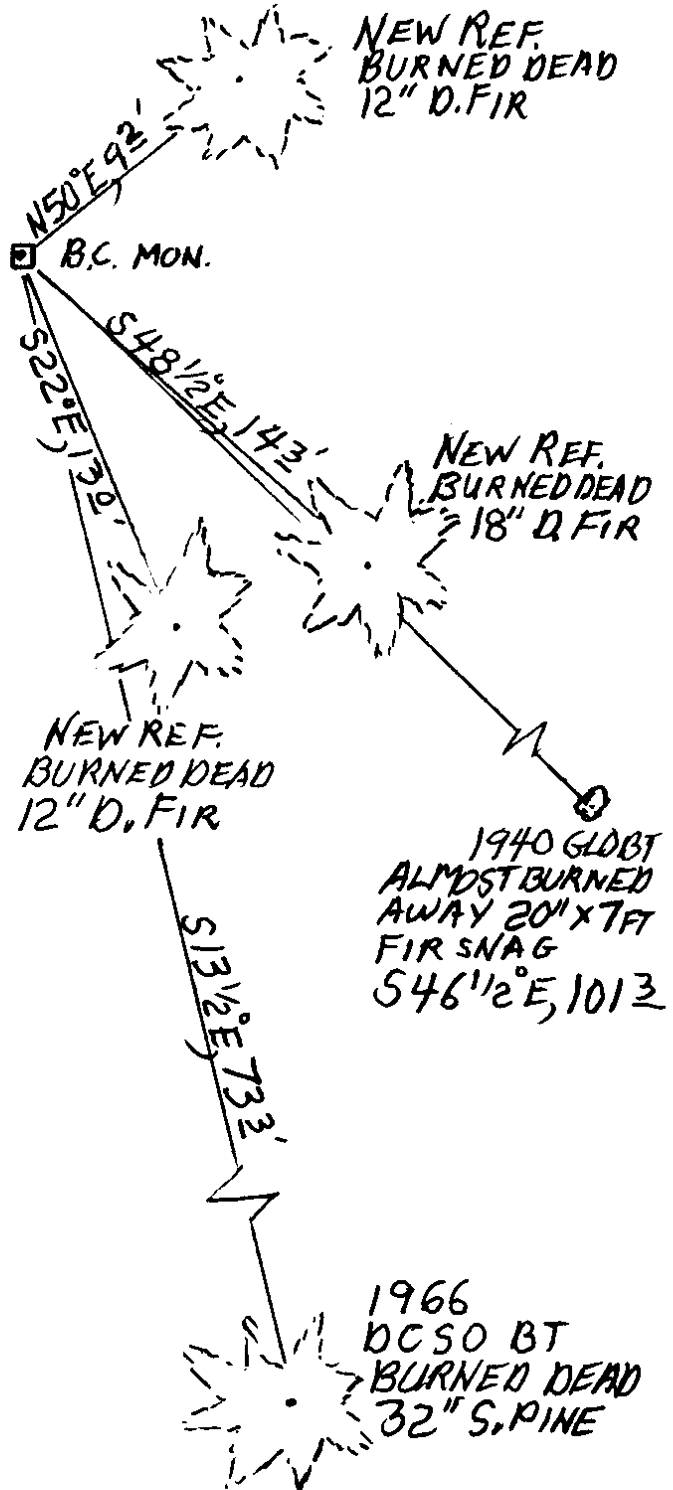

DECLINATION 14 1/2° E

CS 67/52-19

314

MM GPS 2/16/22
 TIME 11:30
 H.I. - 2.000M
 TOWNSHIP 25 RANGE 02 POINT IDENTIFIER # 10024 2/17/22 RENEWAL

PRIMARY CORNER DESCRIPTION W 1/4 Cor. for Sec. 30 only

Alias _____ Description _____
 Alias _____ Description _____
 Alias _____ Description _____
 Alias _____ Description _____

Note: Original 1/4 Corner common for Secs. 30, T25-2 and Sec. 25, T25-3 set by Laban Wheeler, Contract #467 dated April 7, 1883 (DCSO records, Volume 9 Page 3586)

GLO Dependent Resurvey by Norman D. Price, Under Special Instructions dated April 5, 1940 (DCSO records, Volume 27 Page 11511)

 Mid-point of the W. bdy. of sec. 30. Set an iron post, 3 ft. long, 1" dia., 28" in the ground, for 1/4 sec. cor. of sec. 30 only, with brass cap mkd. 1/4 30

1943 **87 78** from which
 A Fir 24" dia. bears N.49°E., 133 lks. dist., mkd. 1/4 S 30 BT.
 A Fir 30" dia. bears S.43°E., 159 lks. dist., mkd. 1/4 S 30 BT.

Doug. Co. Surveyors Office - Ray Tracy; Joe Brady; Jack Heritage - June 1966 - C.S. File 54/27-169

2 1/2" BCON 3/4" IRIP
 PROTS 8"

Found - 1943 GLO brass cap mkd. **54 1/2 E 101 3**
 NO EVID, 24" Fir, down and out of place, N.49°E., 87.8 ft., scribe visible on burned face.

ALMOST BURNED 30" now 57" Fir S.43°E., 104.9 ft., face burned, scribe barely visible, Rescribe "1/4 S CS". Tree is almost dead. **GOING**

NO EVID. - 12" D. Fir N.44°E., 87.7 ft. mkd. 1/4 S30 CS BT.

DEAD BURNED 32" 4" S. Pine S. 12°E., 75.5 ft. mkd. "1/4 S BT" (only) **BZ NOT VIS.**

This corner lies on NW edge of small clearing approx. 150x300 ft. on south slope.

S 13 1/2 E, 73 3

NEW REFS

12" BURNED DEAD D. FIR 3 1/2" PK RSC NO BLZ OR SCRIB N 50° E, 9 1/2 FT.

18" BURNED DEAD D. FIR 3 1/2" PK RSC NO BLZ OR SCRIB S 48 1/2° E, 14 1/2 FT.

12" BURNED DEAD D. FIR " " S 22° E, 13 0 FT.

DECLINATION 14 1/2° E

CS 67/52-19 4/4